


0055-225



0055-225

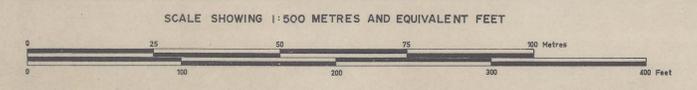

ELECTROLYTIC ZINC COMPANY OF AUSTRALASIA LIMITED  
WEST COAST MINES, T.A.S.

SURVEY BY		SCALE	1 : 500
DRAWN BY		DATE	1973
TRACED BY	P.J. Lowe	REFERENCE	

HERCULES MINE  
LONGITUDINAL PROJECTION 78/58

BROUGHT TO DATE 31-12-77  
MINE MANAGER *[Signature]*  
MINE SURVEYOR *[Signature]*

MICROFILMED

DRAWING N°:  
DEPARTMENT OF MINES