


0055-227



BROUGHT TO DATE 31-12-77  
 MINE MANAGER *[Signature]*  
 MINE SURVEYOR *[Signature]*

**MICROFILMED**

78156

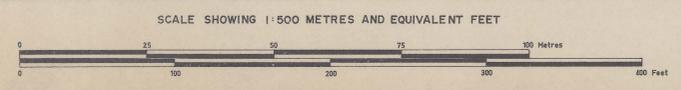

**ELECTROLYTIC ZINC COMPANY OF AUSTRALASIA LIMITED**  
 WEST COAST MINES, T.A.S.

SURVEY BY		SCALE	1:500 METRES
DRAWN BY		DATE	1973
TRACED BY	P. J. Lowe	REFERENCE	

HERCULES MINE  
 N° 6 LEVEL

DRAWING N°:  
 DEPARTMENT OF MINES  
 PLAN