



0055-228

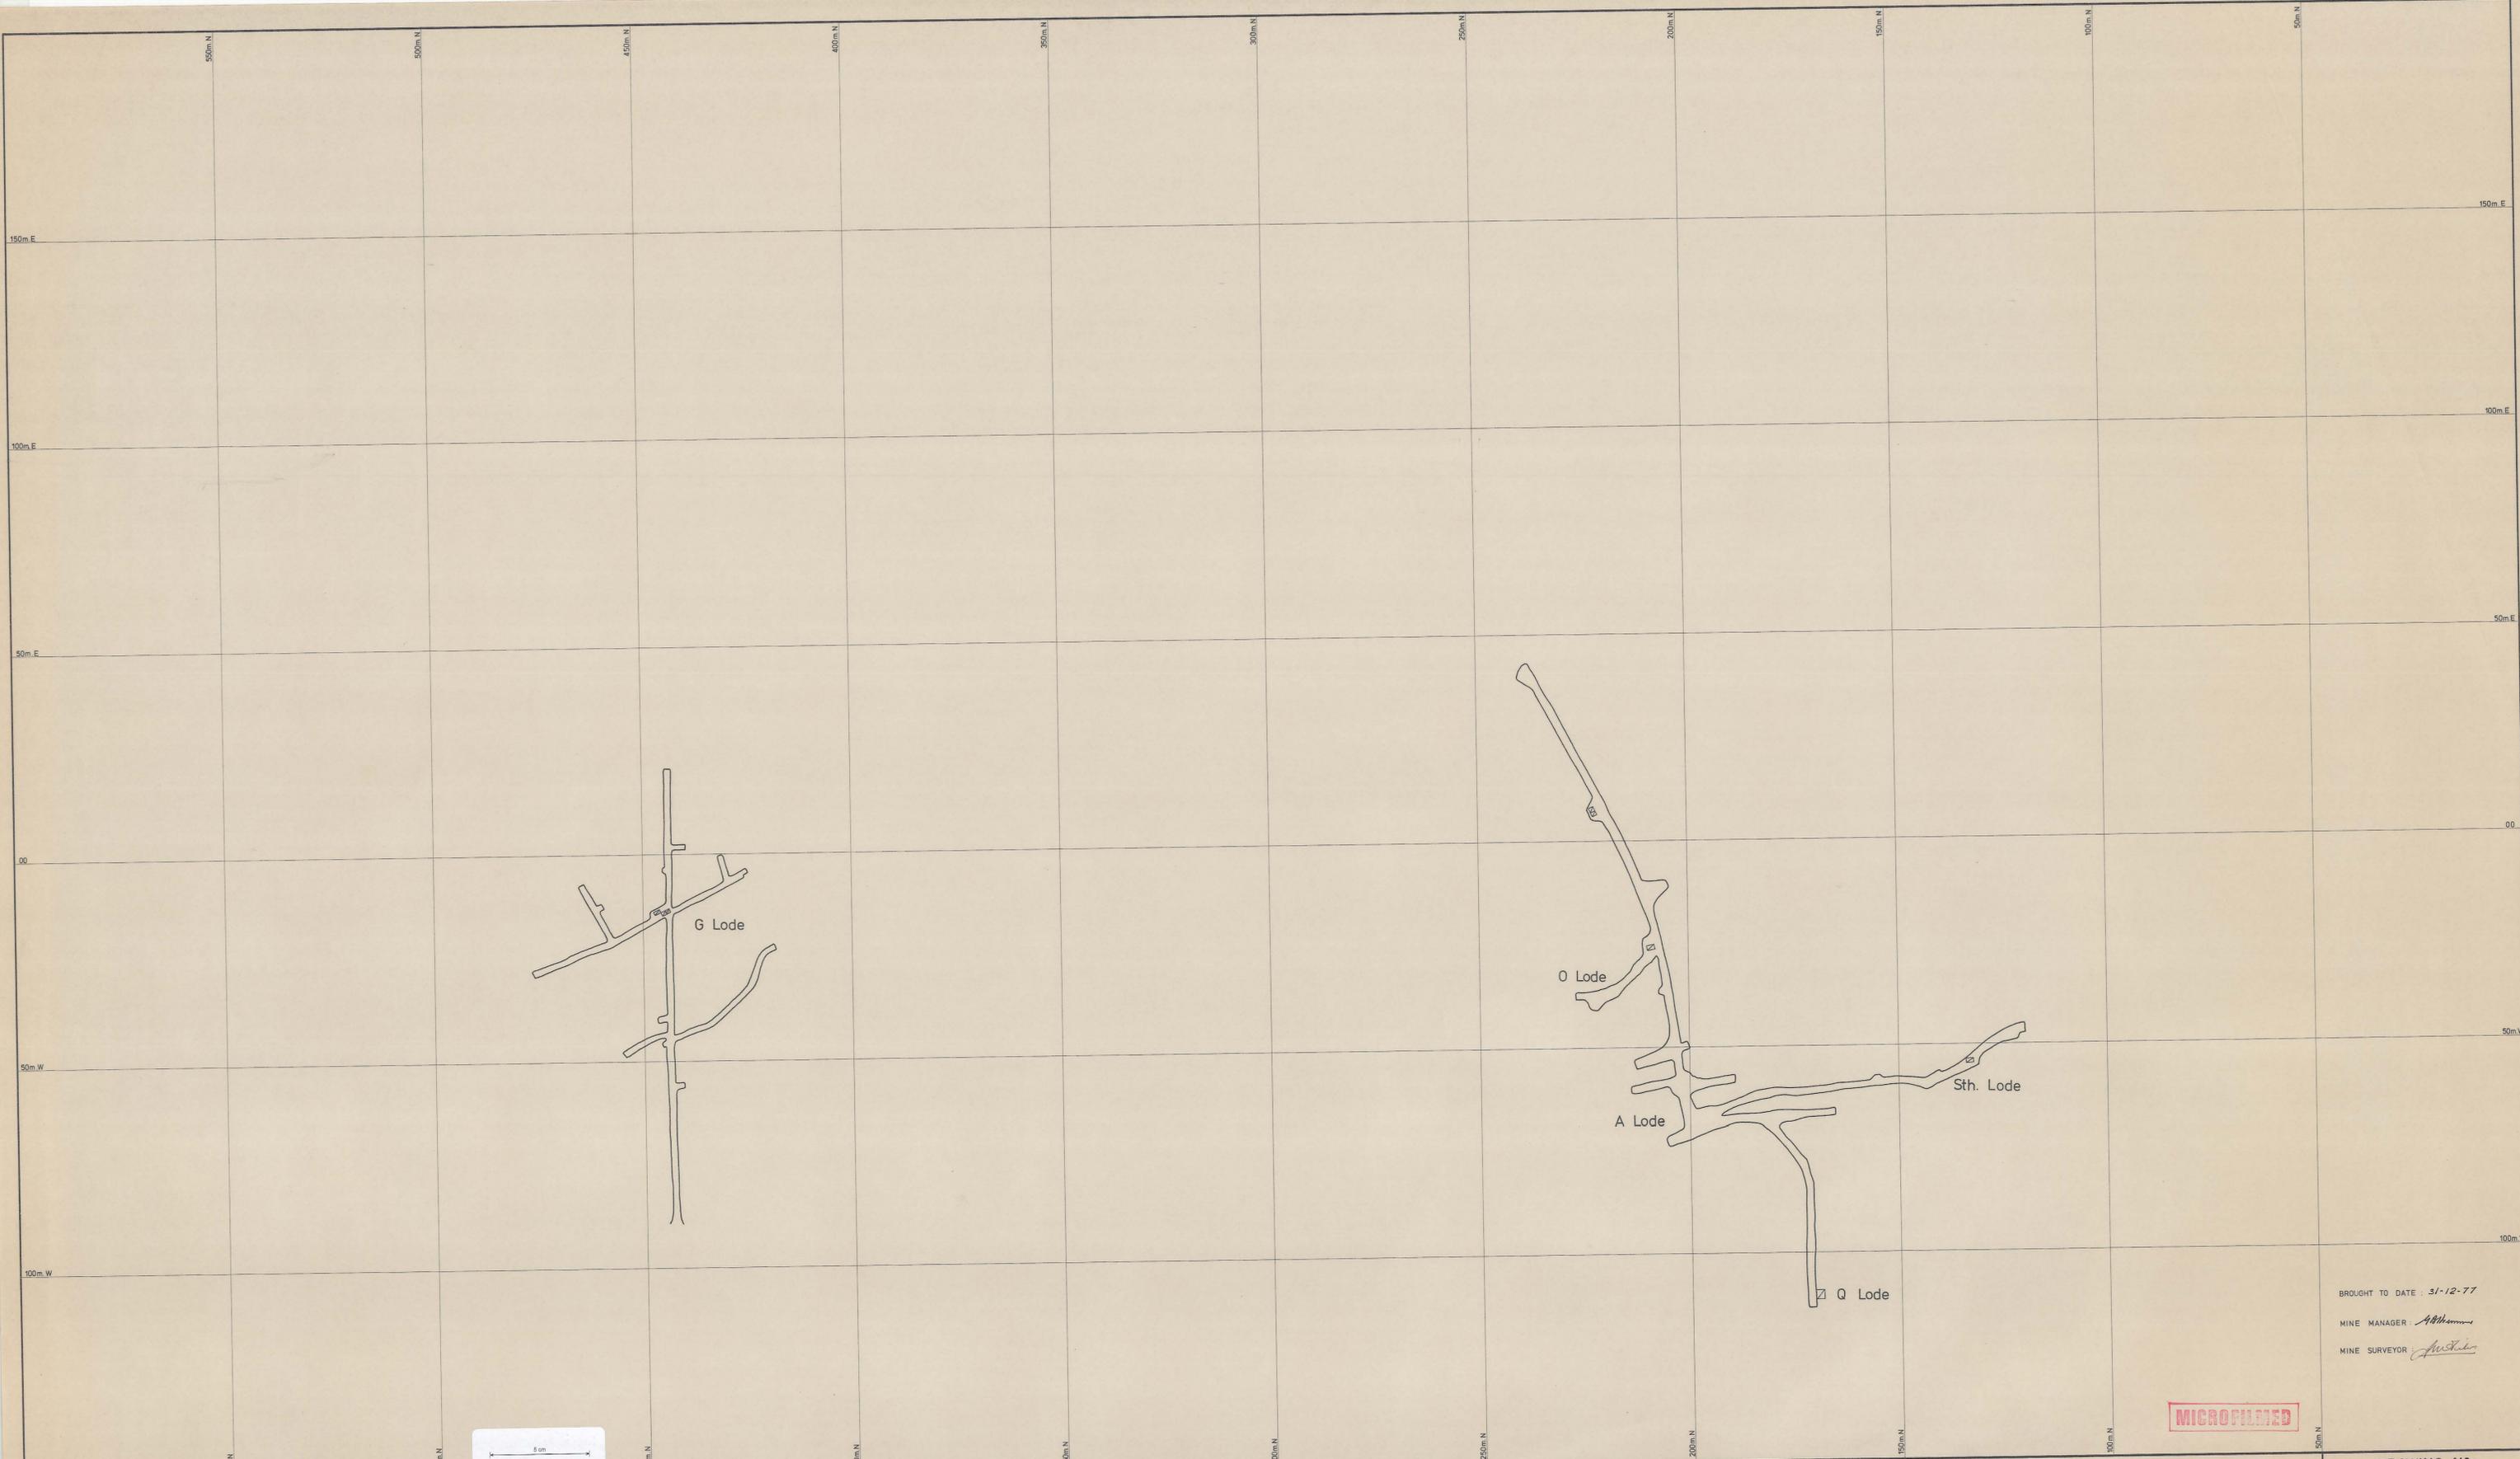

BROUGHT TO DATE : 31-12-77  
 MINE MANAGER : *Abraham*  
 MINE SURVEYOR : *Justin*

MICROFILMED

78155

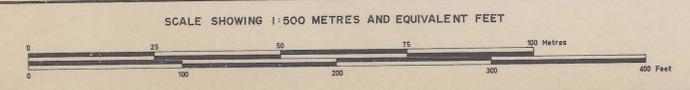

ELECTROLYTIC ZINC COMPANY OF AUSTRALASIA LIMITED  
 WEST COAST MINES, TAS.

SURVEY BY		SCALE	1 : 500 METRES
DRAWN BY		DATE	1973
TRACED BY	P. J. Lowe	REFERENCE	

HERCULES MINE  
 N° 5B LEVEL

DRAWING N° :  
 DEPARTMENT OF MINES  
 PLAN