


0055-229



0055-229

MICROFILMED

BROUGHT TO DATE: 31-12-77  
 MINE MANAGER: *ABH*  
 MINE SURVEYOR: *AS*

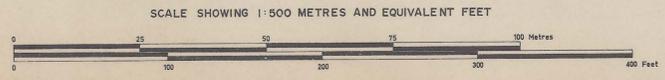

**ELECTROLYTIC ZINC COMPANY OF AUSTRALASIA LIMITED**  
 WEST COAST MINES, T.A.S.

SURVEY BY		SCALE	1 : 500 METRES
DRAWN BY		DATE	1973
TRACED BY	P. J. Lowe	REFERENCE	

HERCULES MINE  
 No 5A LEVEL

78154

DRAWING No: \_\_\_\_\_  
 DEPARTMENT OF MINES  
 PLAN