



0055-230

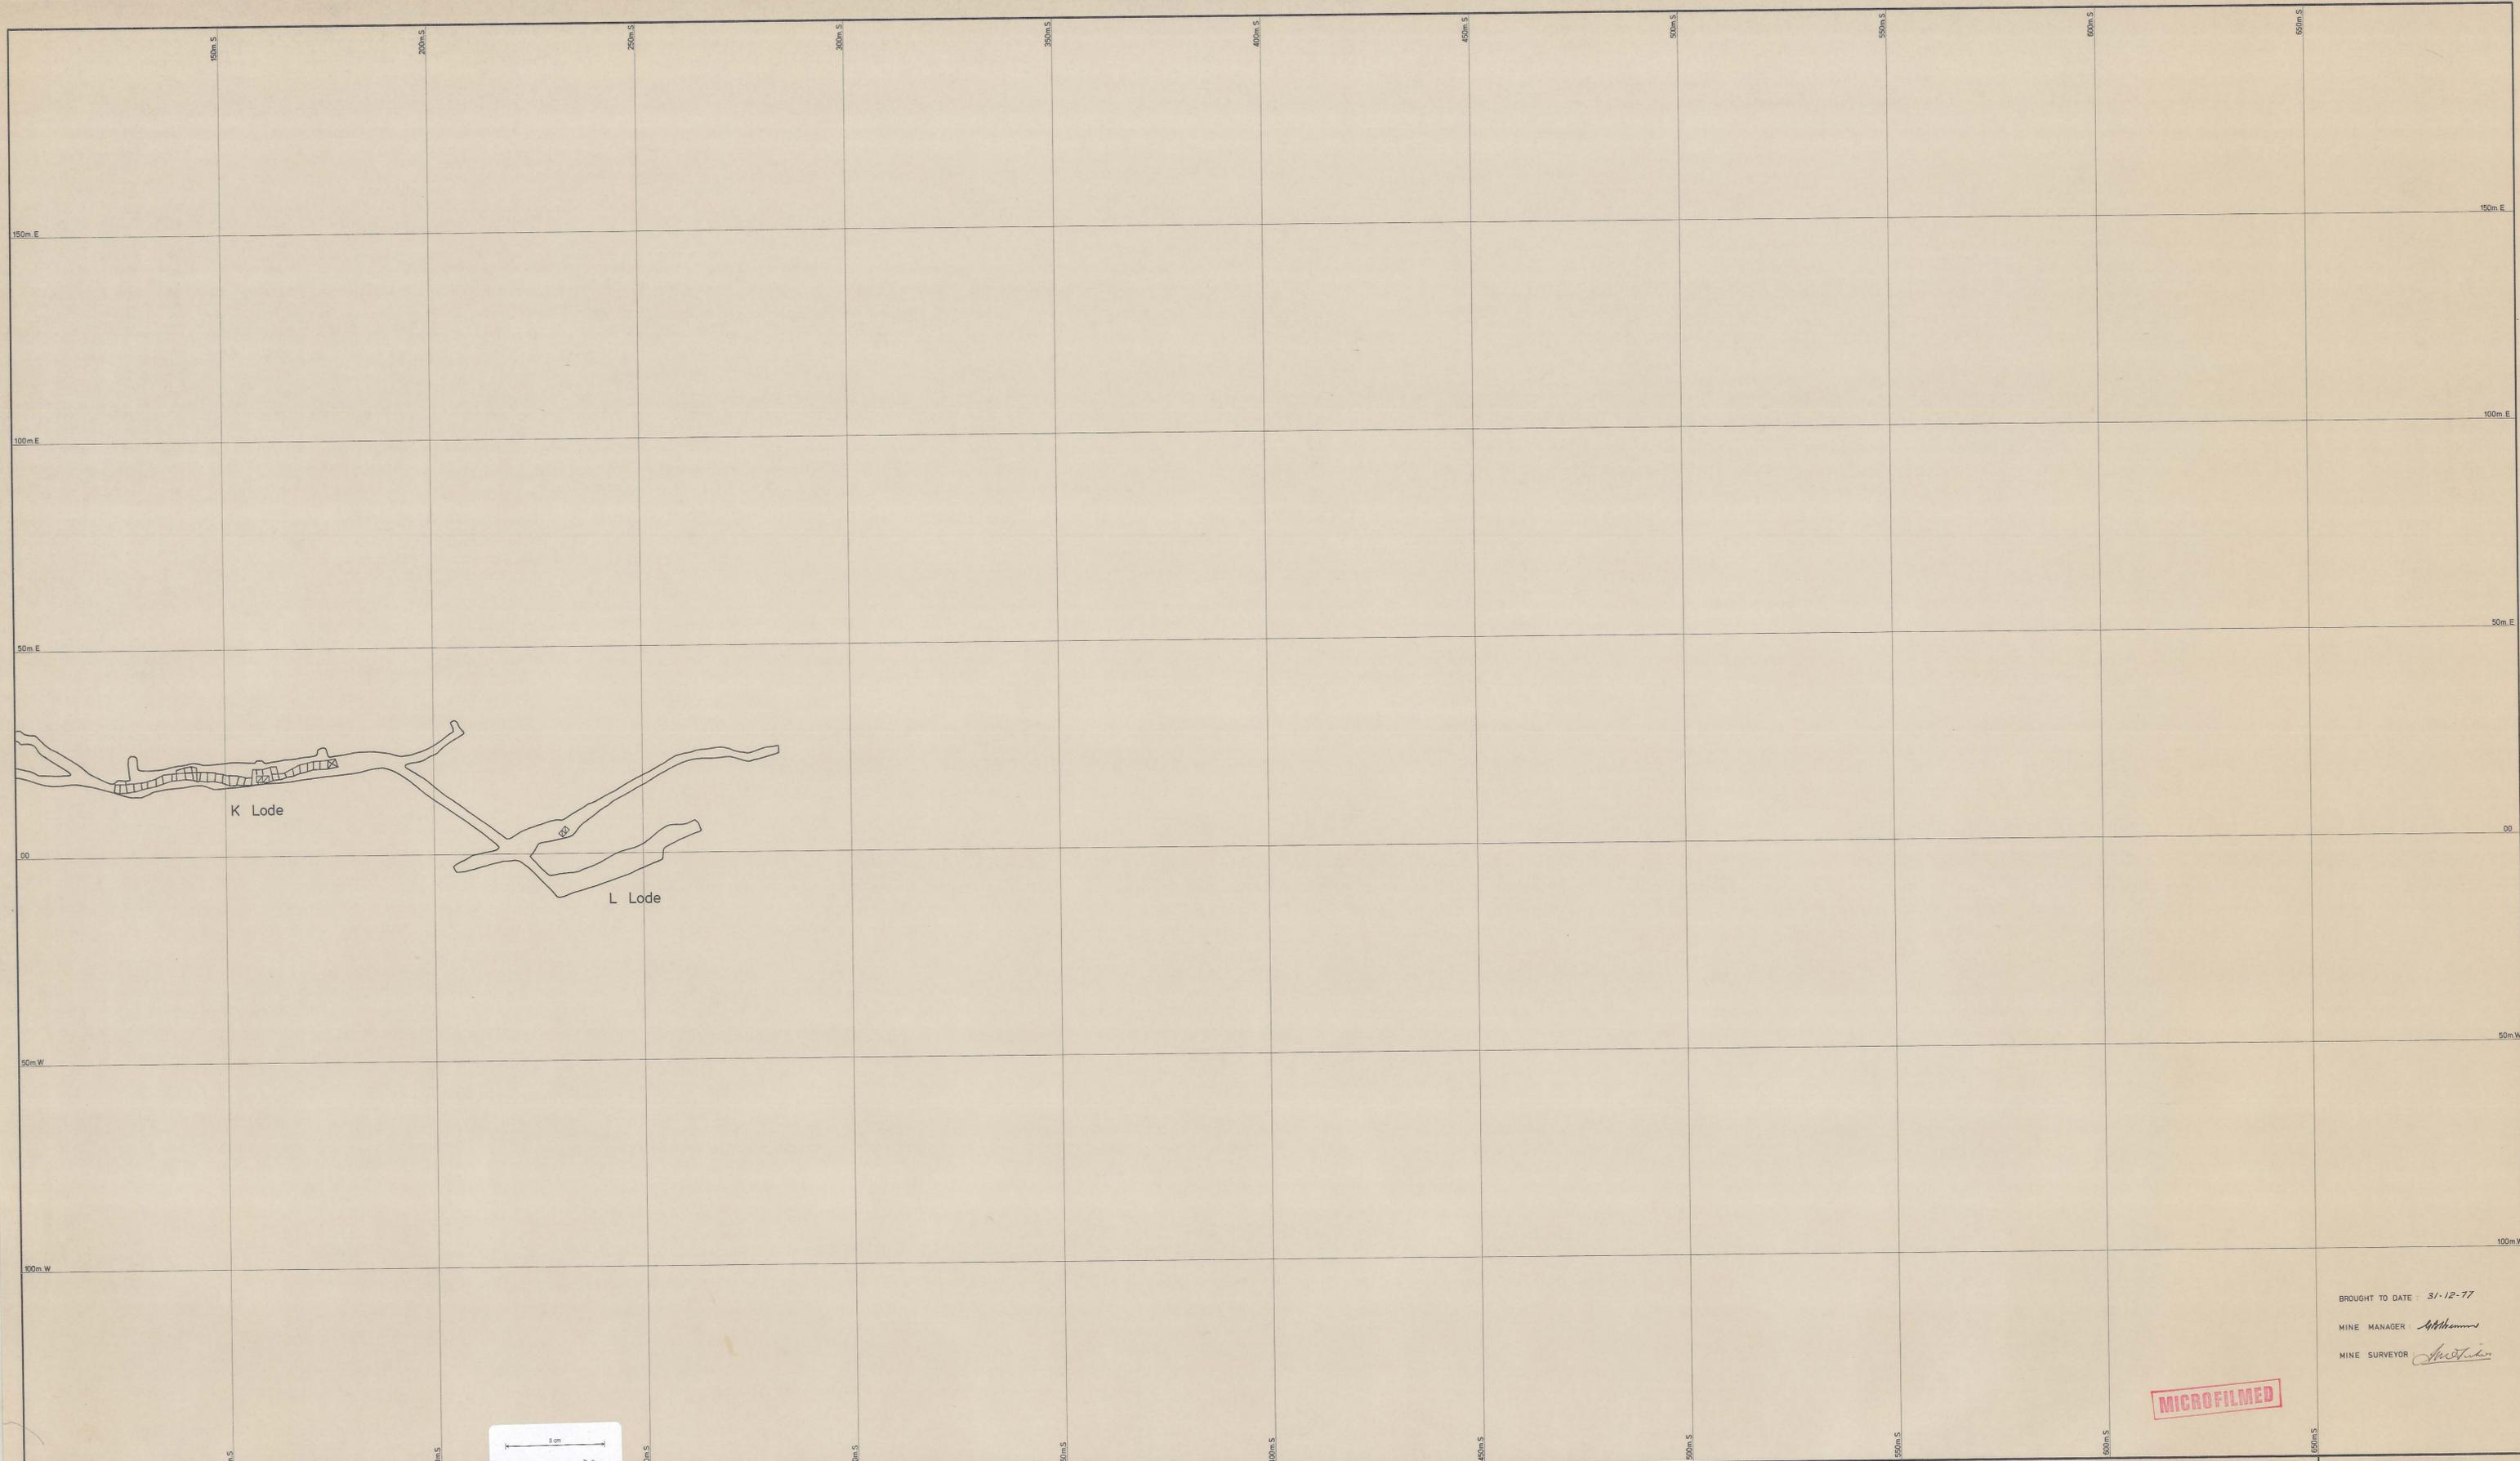

MICROFILMED

BROUGHT TO DATE : 31-12-77
 MINE MANAGER : *Altham*
 MINE SURVEYOR : *Smith*

0055-230

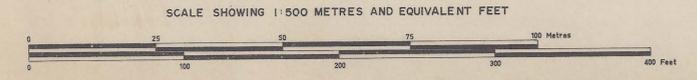

ELECTROLYTIC ZINC COMPANY OF AUSTRALASIA LIMITED
 WEST COAST MINES, T.A.S.

SURVEY BY		SCALE	1 : 500 METRES
DRAWN BY		DATE	1973
TRACED BY	P. J. Lowe	REFERENCE	

HERCULES MINE
 N° 5 LEVEL
 100m S - 700m S

78153

DRAWING N° :
 DEPARTMENT OF MINES
 PLAN