


00353-231



00353-231

BROUGHT TO DATE : 31-12-77
 MINE MANAGER : *Atkinson*
 MINE SURVEYOR : *Atkinson*

MICROFILMED

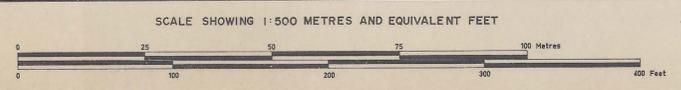

ELECTROLYTIC ZINC COMPANY OF AUSTRALASIA LIMITED
 WEST COAST MINES, TAS.

SURVEY BY	SCALE	1 : 500 METRES
DRAWN BY	DATE	1973
TRACED BY P. J. Lowe	REFERENCE	

HERCULES MINE
 No 5 LEVEL
 100m.S - 500m.N

78152

DRAWING No :
 DEPARTMENT OF MINES
 PLAN