


0055-232



BROUGHT TO DATE: 31-12-77
 MINE MANAGER: *ABHanna*
 MINE SURVEYOR: *Asst. W. L. ...*

MICROFILMED

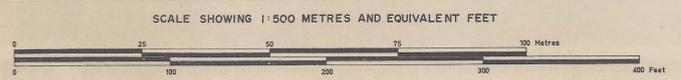

ELECTROLYTIC ZINC COMPANY OF AUSTRALASIA LIMITED
 WEST COAST MINES, T.A.S.

SURVEY BY		SCALE	1 : 500 METRES
DRAWN BY		DATE	1973
TRACED BY	P. J. Lowe	REFERENCE	

HERCULES MINE
 No 4 LEVEL
 00-600m.N

78151

DRAWING No:
 DEPARTMENT OF MINES
 PLAN