


0055-2-34



BROUGHT TO DATE : 31-12-77
 MINE MANAGER : *[Signature]*
 MINE SURVEYOR : *[Signature]*

MICROFILMED

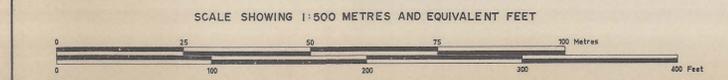

0055-2-34

ELECTROLYTIC ZINC COMPANY OF AUSTRALASIA LIMITED
 WEST COAST MINES, TAS.

SURVEY BY	SCALE	1 : 500 METRES
DRAWN BY	DATE	1973
TRACED BY P. J. Lowe	REFERENCE	

HERCULES MINE
 N° 3A LEVEL
 00 - 600m.N

78149

DRAWING N° :
 DEPARTMENT OF MINES
 PLAN