



0055-235

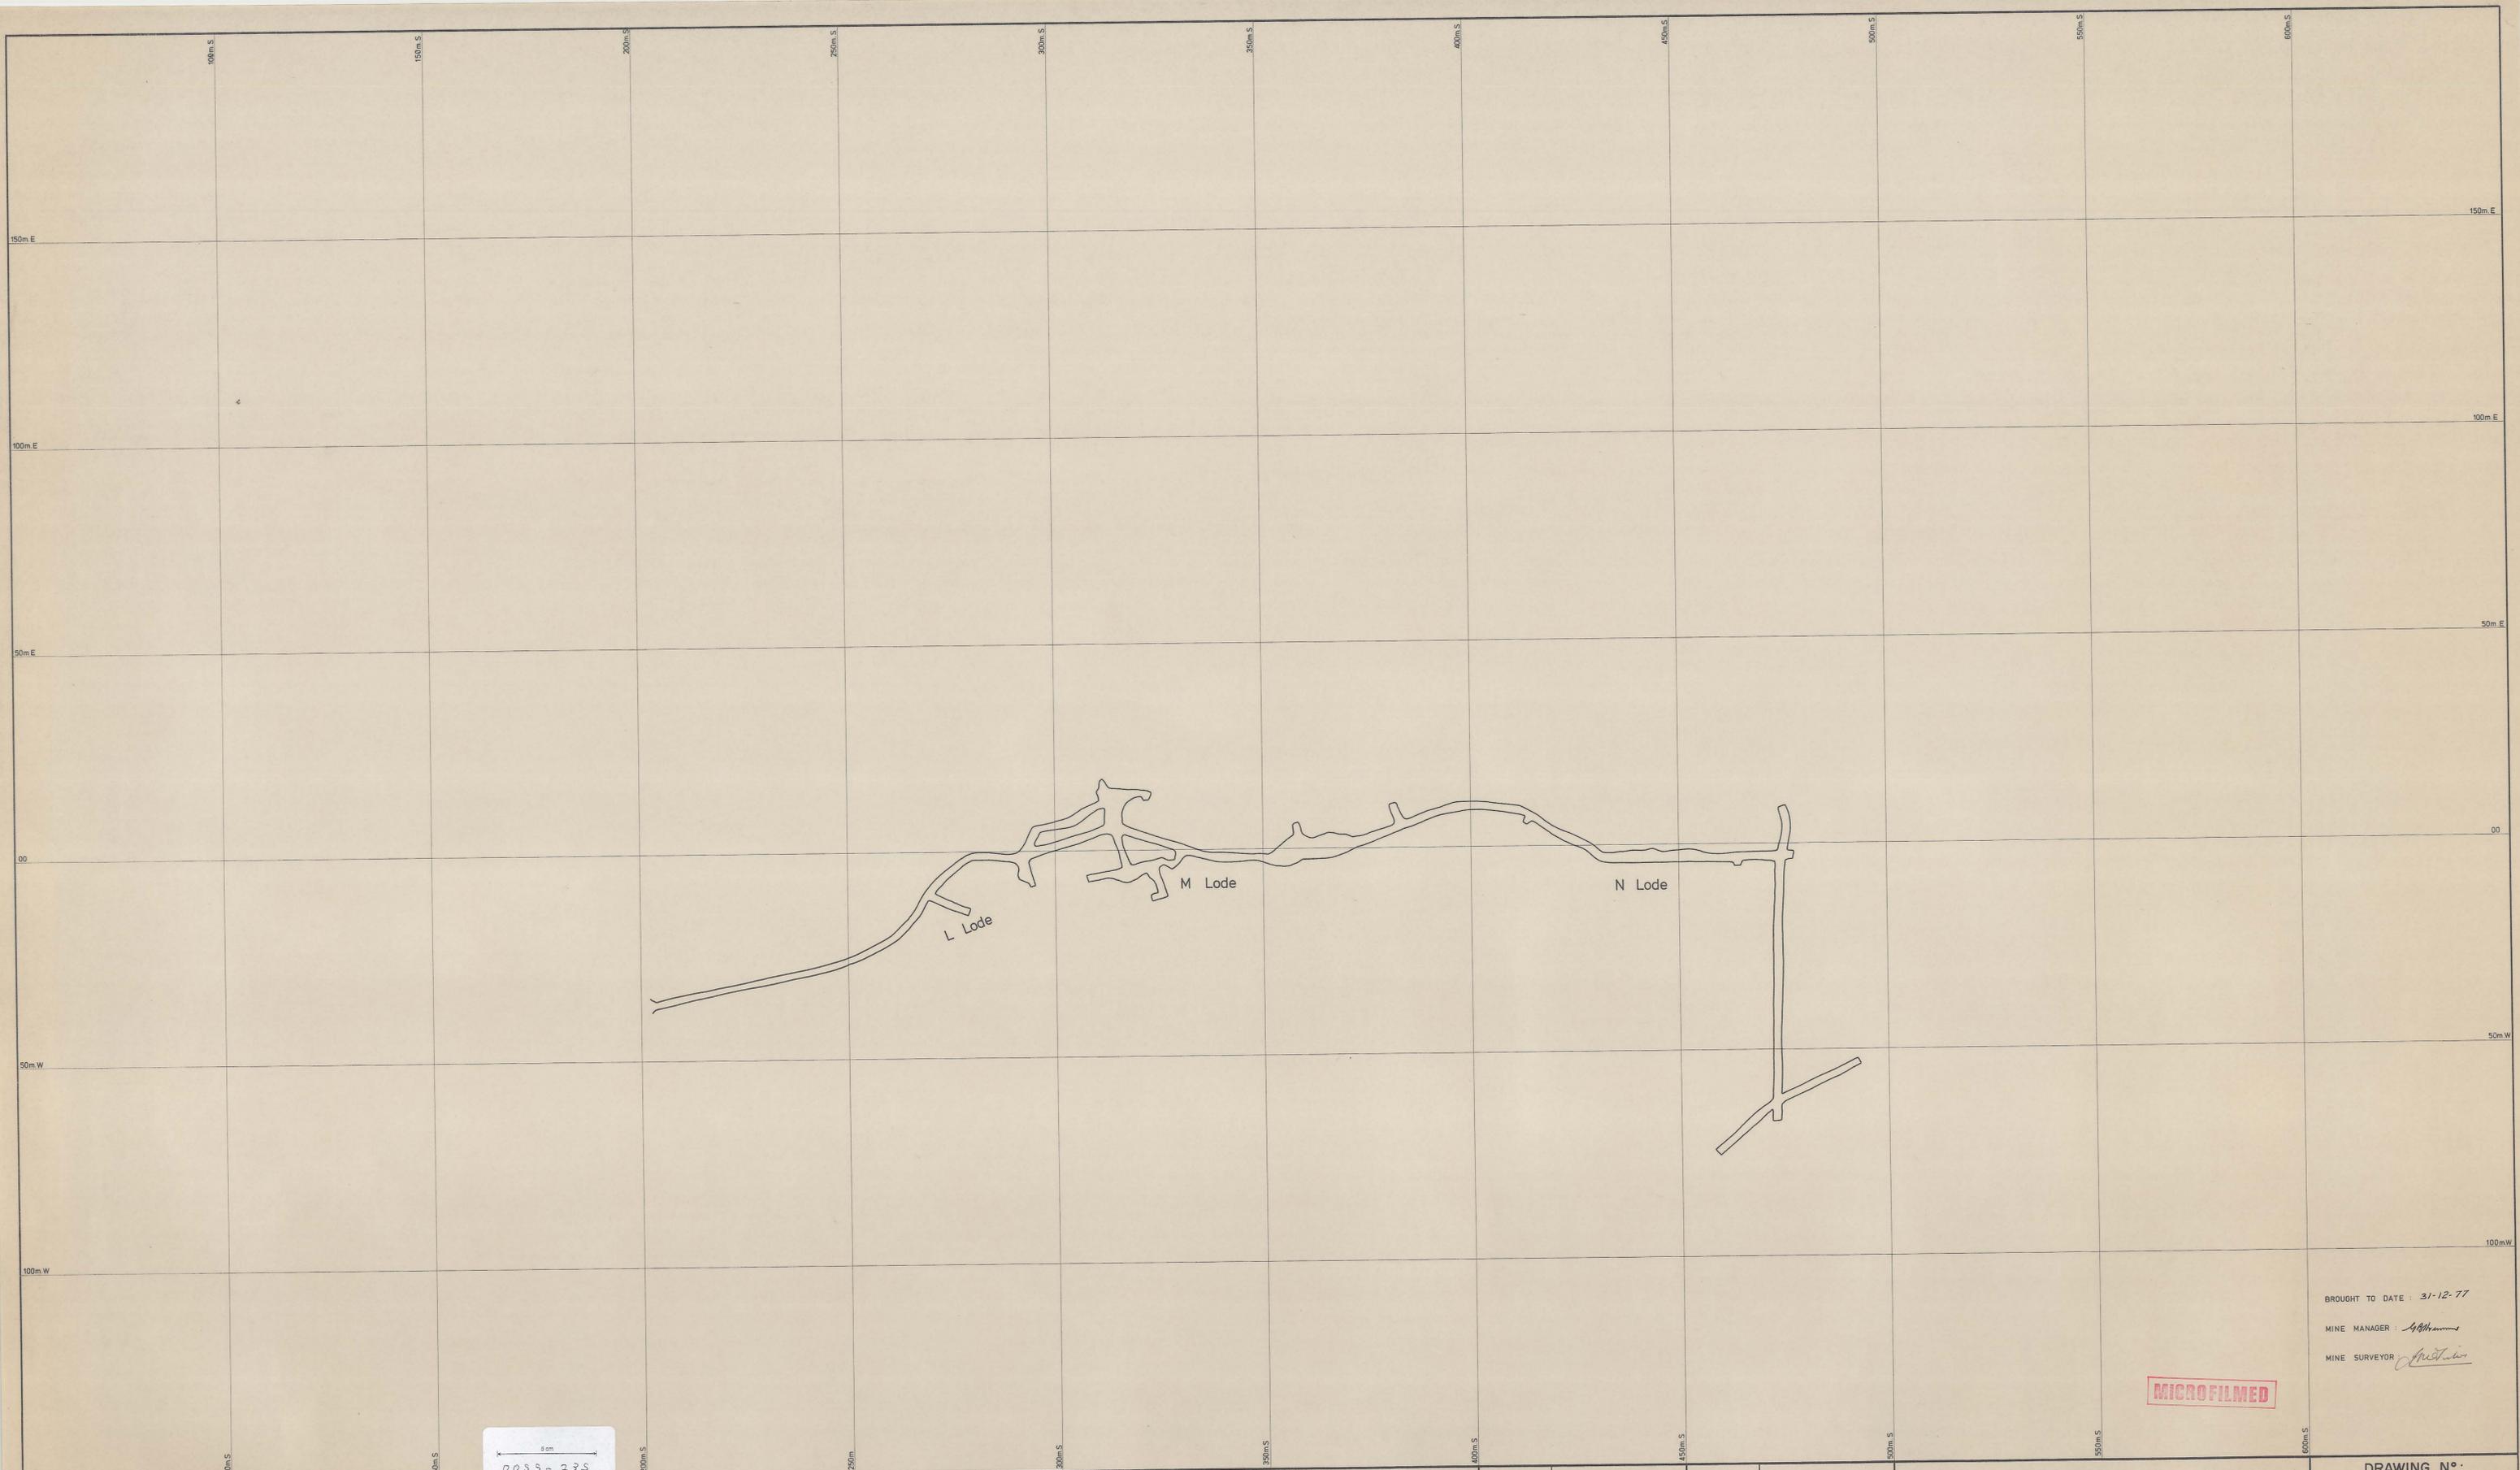

0055-235

MICROFILMED

BROUGHT TO DATE : 31-12-77  
 MINE MANAGER : *[Signature]*  
 MINE SURVEYOR : *[Signature]*

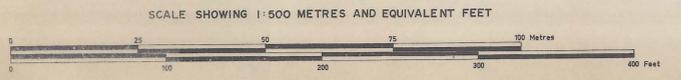

ELECTROLYTIC ZINC COMPANY OF AUSTRALASIA LIMITED  
 WEST COAST MINES, T.A.S.

SURVEY BY		SCALE	1 : 500 METRES
DRAWN BY		DATE	1973
TRACED BY	P. J. Lowe	REFERENCE	

HERCULES MINE  
 N° 3A LEVEL  
 50m.S - 650m.S

78148

DRAWING N° :  
 DEPARTMENT OF MINES  
 PLAN