



0055-236

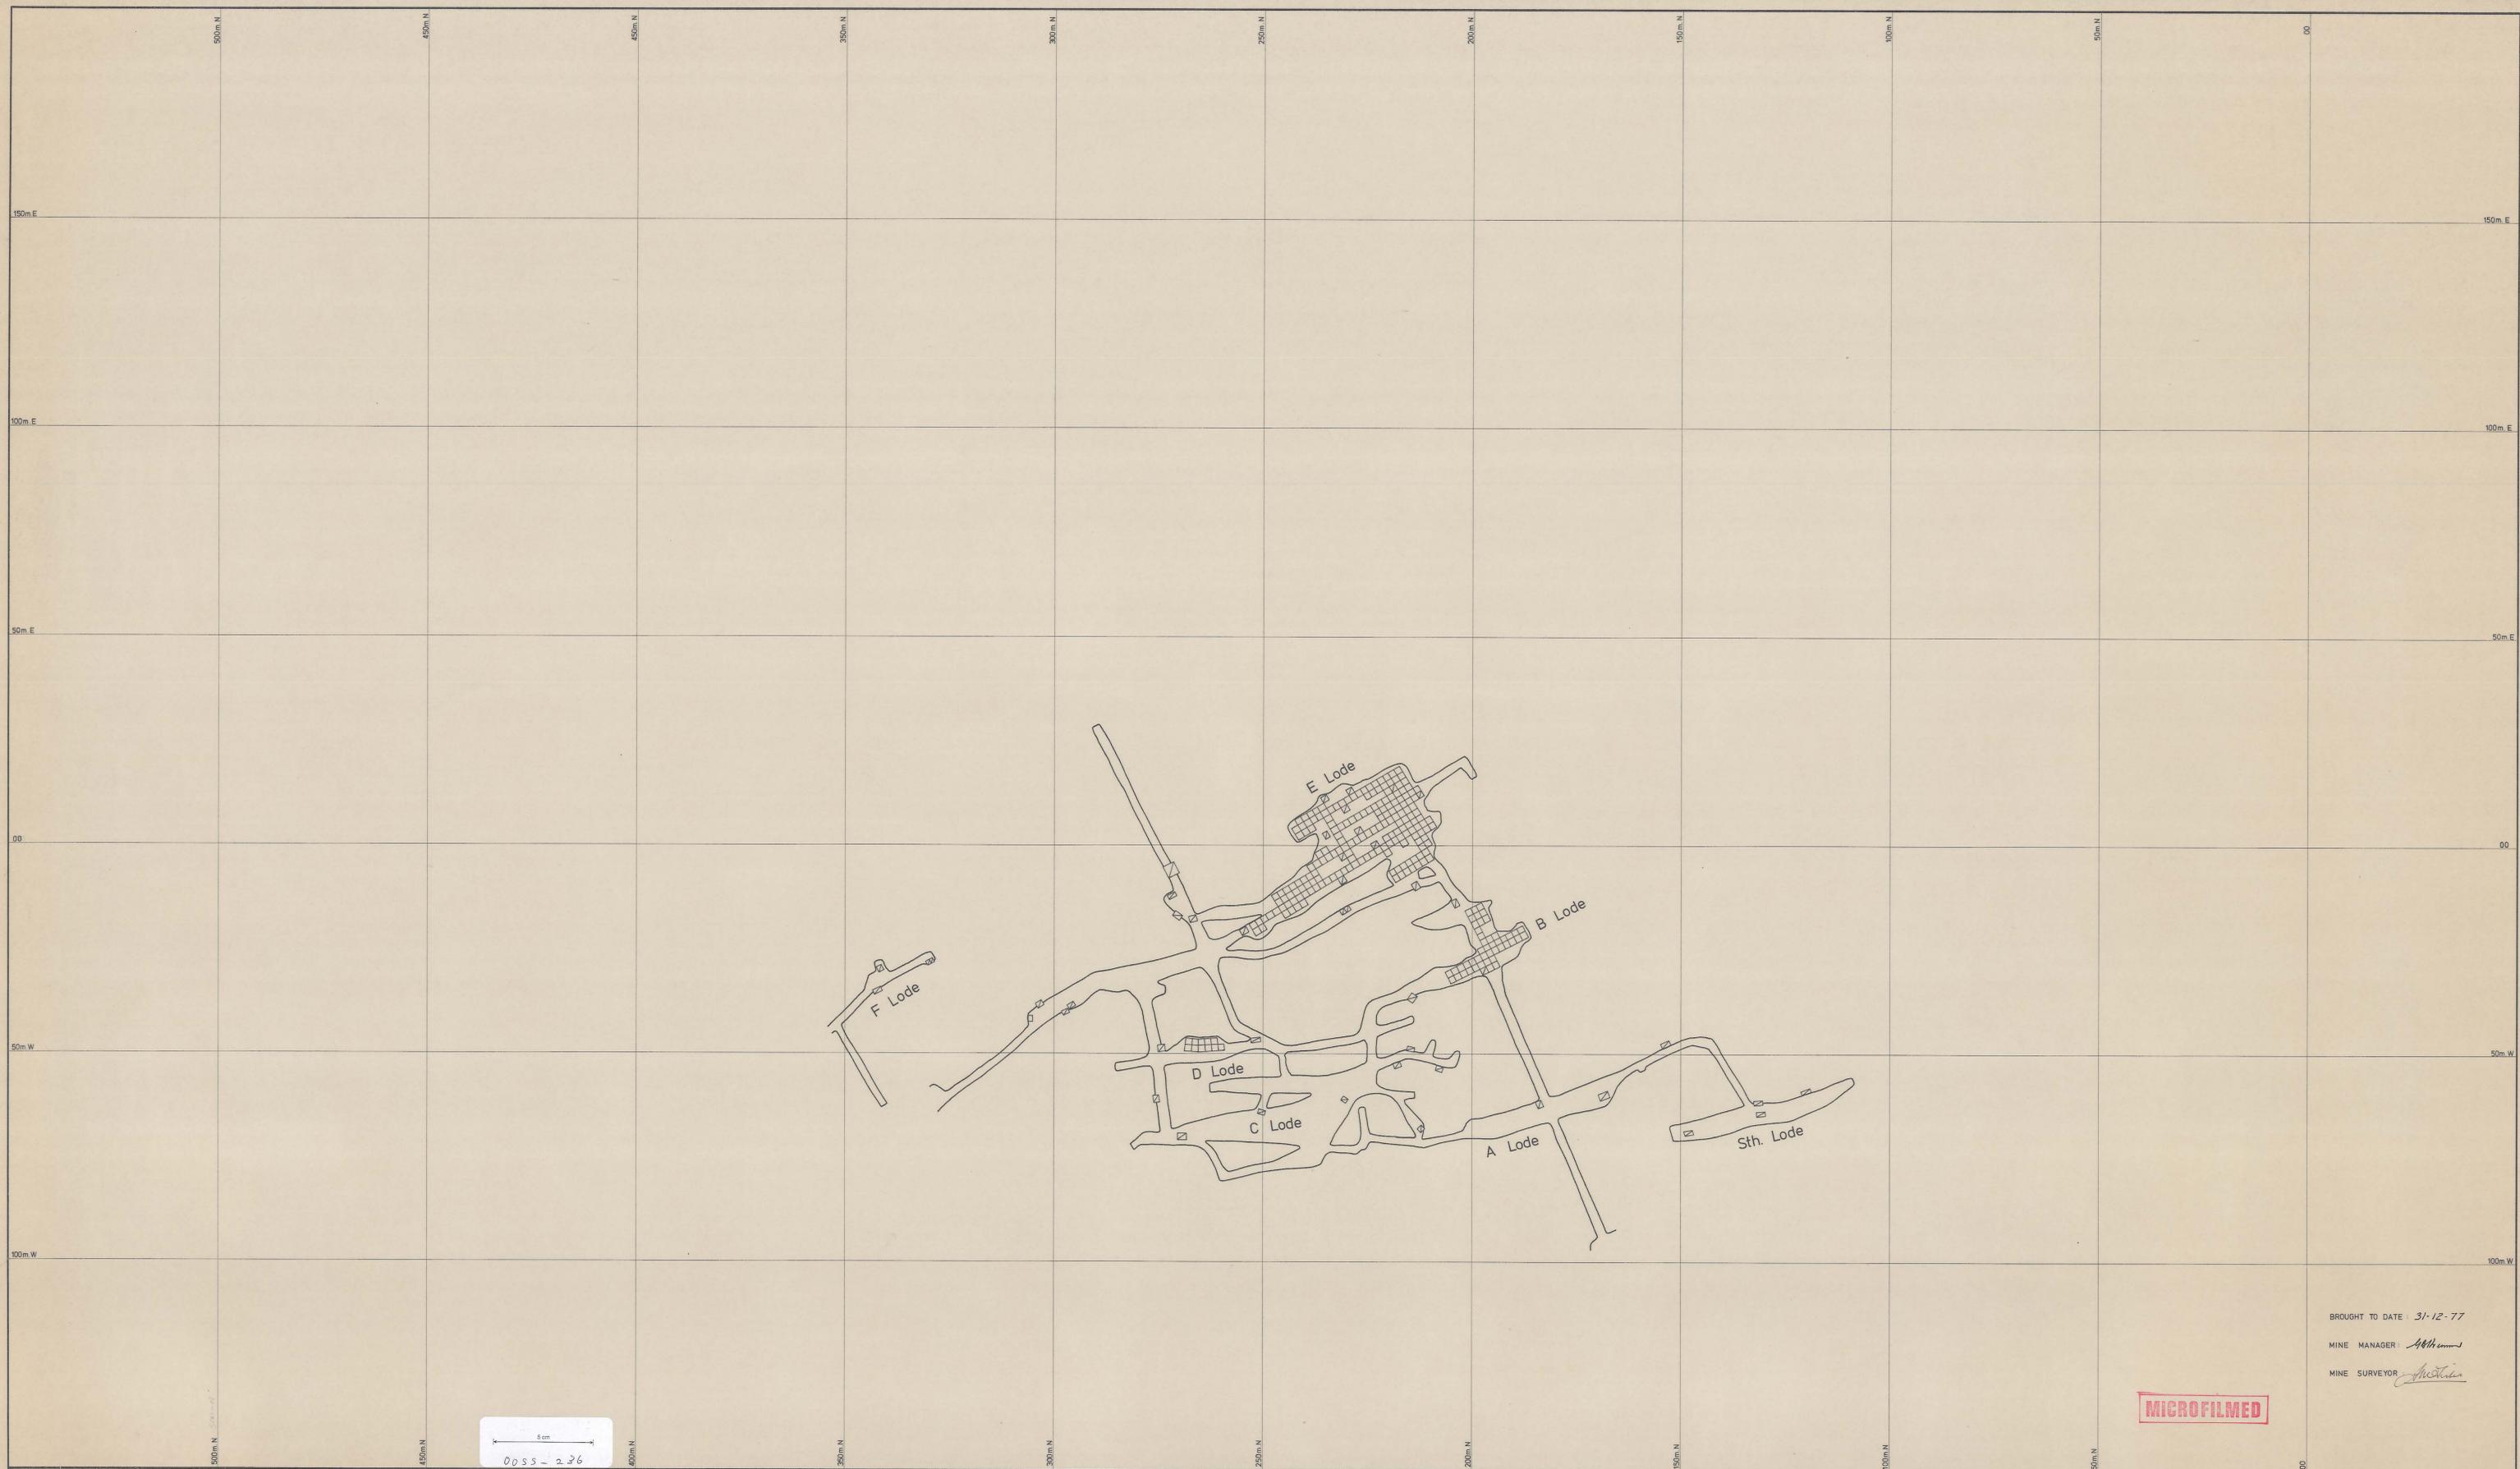

50m
0055-236

MICROFILMED

BROUGHT TO DATE : 31-12-77
 MINE MANAGER : *M. H. ...*
 MINE SURVEYOR : *A. ...*

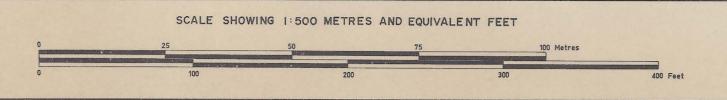

ELECTROLYTIC ZINC COMPANY OF AUSTRALASIA LIMITED
 WEST COAST MINES, T.A.S.

SURVEY BY		SCALE	1 : 500 METRES
DRAWN BY		DATE	1973
TRACED BY	P. J. Lowe	REFERENCE	

HERCULES MINE
 No 3 LEVEL

78147

DRAWING No :
 DEPARTMENT OF MINES
 PLAN