


0055-237

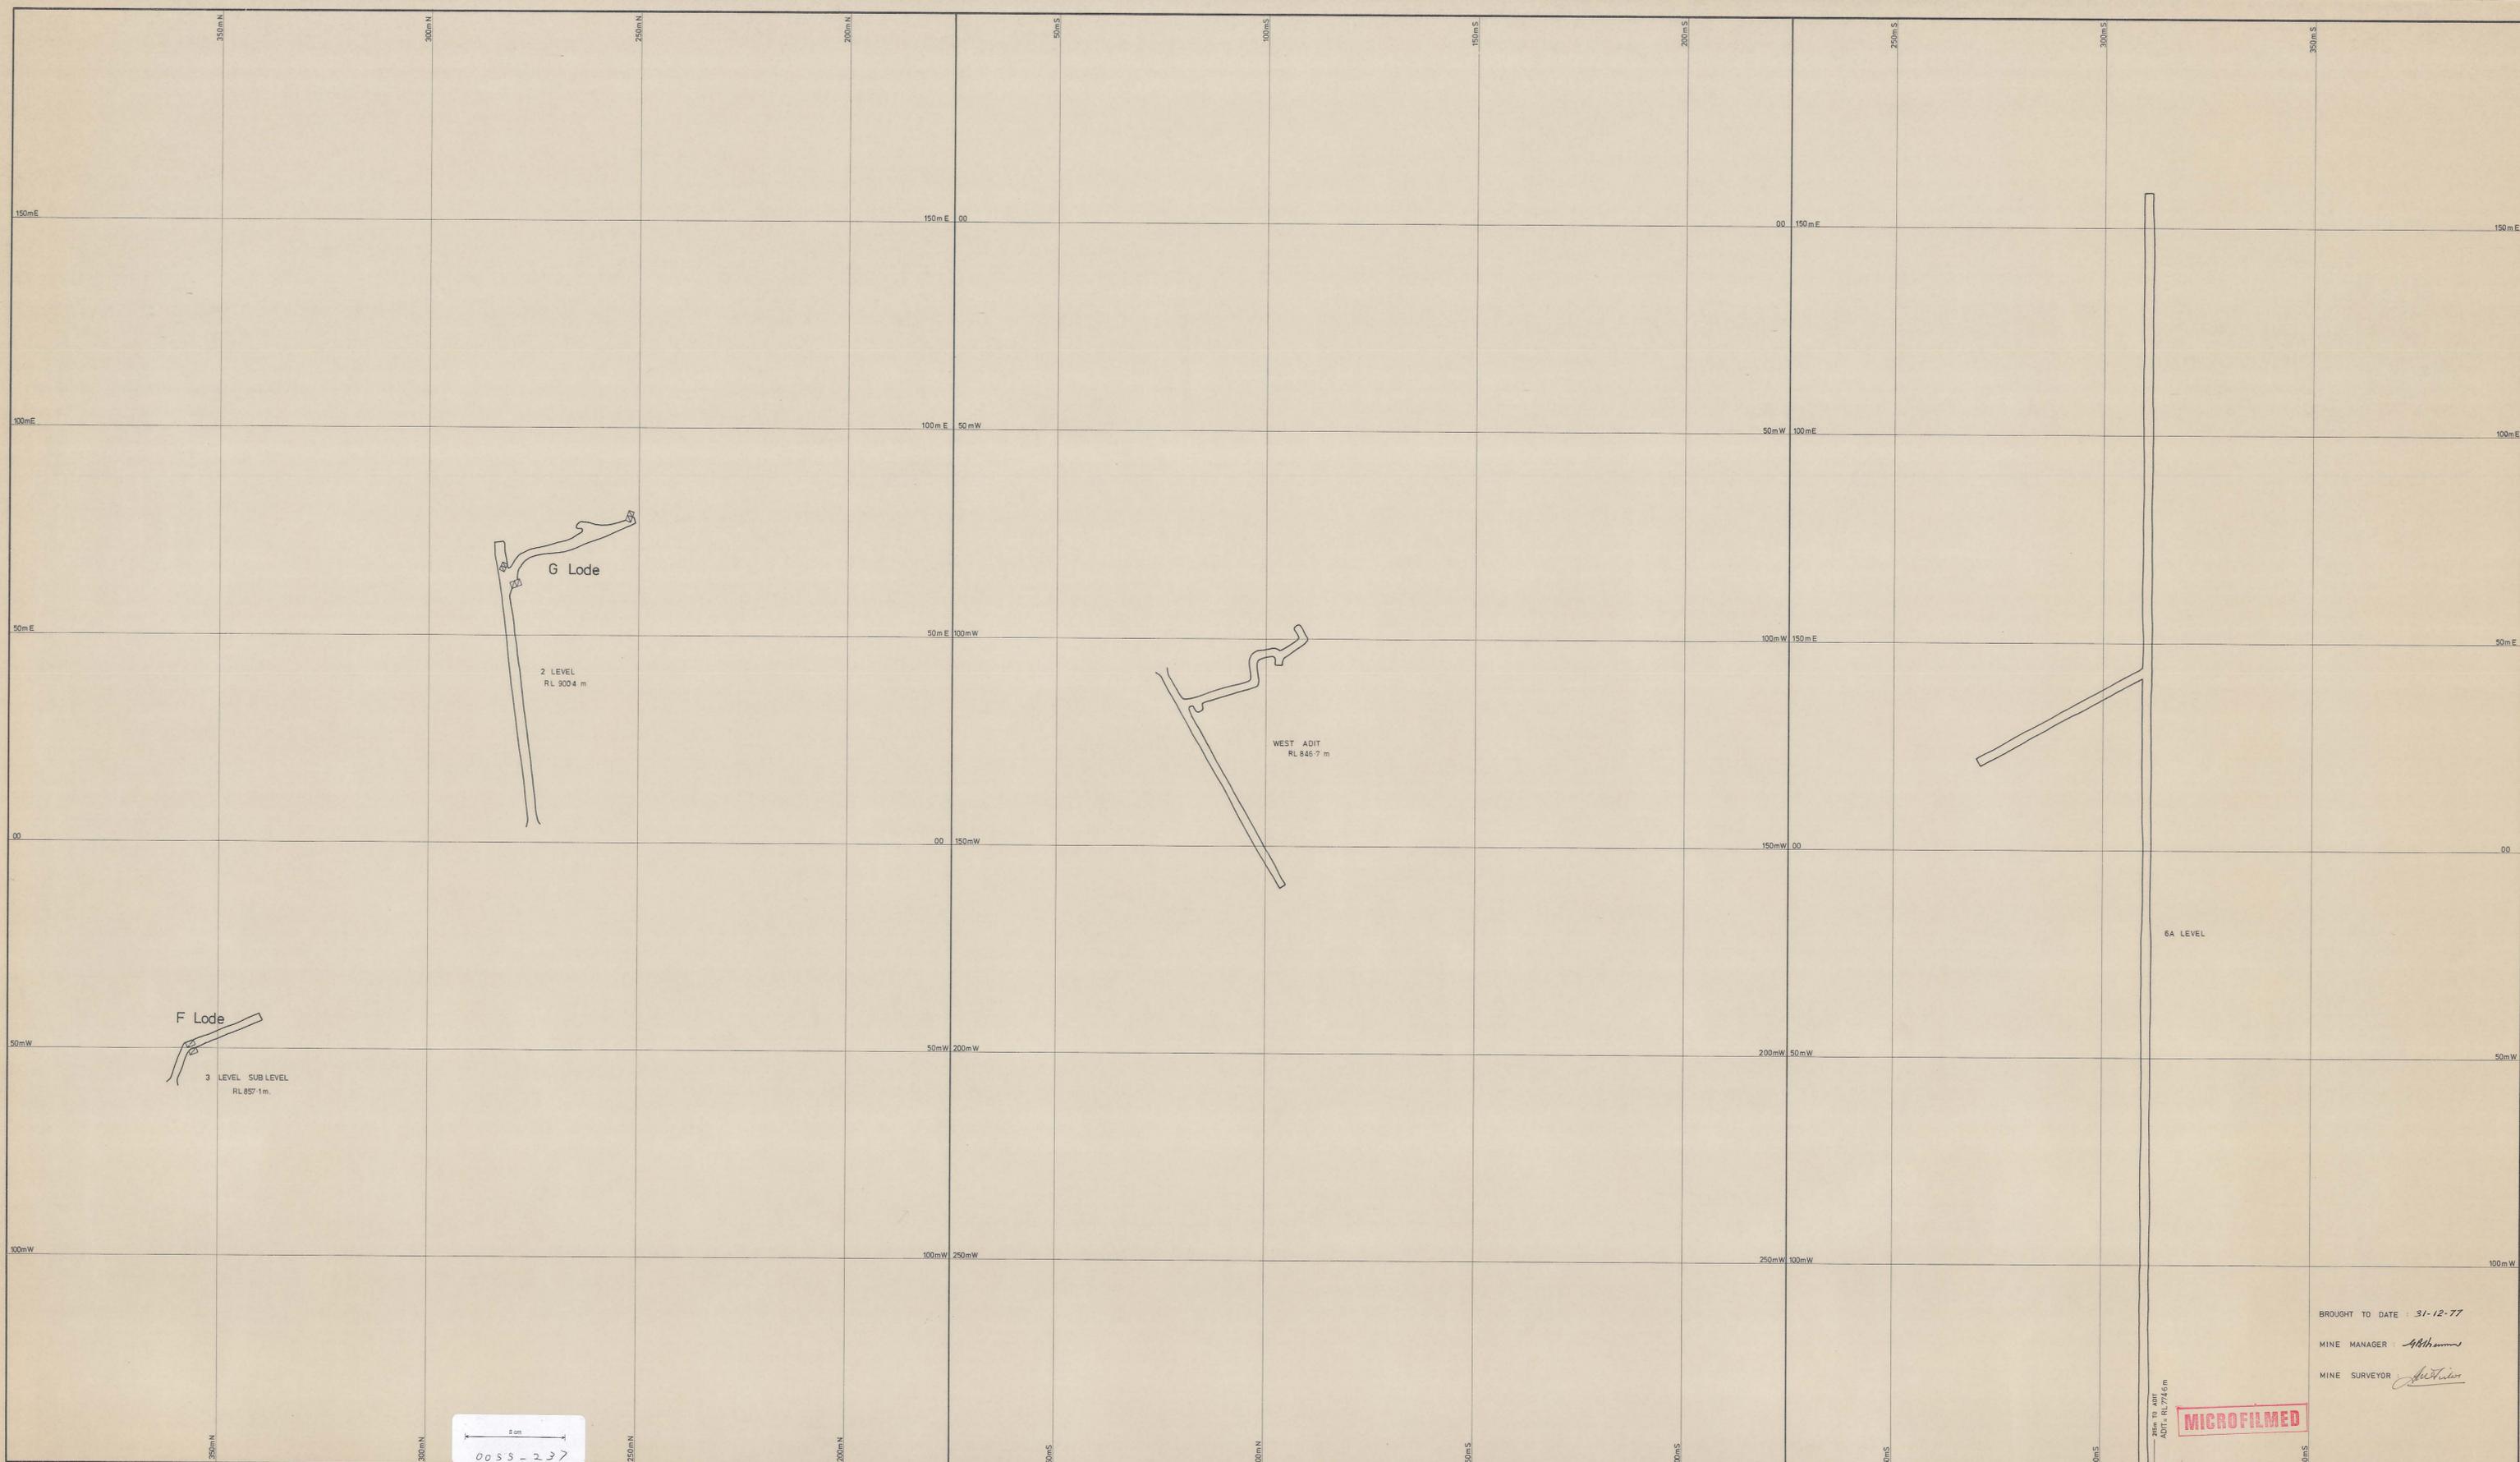


0055-237

BROUGHT TO DATE : 31-12-77
 MINE MANAGER : *Abraham*
 MINE SURVEYOR : *Spencer*

MICROFILMED

ADIT - RL 874.6 m

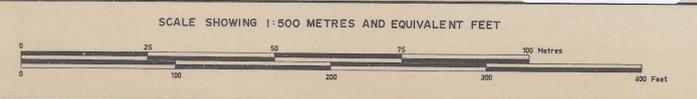

ELECTROLYTIC ZINC COMPANY OF AUSTRALASIA LIMITED
 WEST COAST MINES, T.A.S.

SURVEY BY		SCALE	1 : 500
DRAWN BY		DATE	1973
TRACED BY	P. J. Lowe	REFERENCE	

HERCULES MINE
 LEVEL PLAN

78146

DRAWING NO.:
 DEPARTMENT OF MINES