


0055_238

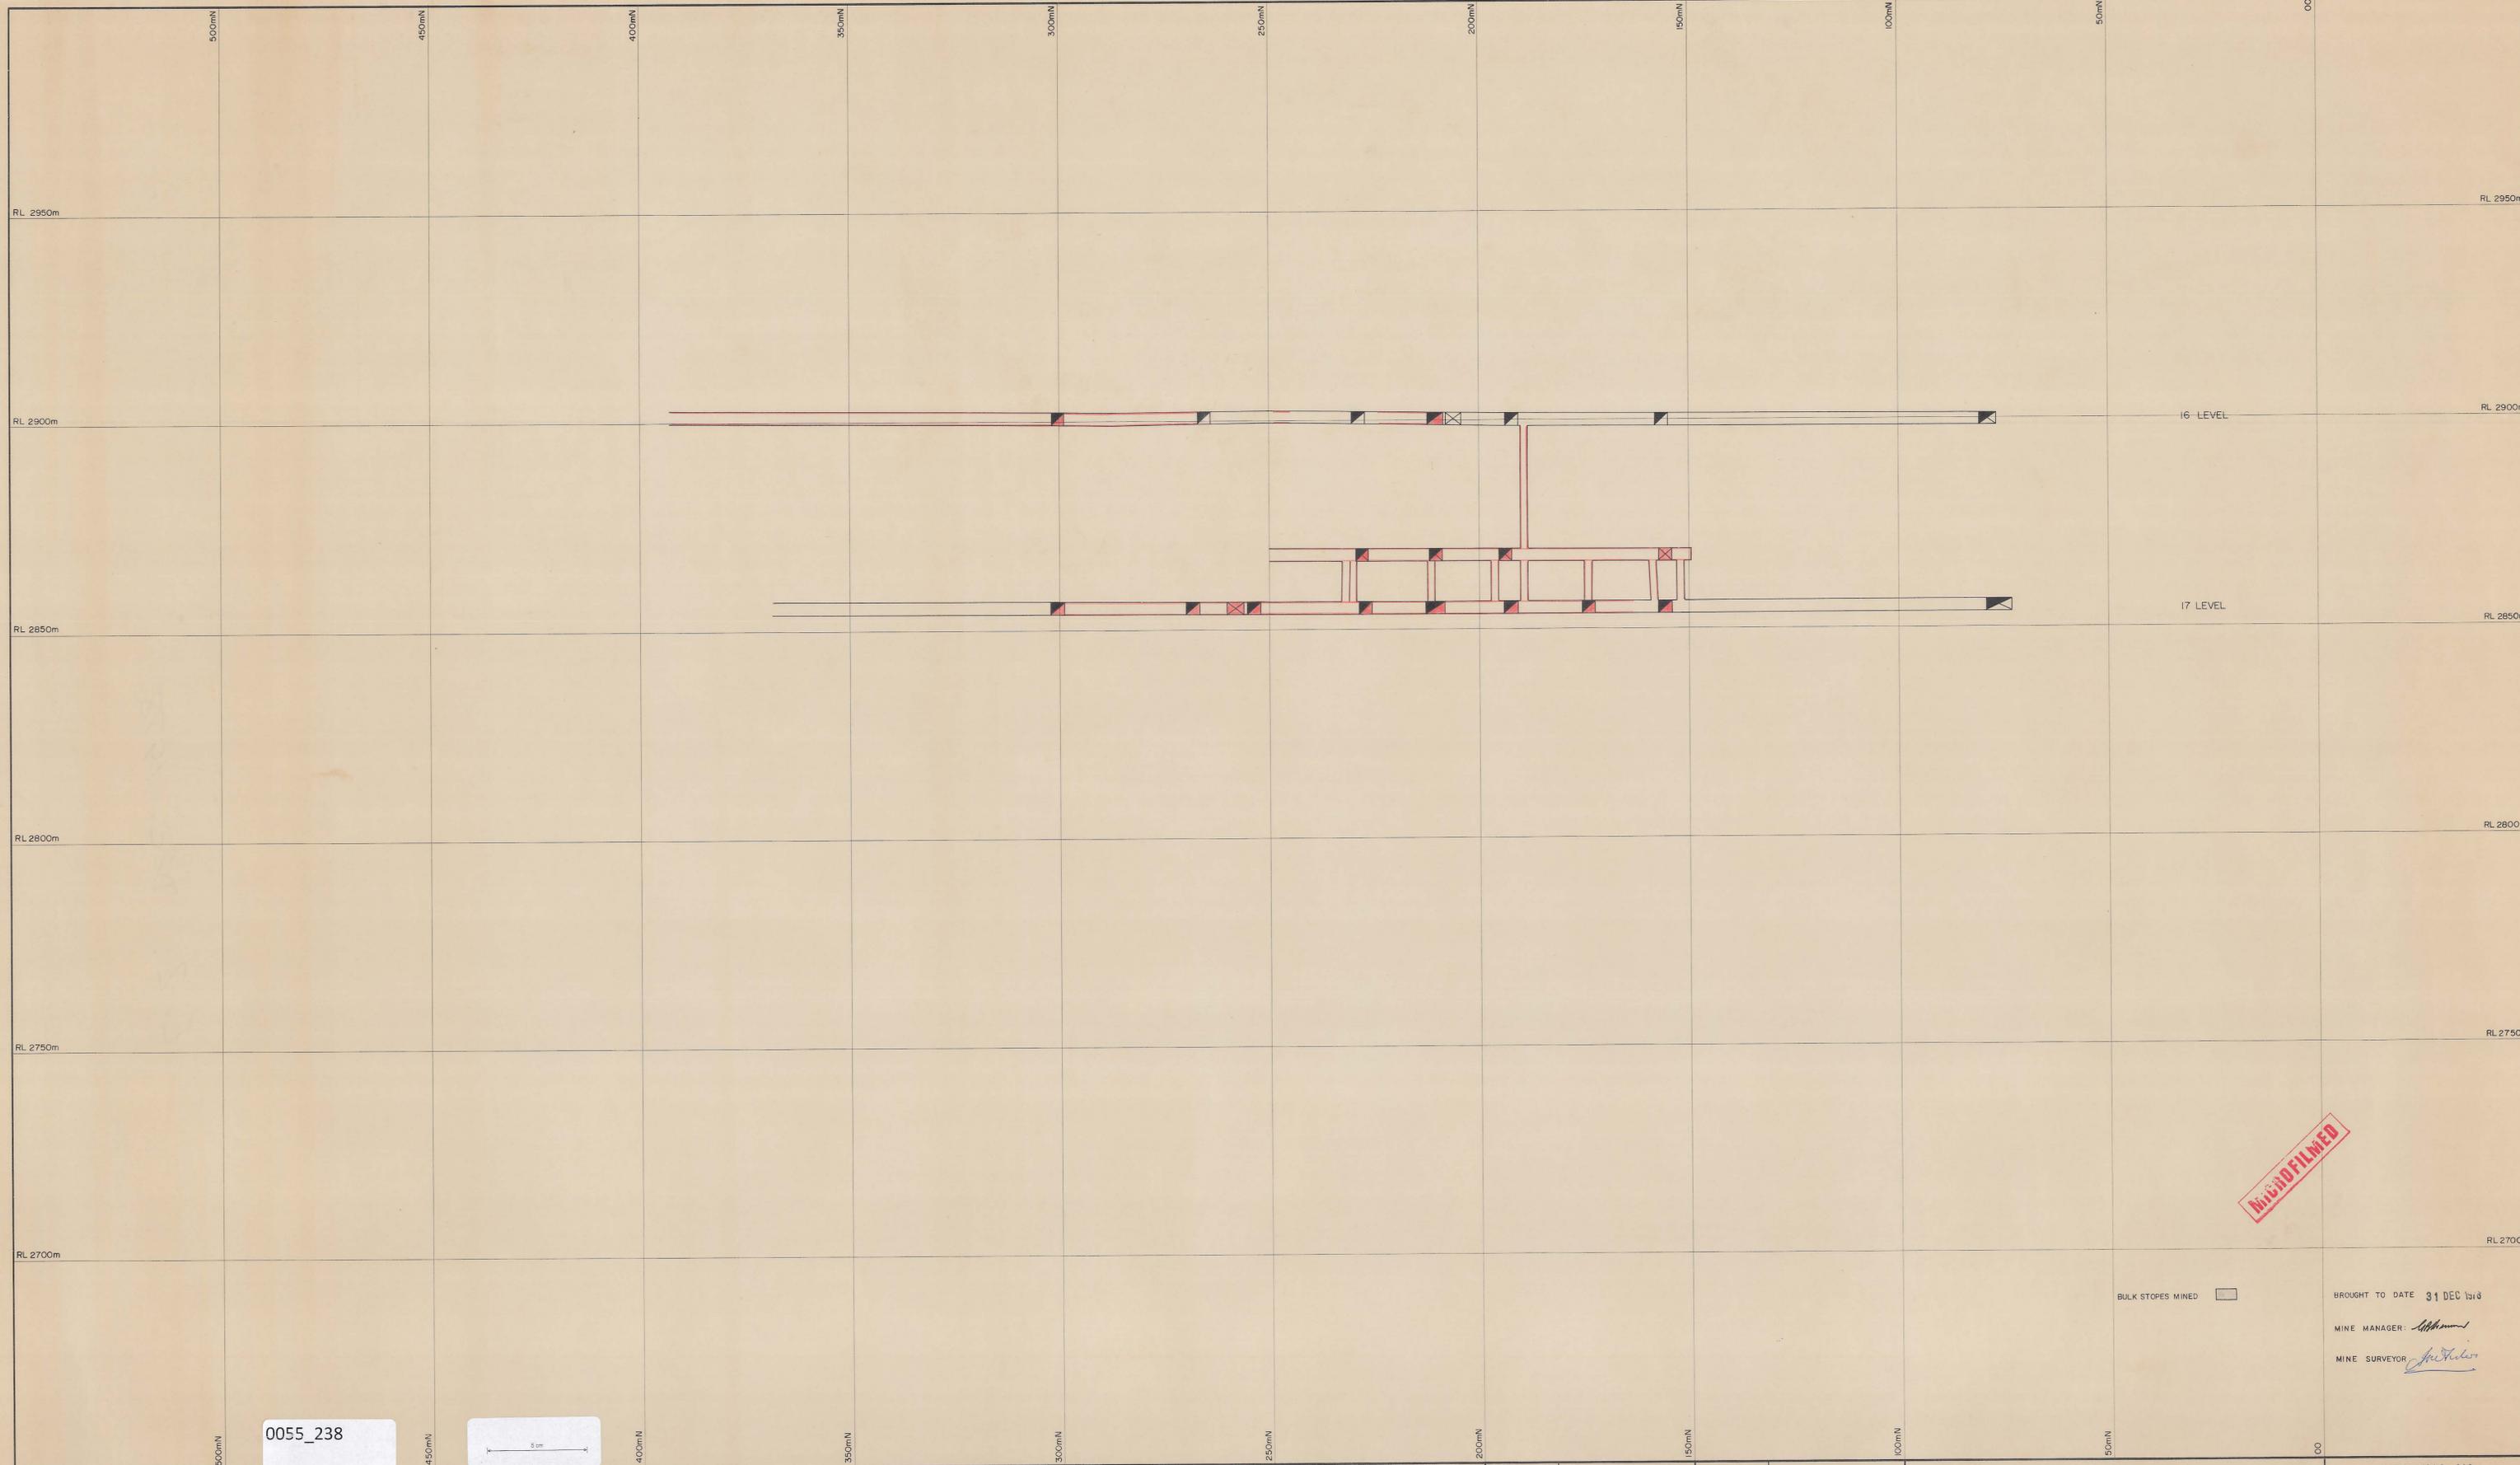

NOT FILMED

BULK STOPS MINED

BROUGHT TO DATE 31 DEC 1979

MINE MANAGER: *[Signature]*

MINE SURVEYOR: *[Signature]*

0055_238



SCALE SHOWING 1:500 METRES AND EQUIVALENT FEET

ELECTROLYTIC ZINC COMPANY OF AUSTRALASIA LIMITED
WEST COAST MINES, TAS.

SURVEY BY	
DRAWN BY	A. G. MORRISON
TRACED BY	A. G. M.

SCALE	1:500
DATE	19-01-79
REFERENCE	

ROSEBERY MINE
LONGITUDINAL PROJECTION
'H' LENS. H/W STOPE
50m S-550mN BELOW 15 LEVEL

79032

DRAWING NO: _____
DEPARTMENT OF MINES