


0055_240

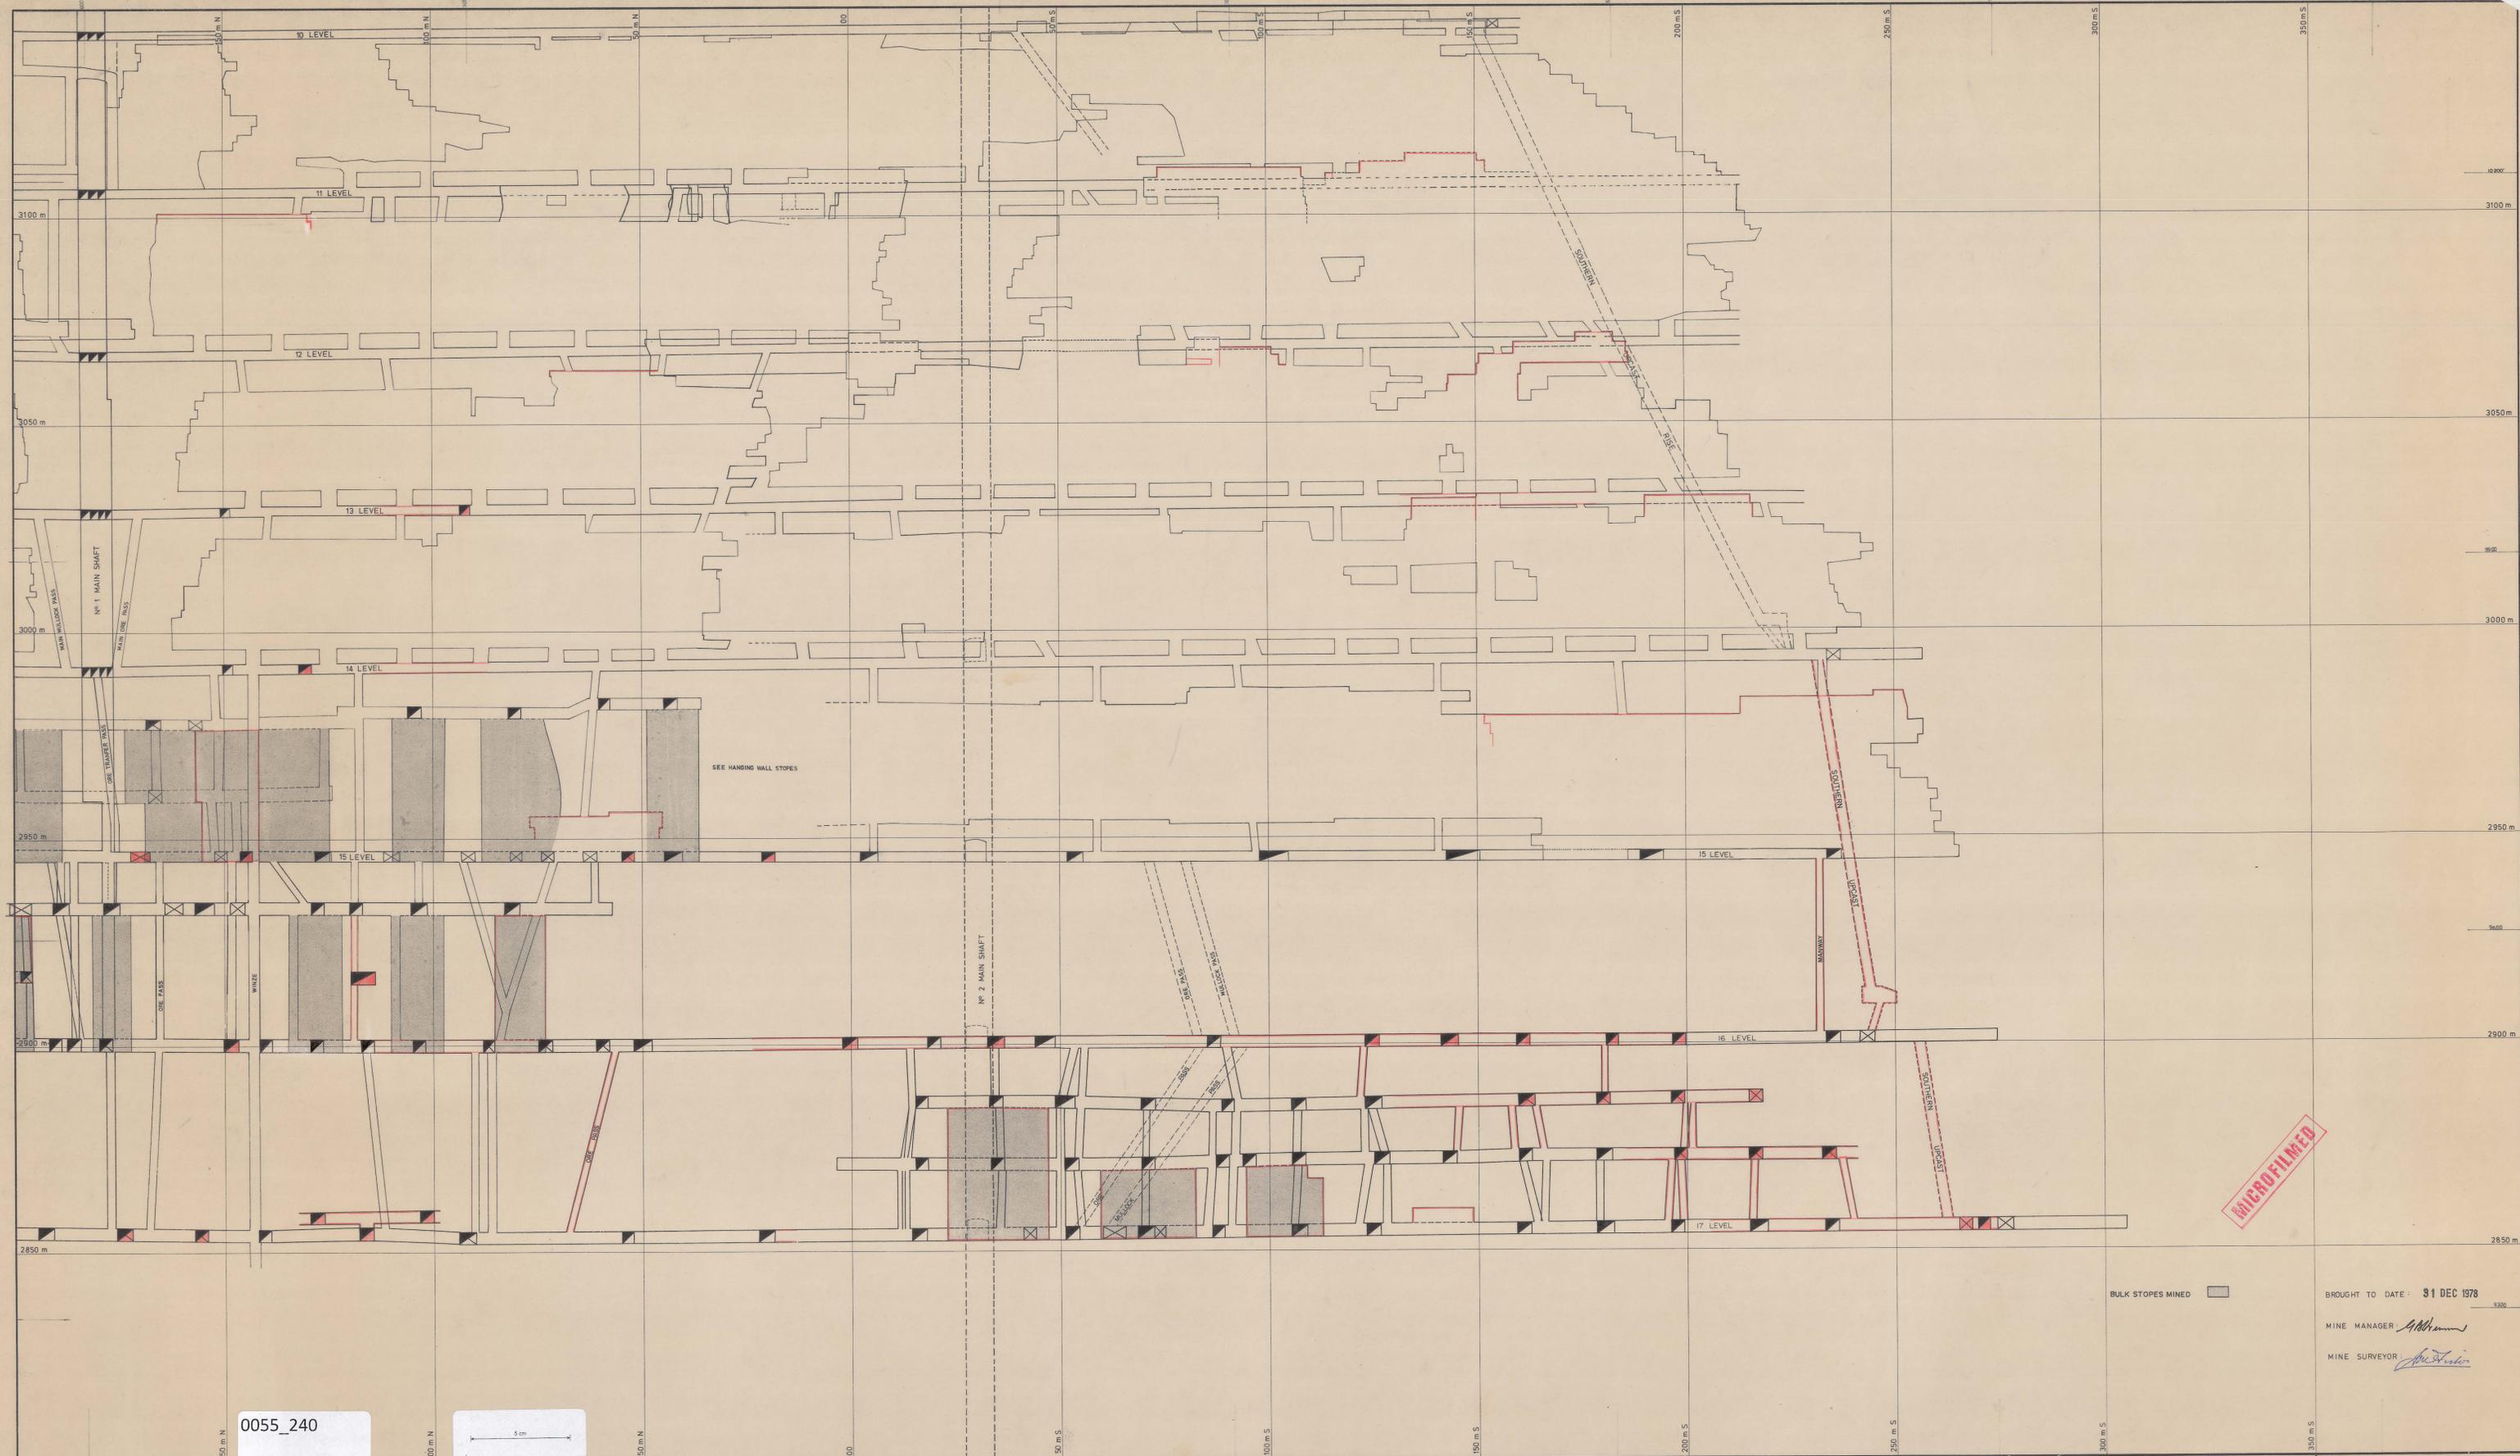

0055_240

5 m


MICROFILMED

BULK STOPES MINED

BROUGHT TO DATE: 31 DEC 1978

MINE MANAGER: *Adams*

MINE SURVEYOR: *McIntosh*

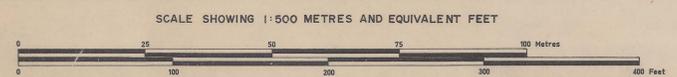

ELECTROLYTIC ZINC COMPANY OF AUSTRALASIA LIMITED
WEST COAST MINES, T.A.S.

SURVEY BY		SCALE	1:500 metres
DRAWN BY		DATE	1973
TRACED BY	S.M. Burrows	REFERENCE	

ROSEBERY MINE
LONGITUDINAL PROJECTION
400m S-200m N — BELOW 10/L

79030

DRAWING NO: _____
DEPARTMENT OF MINES