



0055\_241



0055\_241

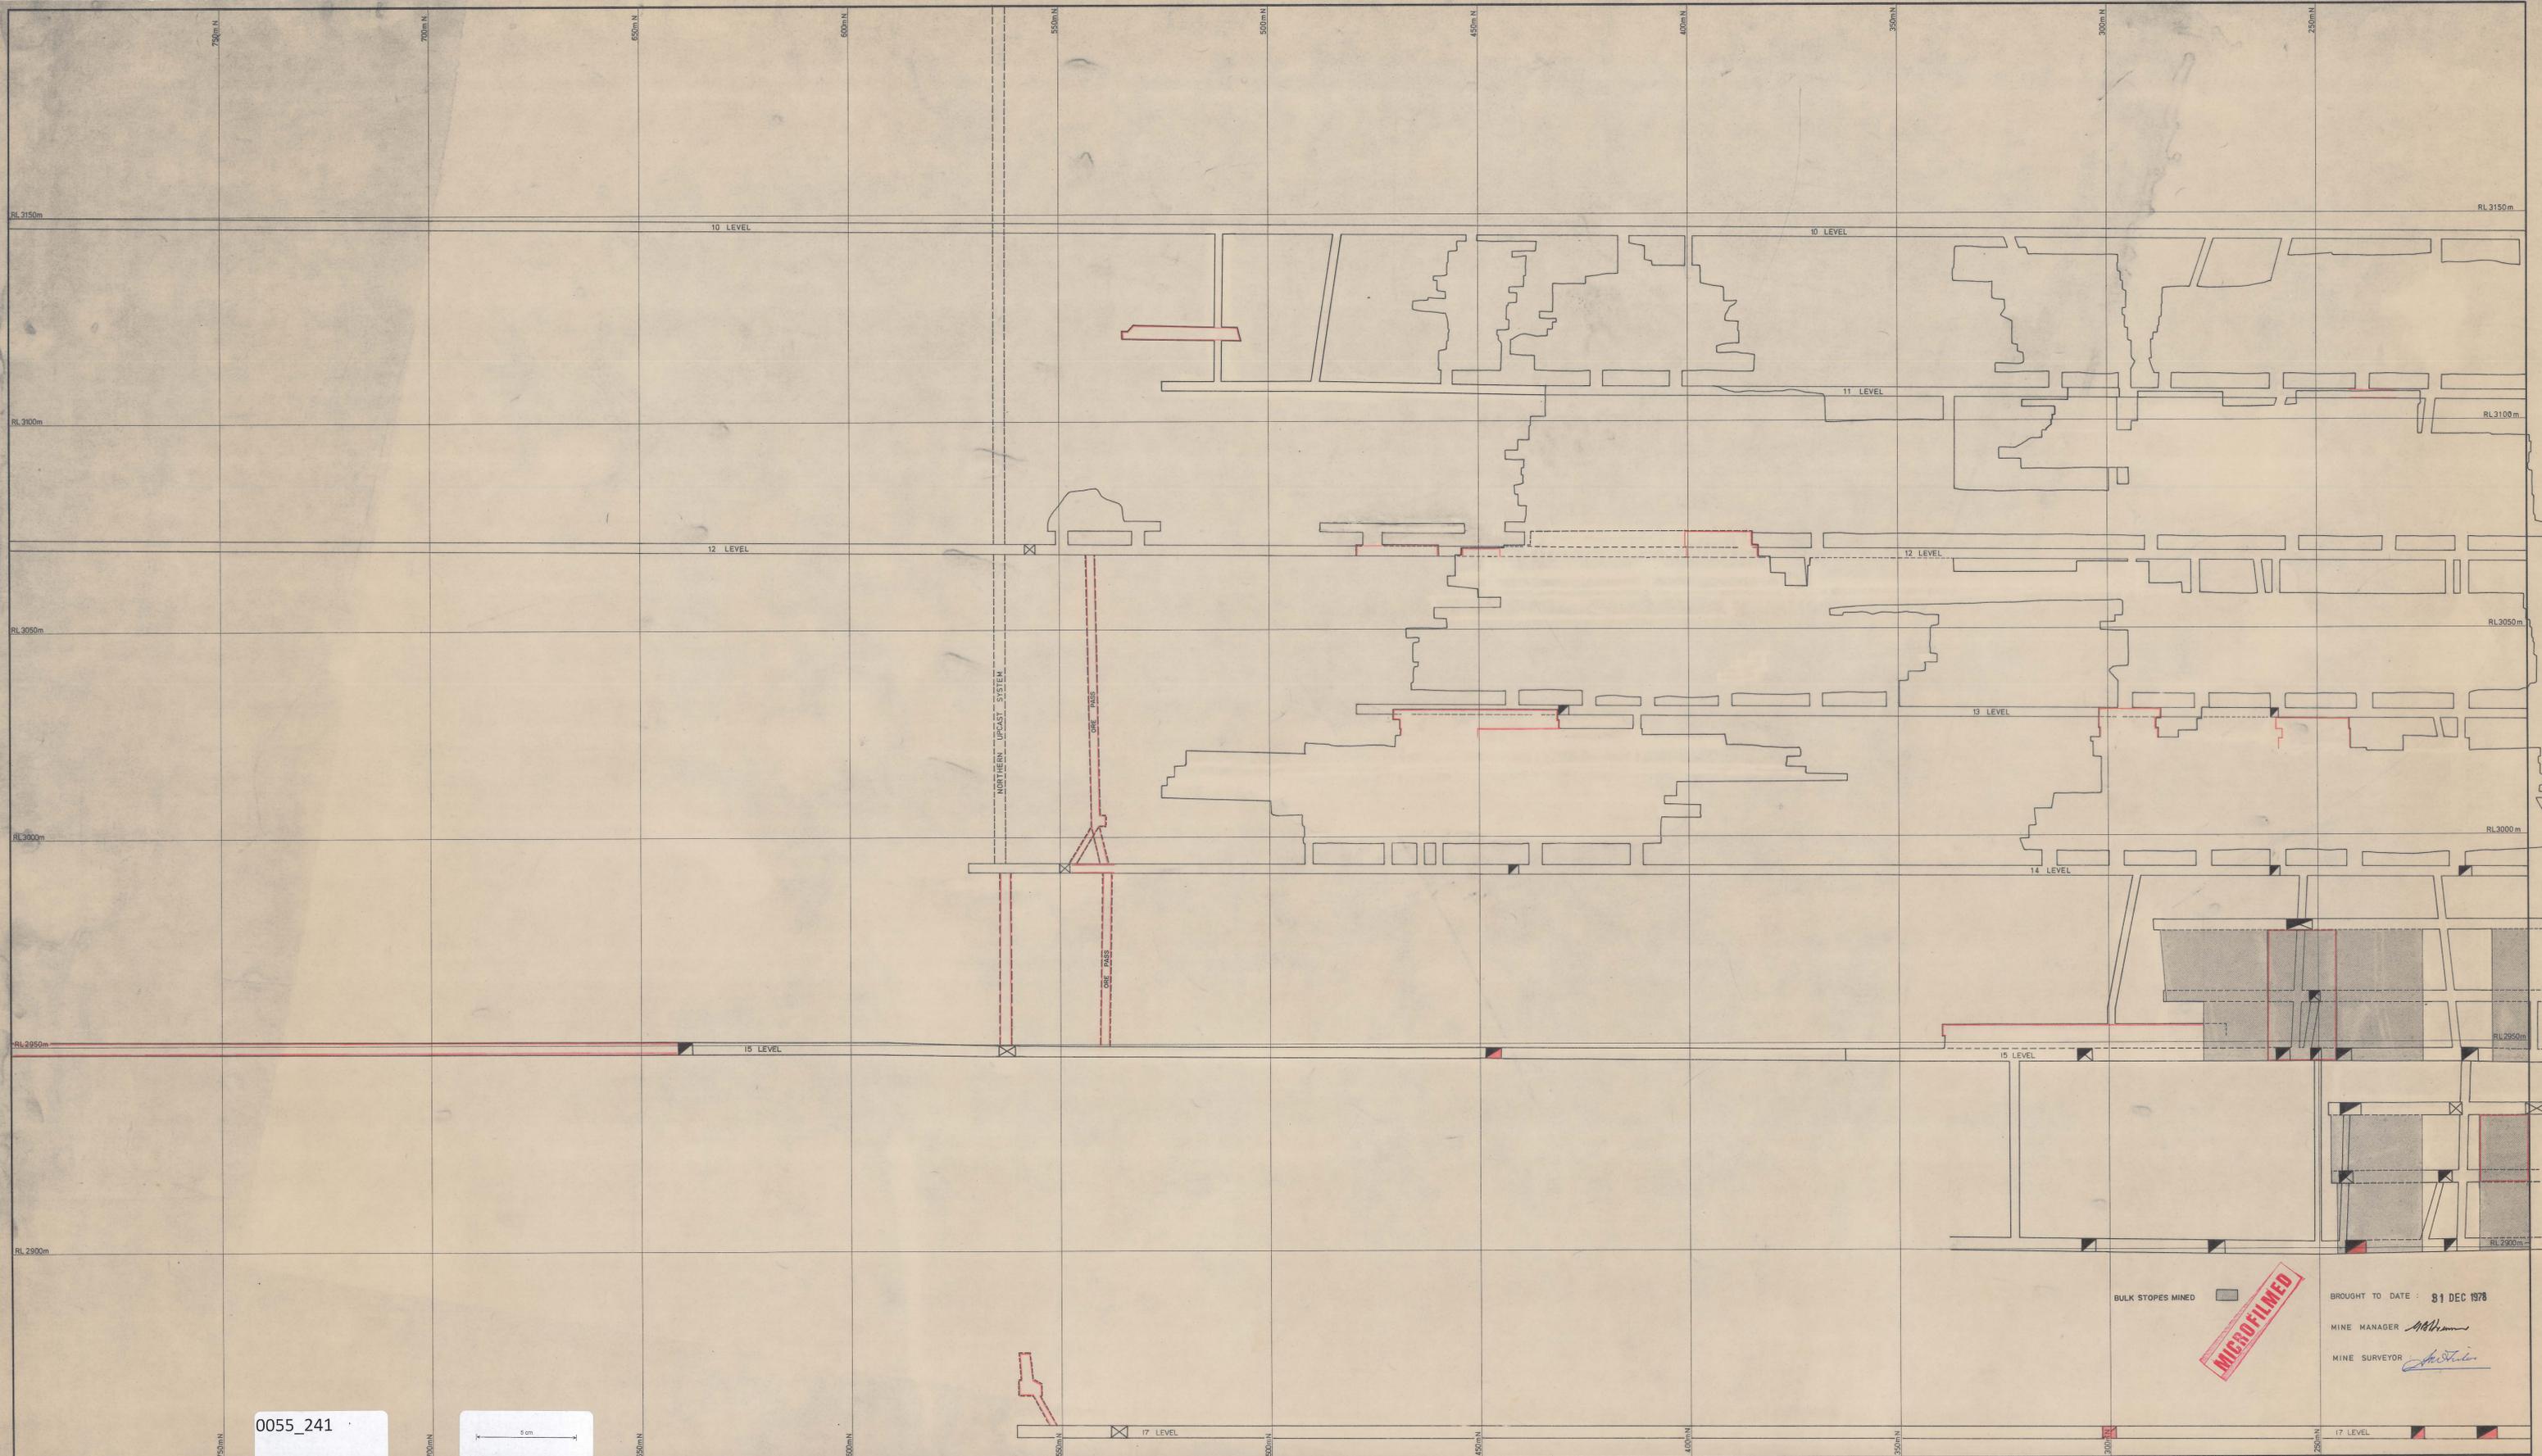

SCALE SHOWING 1:500 METRES AND EQUIVALENT FEET

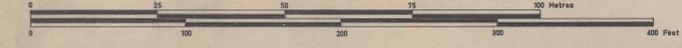

**ELECTROLYTIC ZINC COMPANY OF AUSTRALASIA LIMITED**  
 WEST COAST MINES, TAS.

SURVEY BY		SCALE	1 : 500
DRAWN BY		DATE	1973
TRACED BY	P. J. Lowe	REFERENCE	

ROSEBERY MINE  
 LONGITUDINAL PROJECTION  
 200mN - 800mN — BELOW 10/L.

19029

BULK STOPES MINED

**MICROFILMED**

BROUGHT TO DATE : 31 DEC 1978  
 MINE MANAGER *M. Brown*  
 MINE SURVEYOR *J. Stirling*

DRAWING NO :  
 DEPARTMENT OF MINES