


0055\_242



0055\_242

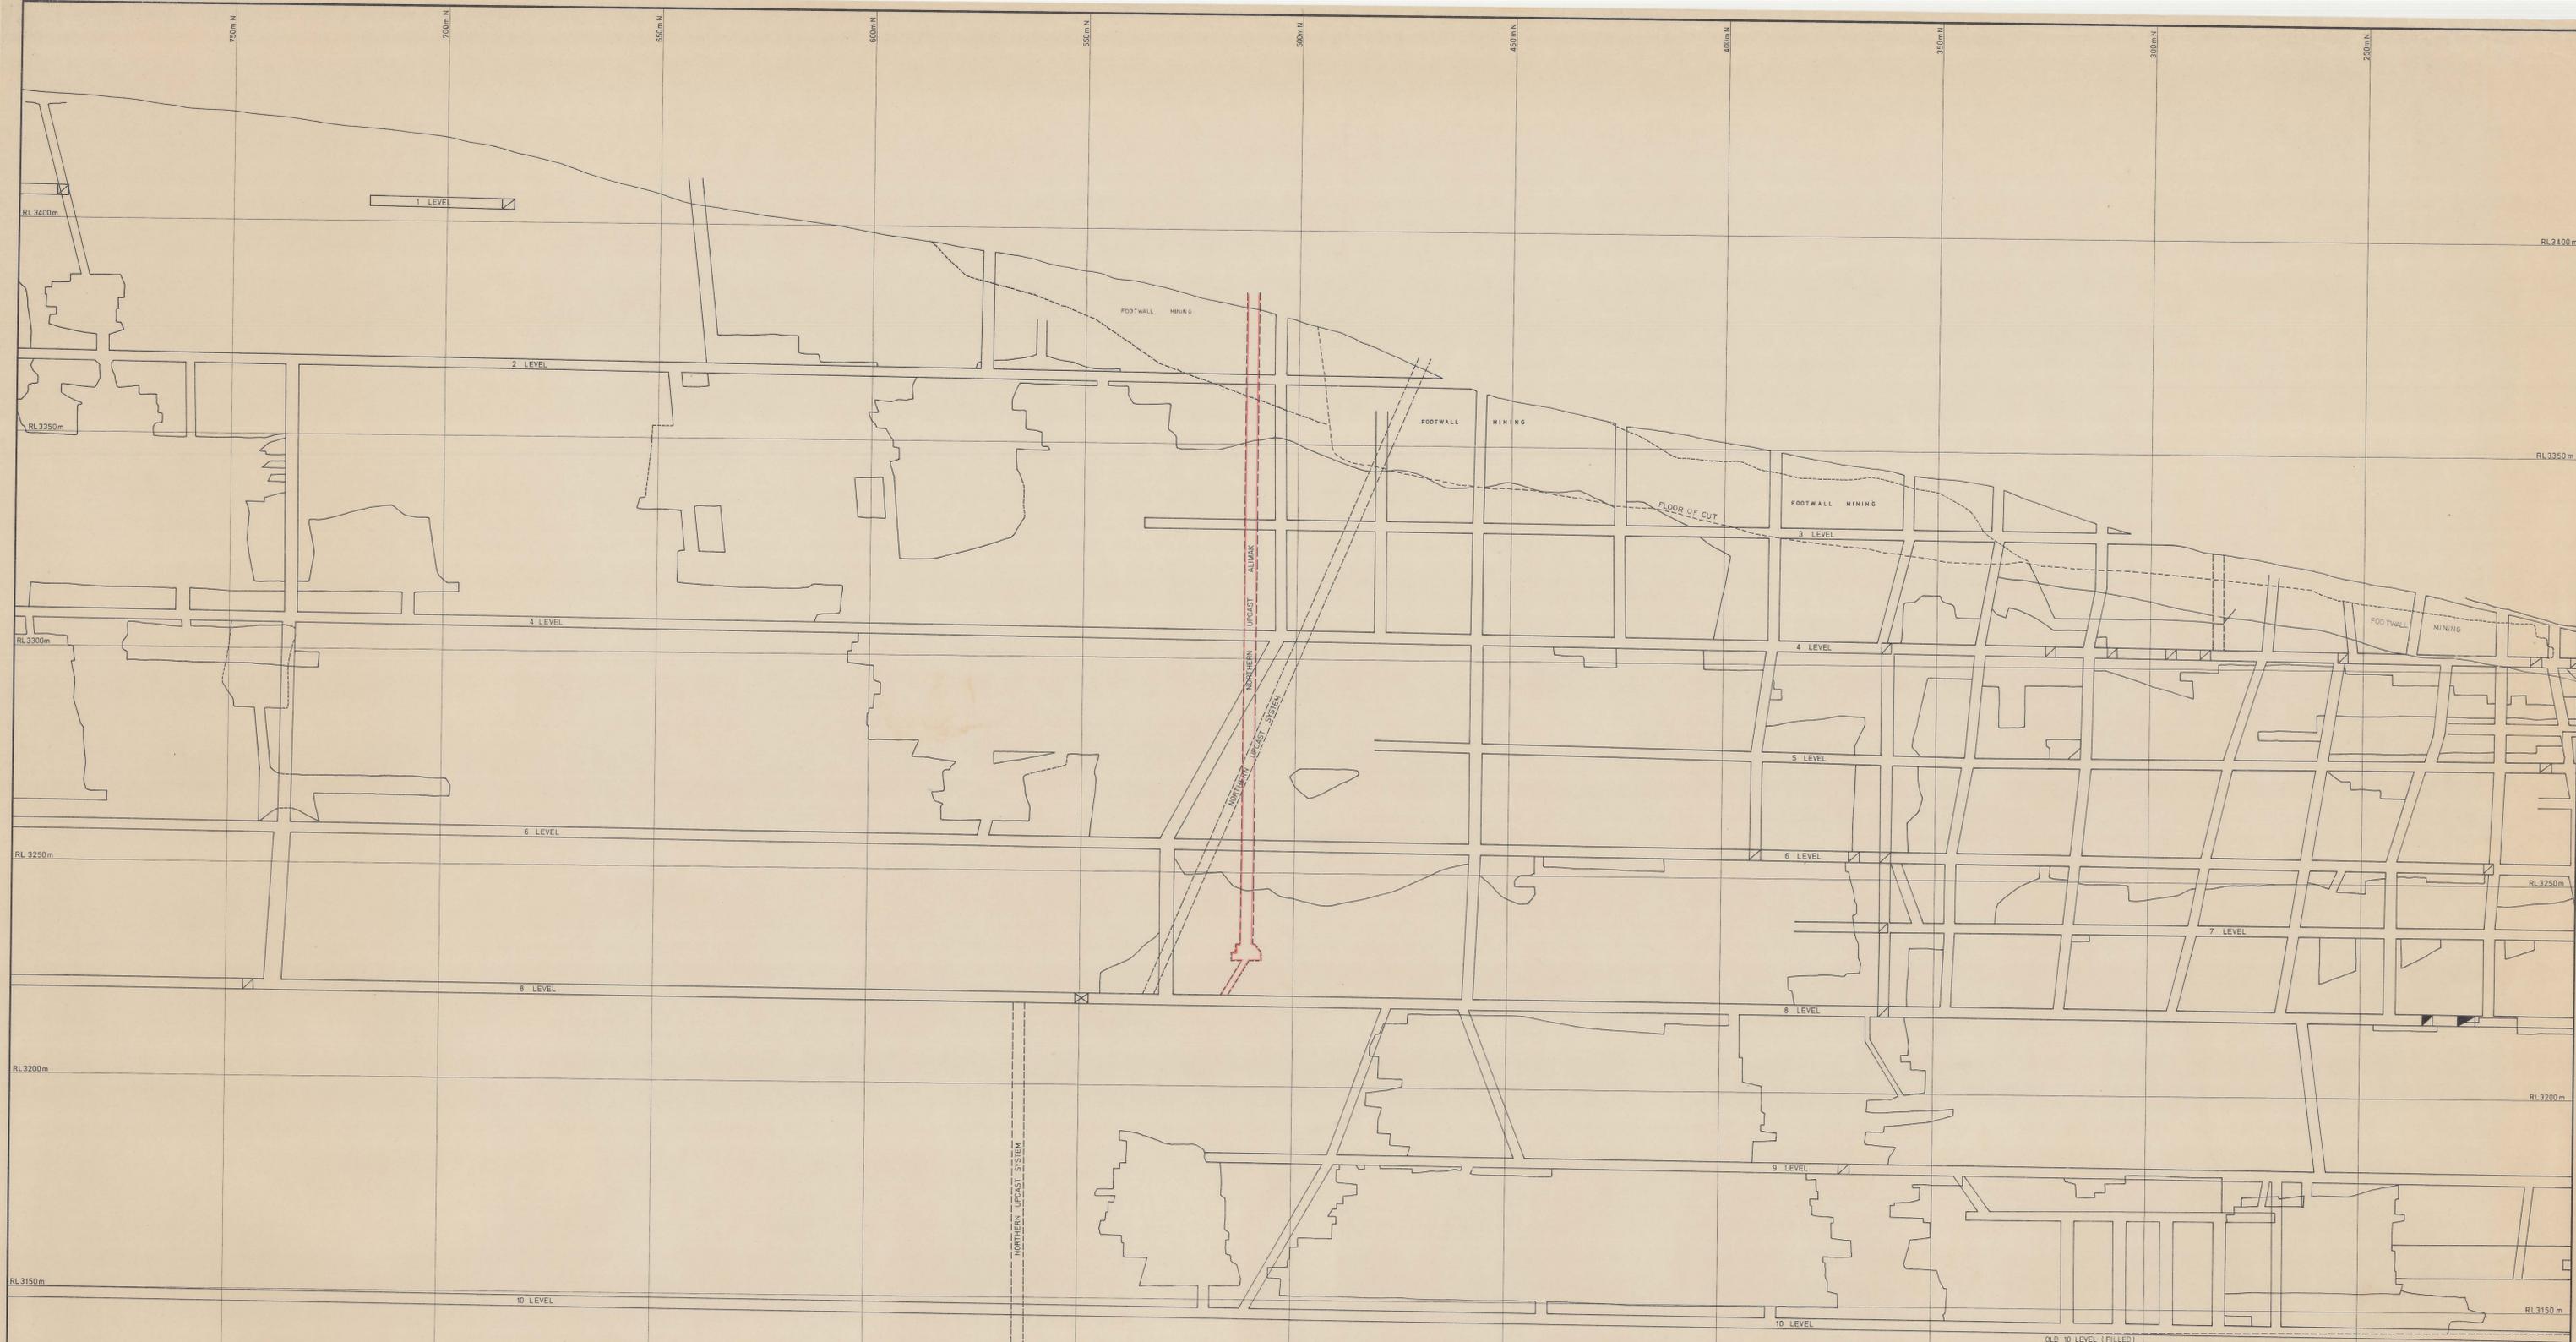

**ELECTROLYTIC ZINC COMPANY OF AUSTRALASIA LIMITED**  
 WEST COAST MINES, T.A.S.

SURVEY BY		SCALE	1 : 500
DRAWN BY		DATE	1973
TRACED BY	P. J. Lowe	REFERENCE	

ROSEBERY MINE  
 LONGITUDINAL PROJECTION  
 200mN-800mN — ABOVE 10/L.

19028

BROUGHT TO DATE 31 DEC 1976  
 MINE MANAGER *McMinn*  
 MINE SURVEYOR *Spencer*

MICROFILMED

DRAWING N<sup>o</sup>:  
 DEPARTMENT OF MINES