


0055\_243



0055\_243

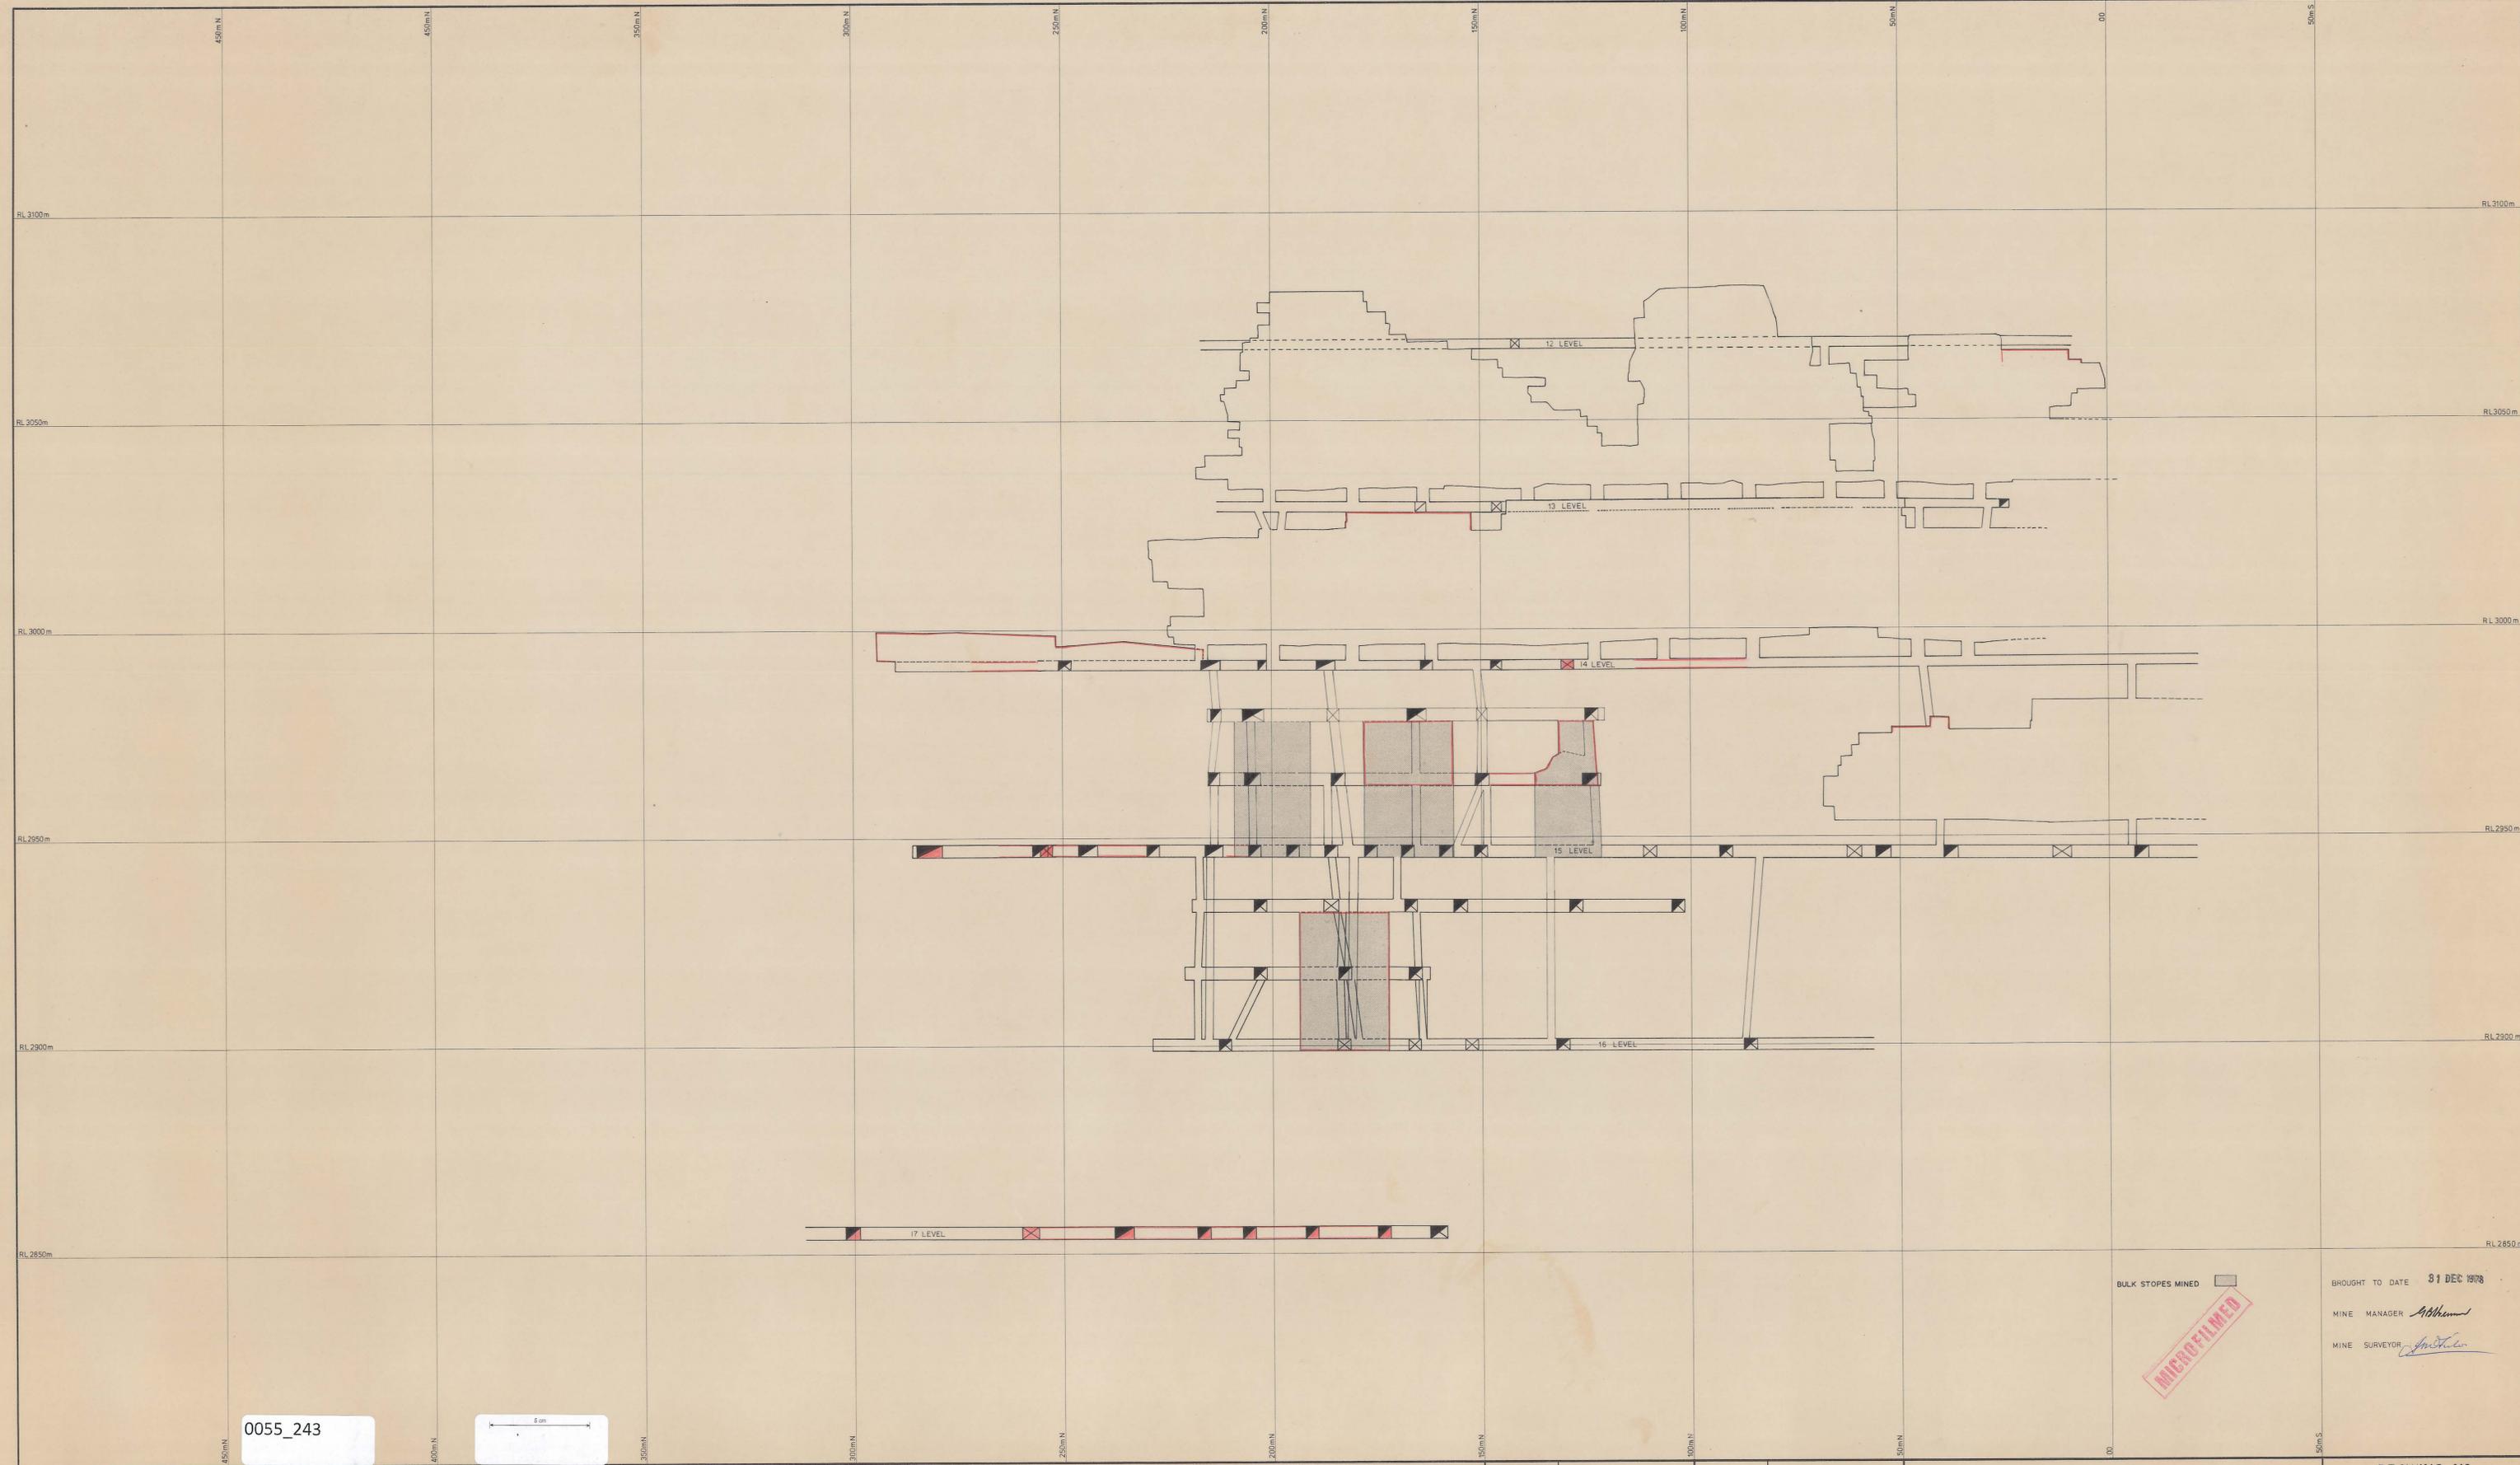

BULK STOPES MINED

**MICROFILMED**

BROUGHT TO DATE 31 DEC 1978

MINE MANAGER *Althman*

MINE SURVEYOR *Smith*

SCALE SHOWING 1:500 METRES AND EQUIVALENT FEET

0 25 50 75 100 Metres

0 100 200 300 400 Feet

ELECTROLYTIC ZINC COMPANY OF AUSTRALASIA LIMITED

WEST COAST MINES, T.A.S.

SURVEY BY		SCALE	1:500
DRAWN BY		DATE	1973
TRACED BY	P.J. Lowe	REFERENCE	

ROSEBERY MINE

LONGITUDINAL PROJECTION

H.W. STOPES

79027

DRAWING NO.:

DEPARTMENT OF MINES