



0055_244

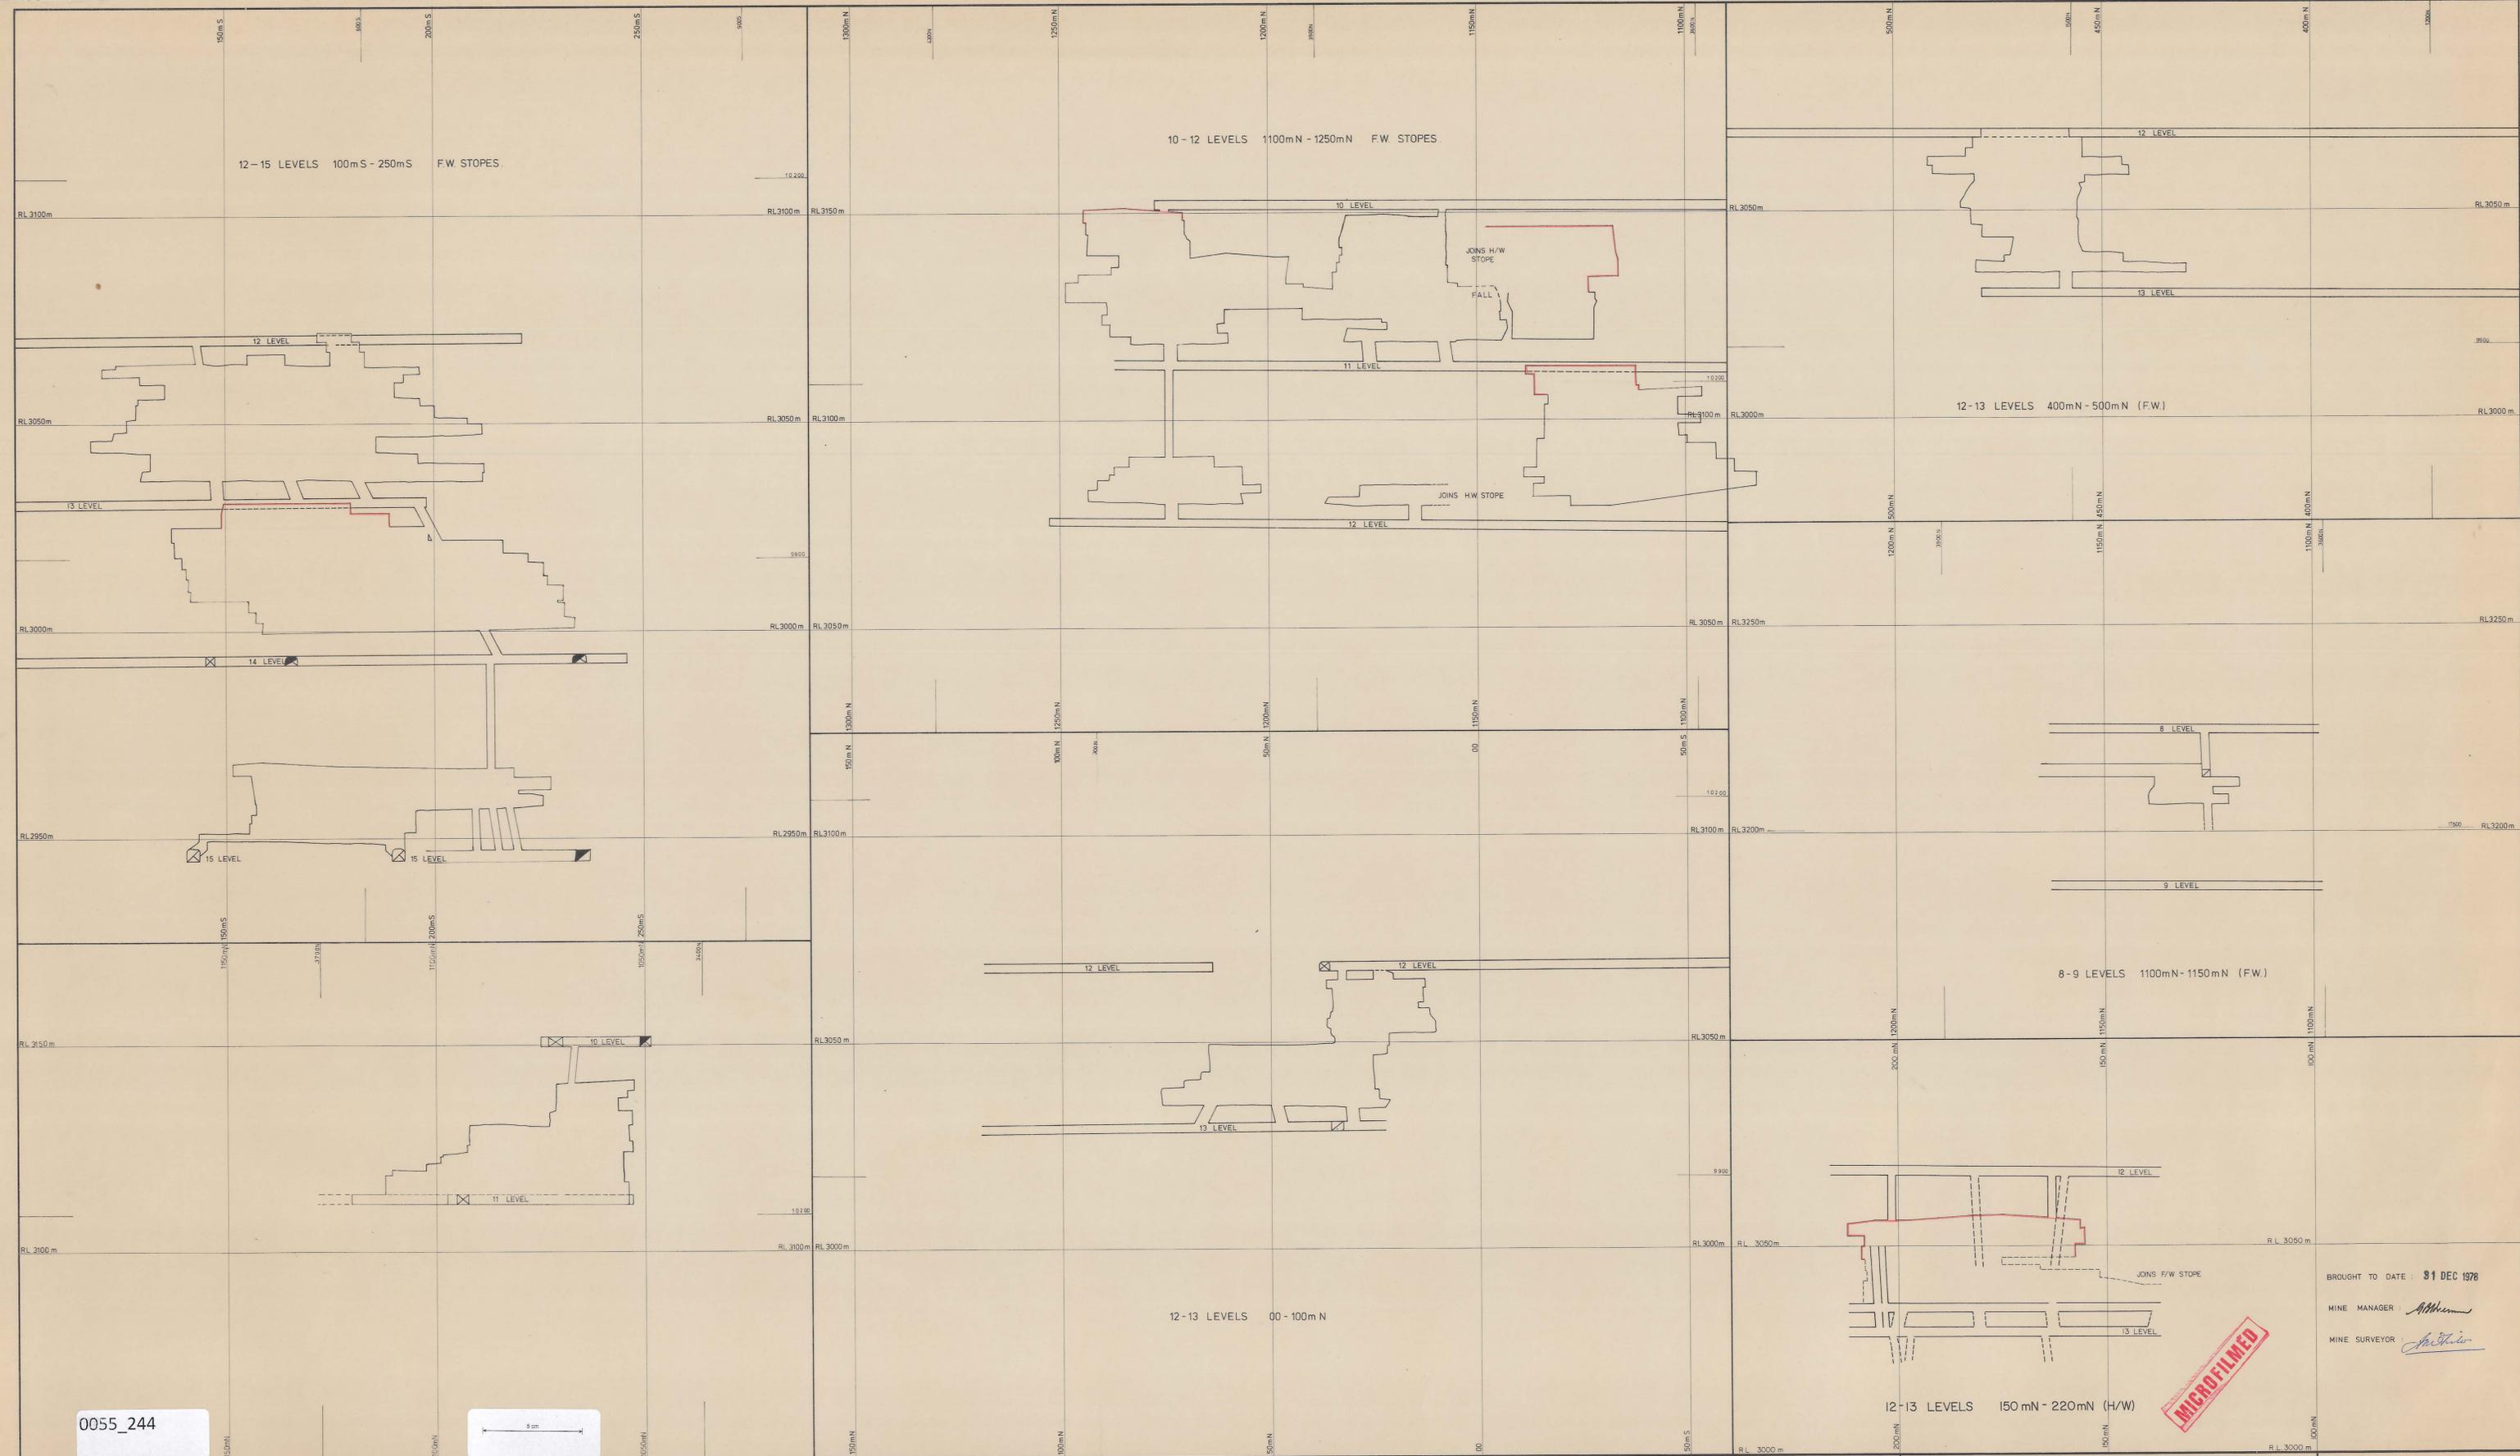

0055_244

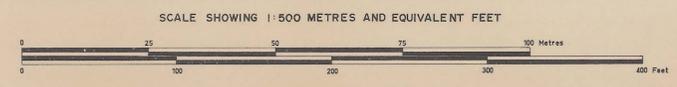

ELECTROLYTIC ZINC COMPANY OF AUSTRALASIA LIMITED
WEST COAST MINES, T.A.S.

SURVEY BY	SCALE	1 : 500
DRAWN BY	DATE	1973
TRACED BY P. J. Lowe	REFERENCE	

ROSEBERY MINE
LONGITUDINAL PROJECTION
SPECIFIC STOPES.

MICROFILMED

79026

BROUGHT TO DATE : 31 DEC 1978
MINE MANAGER : *Atkins*
MINE SURVEYOR : *J. J. Lowe*

DRAWING N° :
DEPARTMENT OF MINES