



0055_245

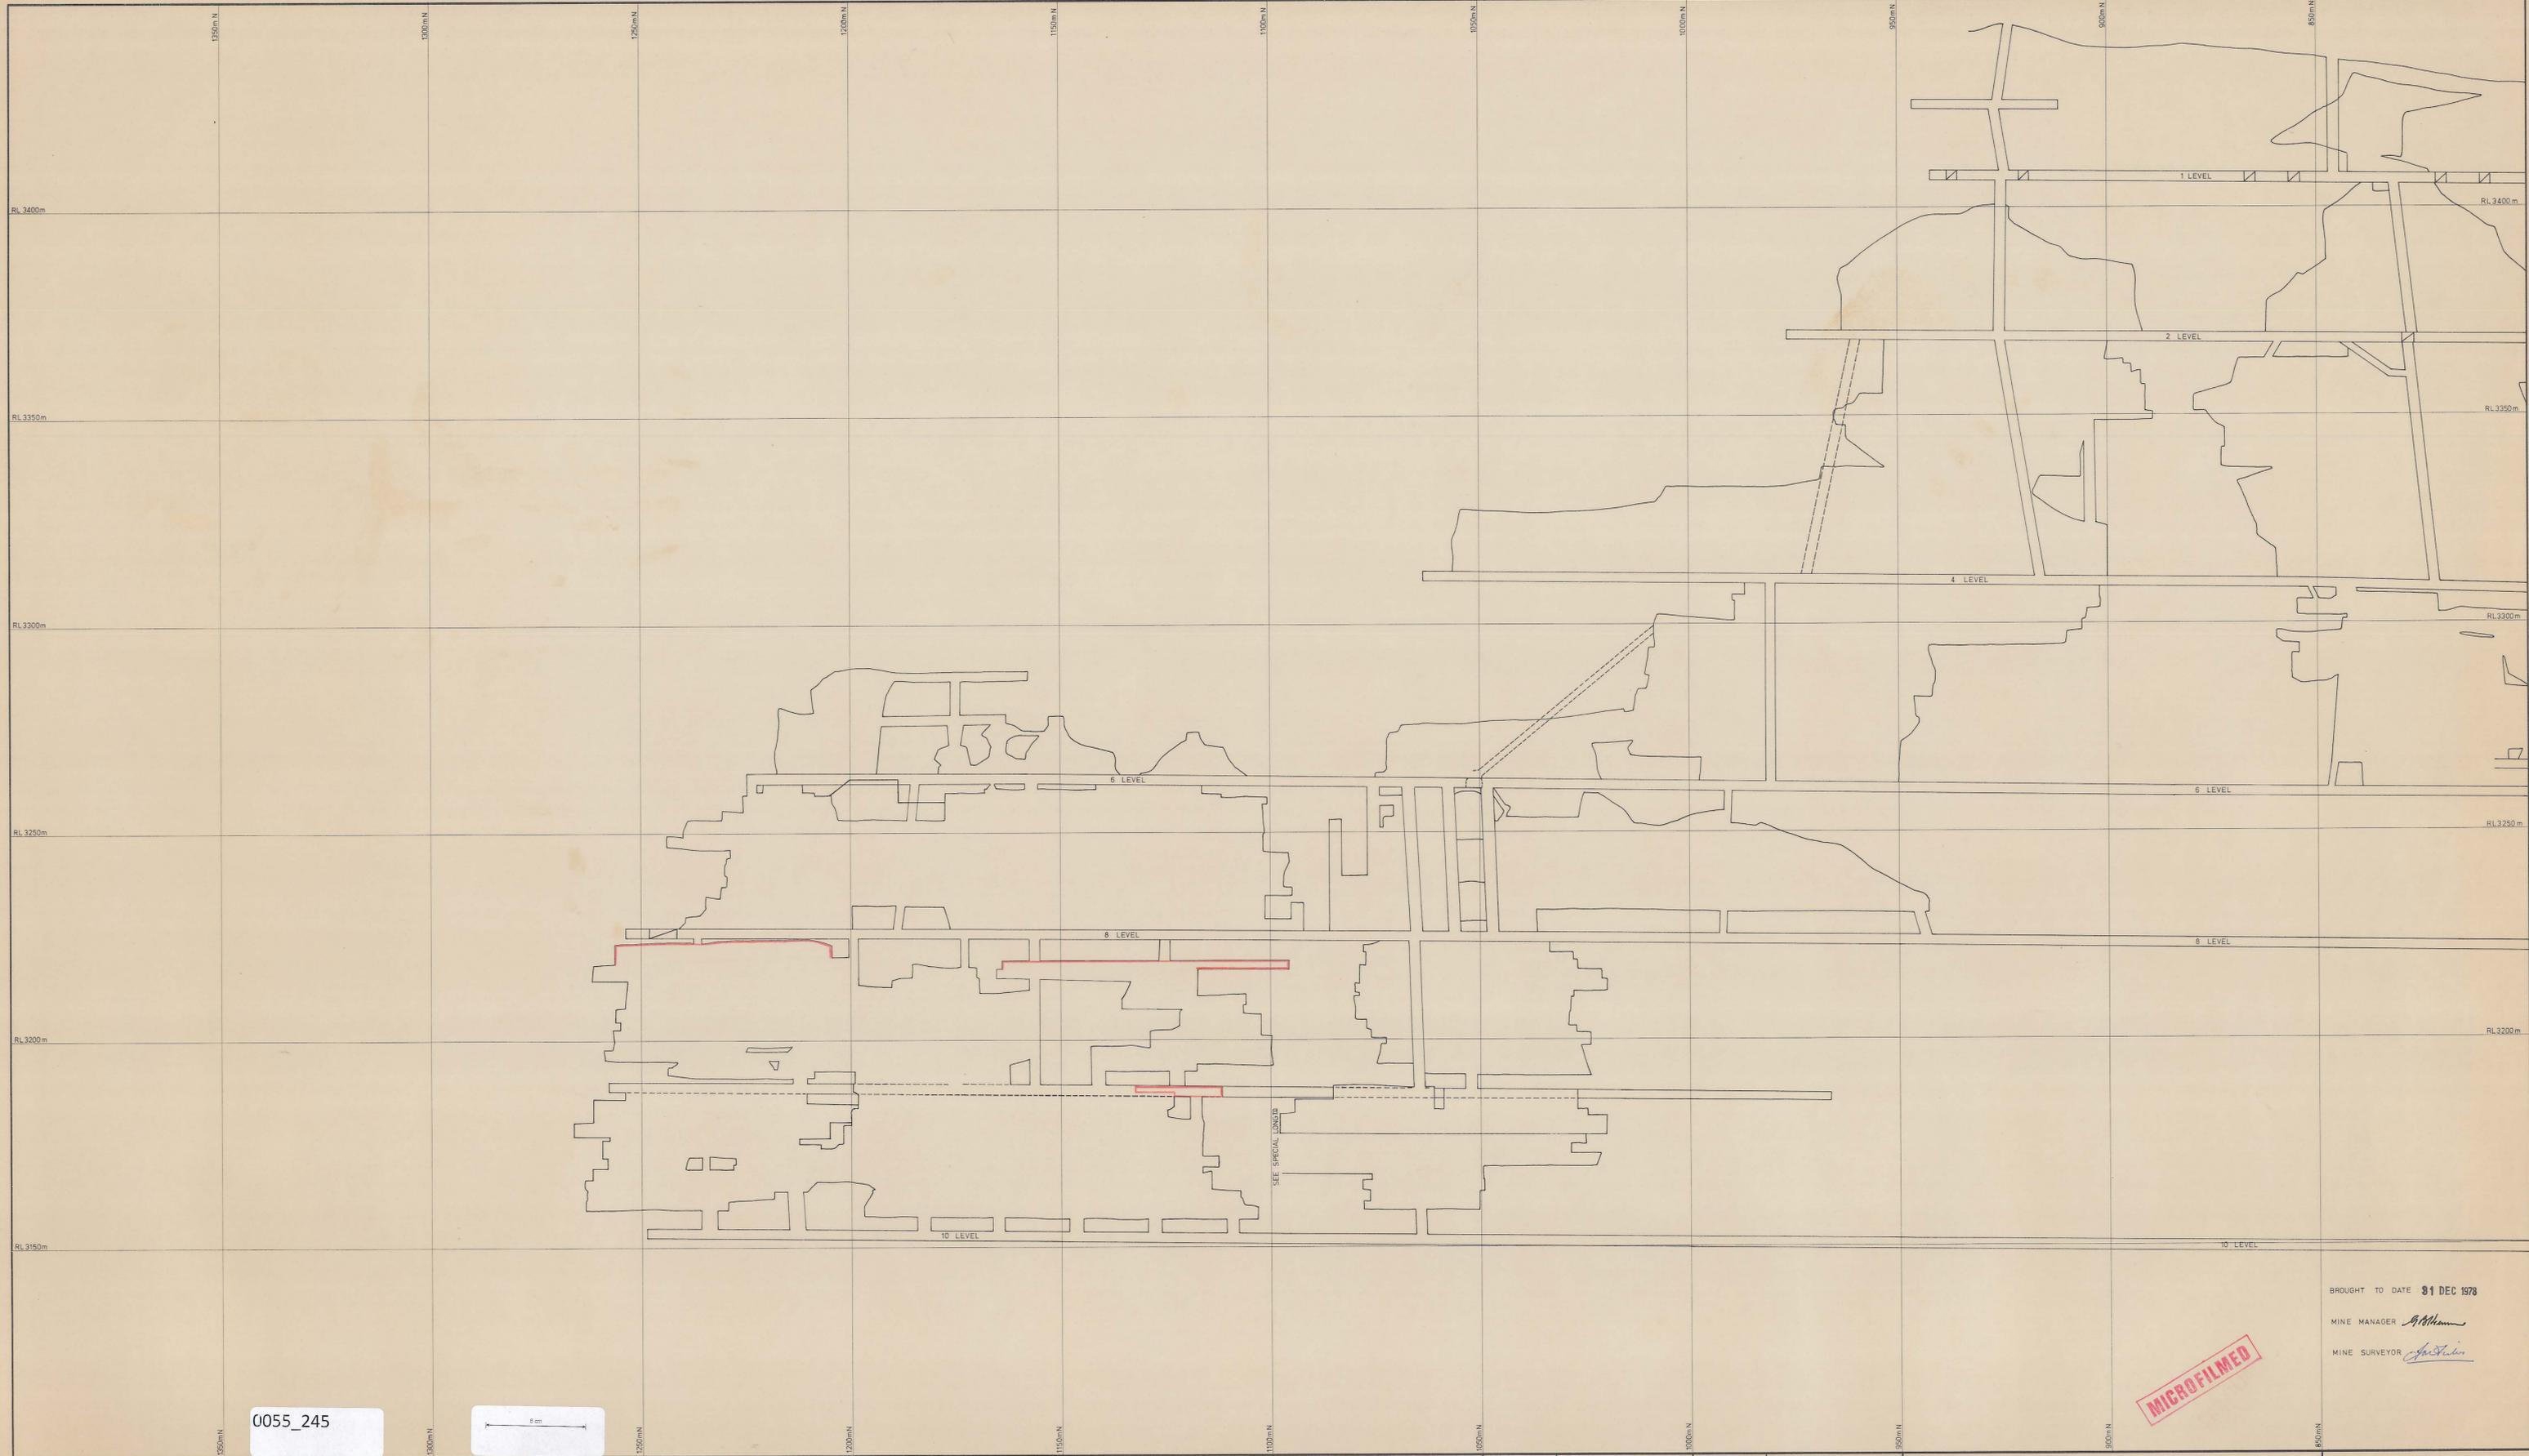

0055_245

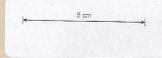

SCALE SHOWING 1:500 METRES AND EQUIVALENT FEET

ELECTROLYTIC ZINC COMPANY OF AUSTRALASIA LIMITED
 WEST COAST MINES, T.A.S.

SURVEY BY		SCALE	1:500
DRAWN BY		DATE	1973
TRACED BY	P.J. Lowe	REFERENCE	

ROSEBERY MINE
 LONGITUDINAL PROJECTION
 NORTH END — ABOVE 10/L.

MICRO FILMED

BROUGHT TO DATE **31 DEC 1978**
 MINE MANAGER *B. Williams*
 MINE SURVEYOR *A. Williams*

DRAWING NO: **74025**
 DEPARTMENT OF MINES