

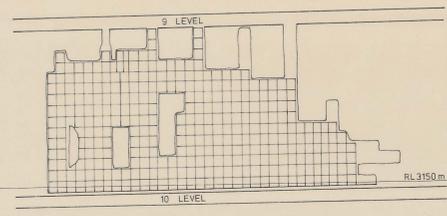


0055\_246

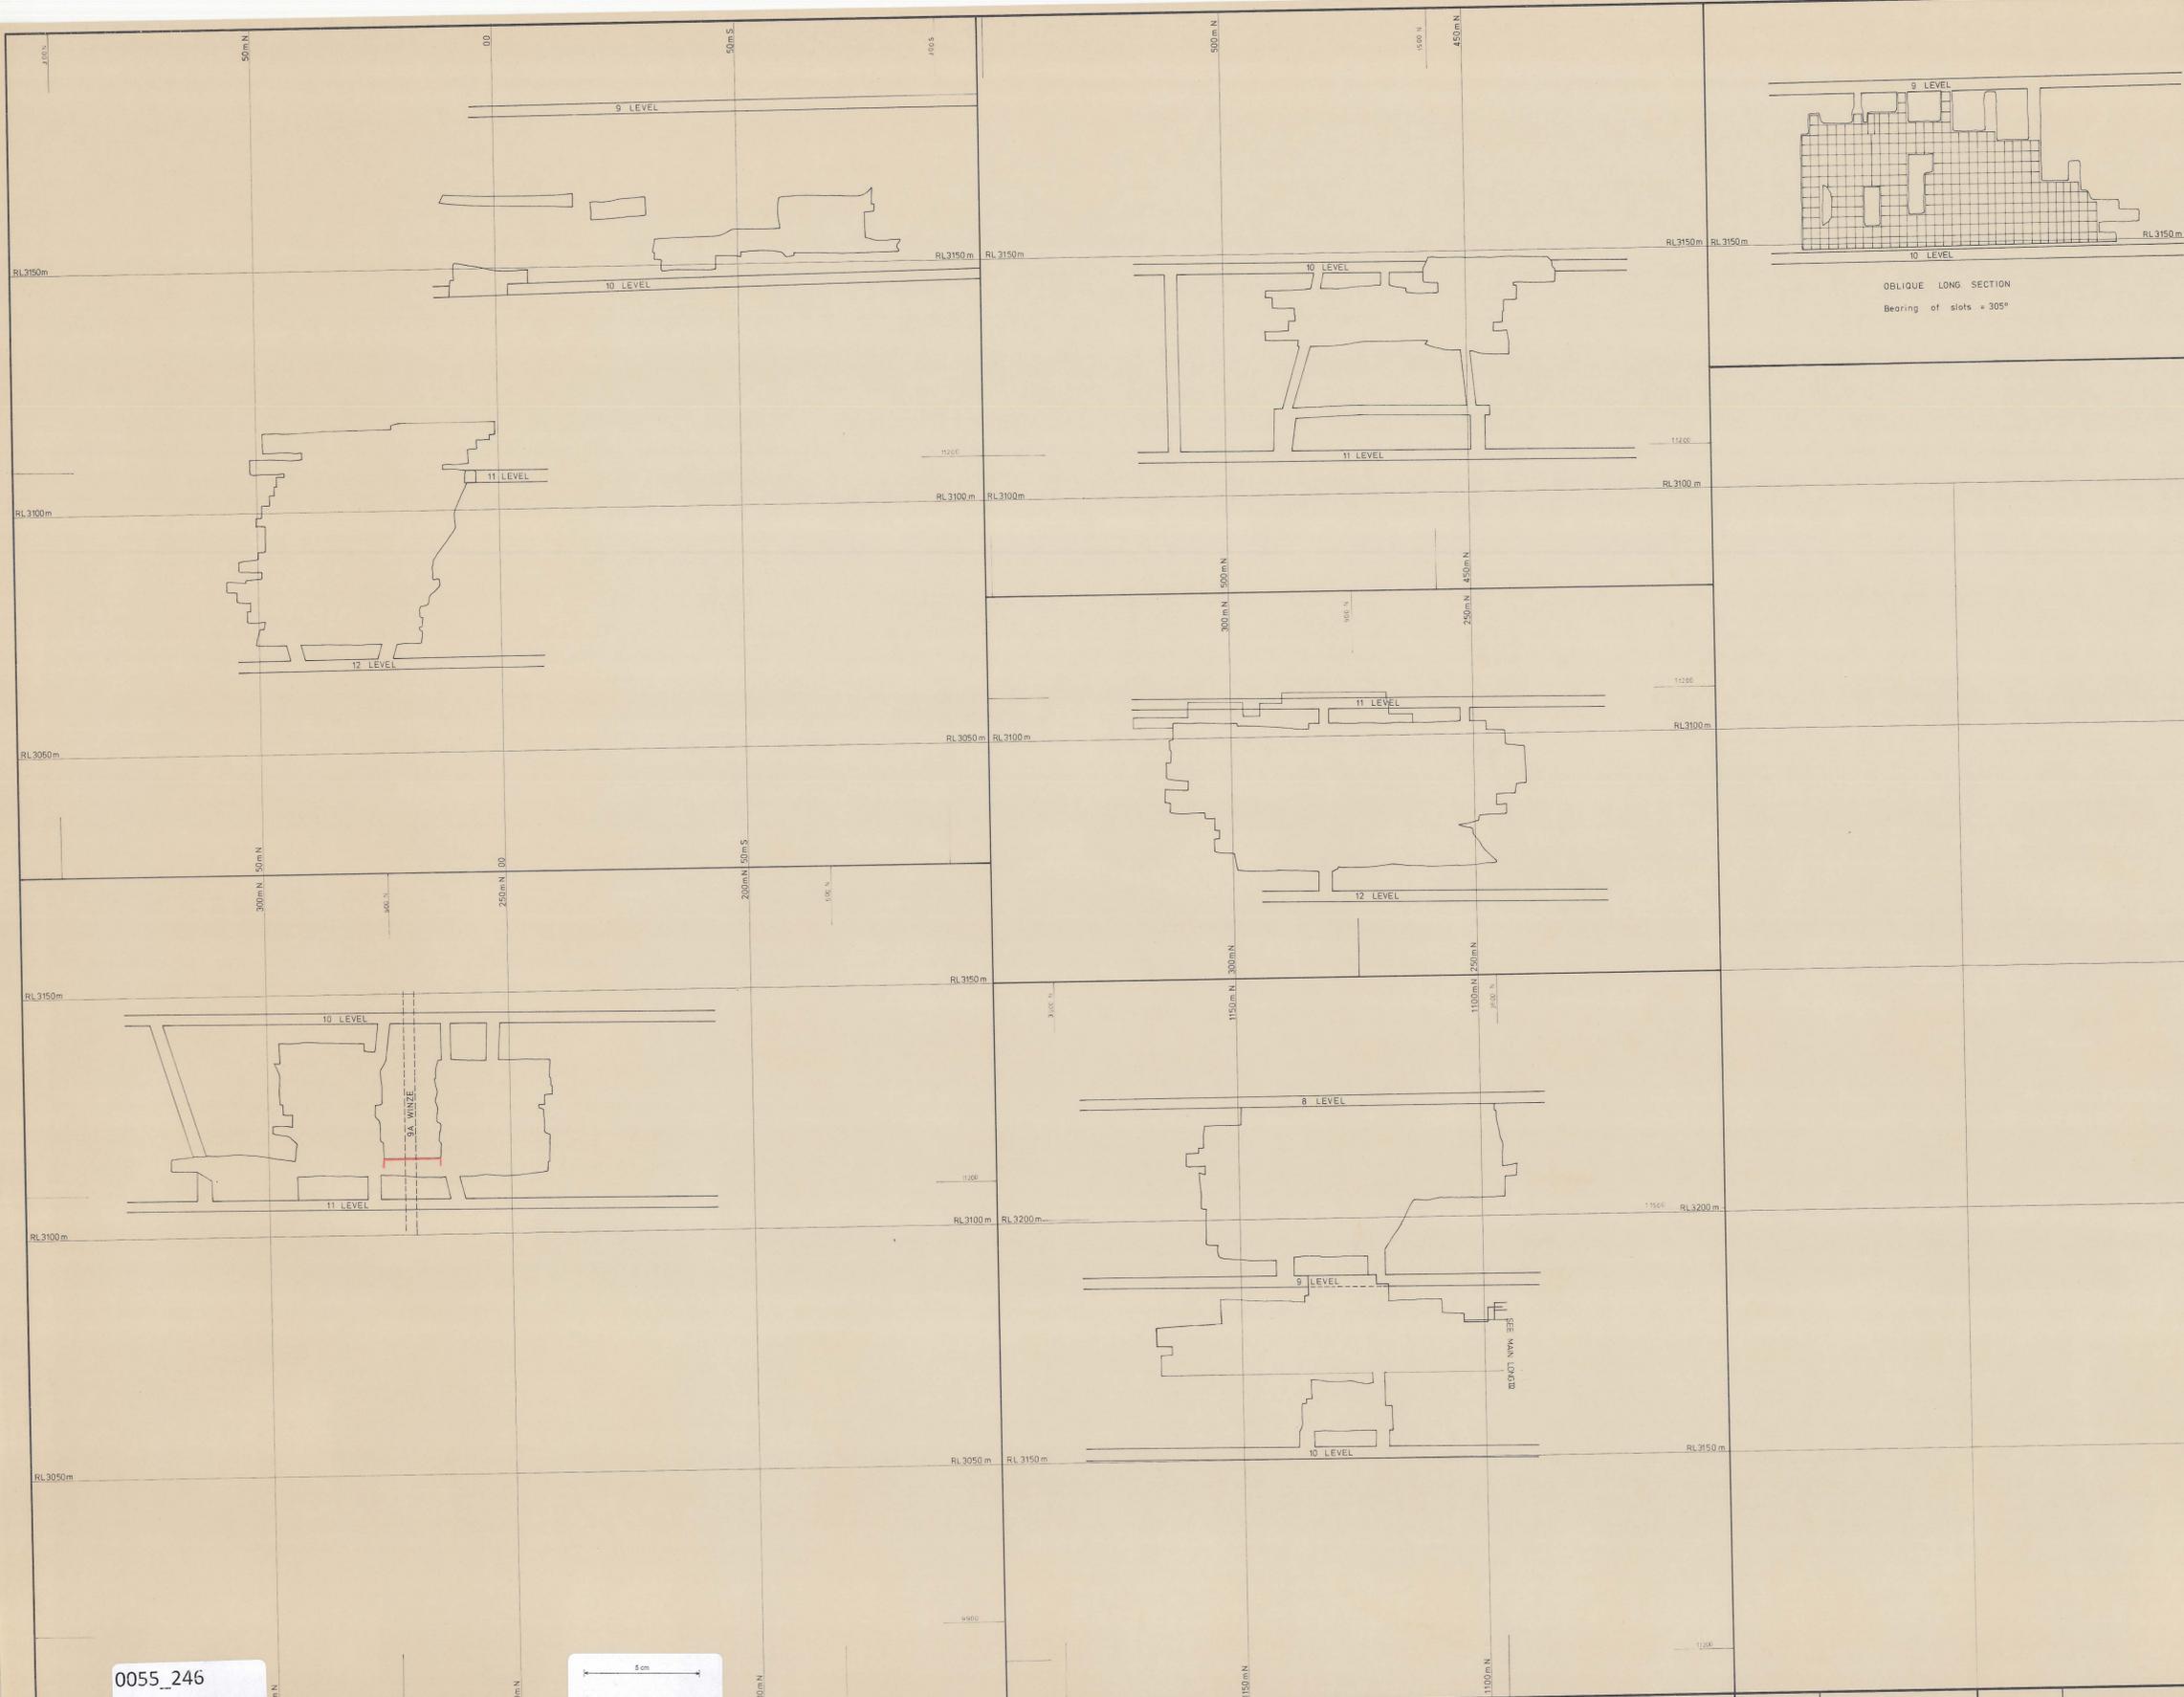

OBLIQUE LONG SECTION  
Bearing of slots = 305°

0055\_246

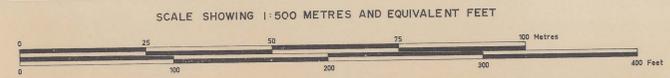

ELECTROLYTIC ZINC COMPANY OF AUSTRALASIA LIMITED  
WEST COAST MINES, TAS.

SURVEY BY		SCALE	1 500
DRAWN BY		DATE	1973
TRACED BY	P. J. Lowe	REFERENCE	

ROSEBERY MINE  
LONGITUDINAL PROJECTION  
SPECIFIC STOPES

79026

BROUGHT TO DATE 31 DEC 1978  
MINE MANAGER *ABH*  
MINE SURVEYOR *AS*

MICROFILMED

DRAWING N°:  
DEPARTMENT OF MINES