



0055\_249

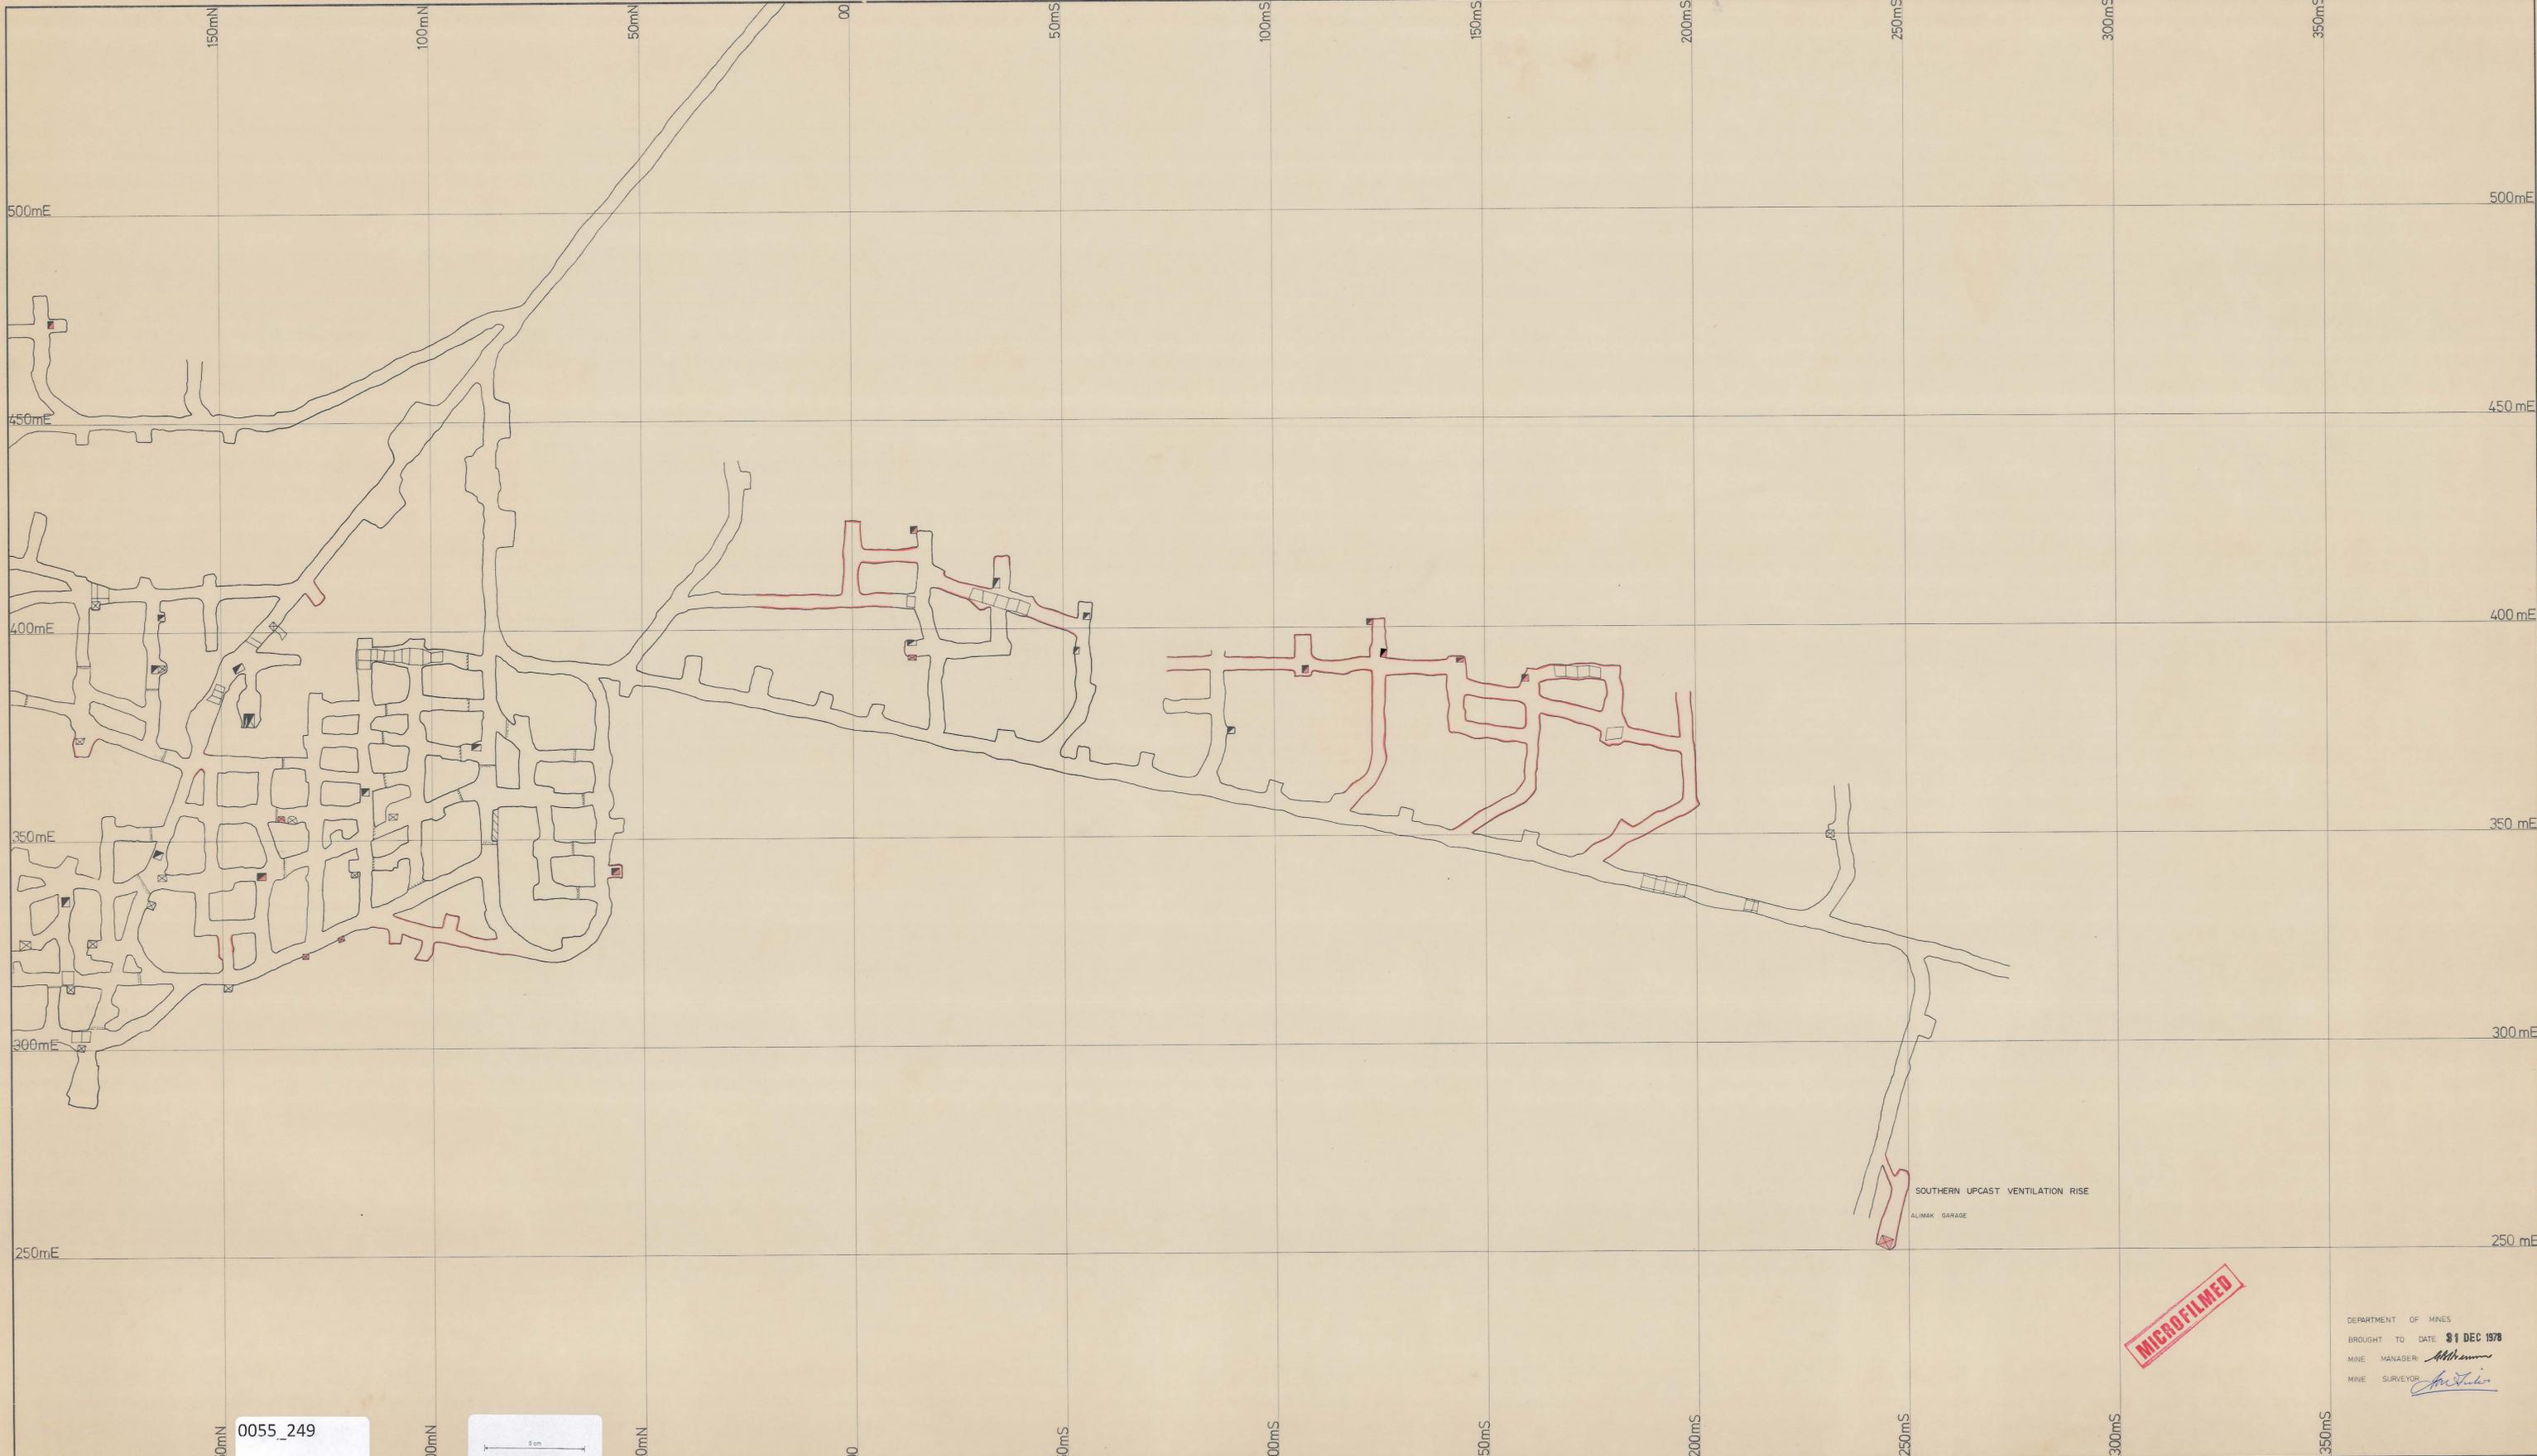

0055\_249

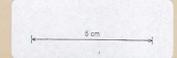

SCALE SHOWING 1:500 METRES AND EQUIVALENT FEET




ELECTROLYTIC ZINC COMPANY OF AUSTRALASIA LIMITED  
WEST COAST MINES, T.A.S.

SURVEY BY	SCALE	1:500
DRAWN BY	DATE	1975
TRACED BY I.T.M.	REFERENCE	

ROSEBERY MINE  
No 16 LEVEL (2)

79021

DRAWING No.:

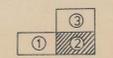

MICROFILMED

DEPARTMENT OF MINES  
BROUGHT TO DATE 31 DEC 1978  
MINE MANAGER *Atherton*  
MINE SURVEYOR *J. J. ...*