



0055_250

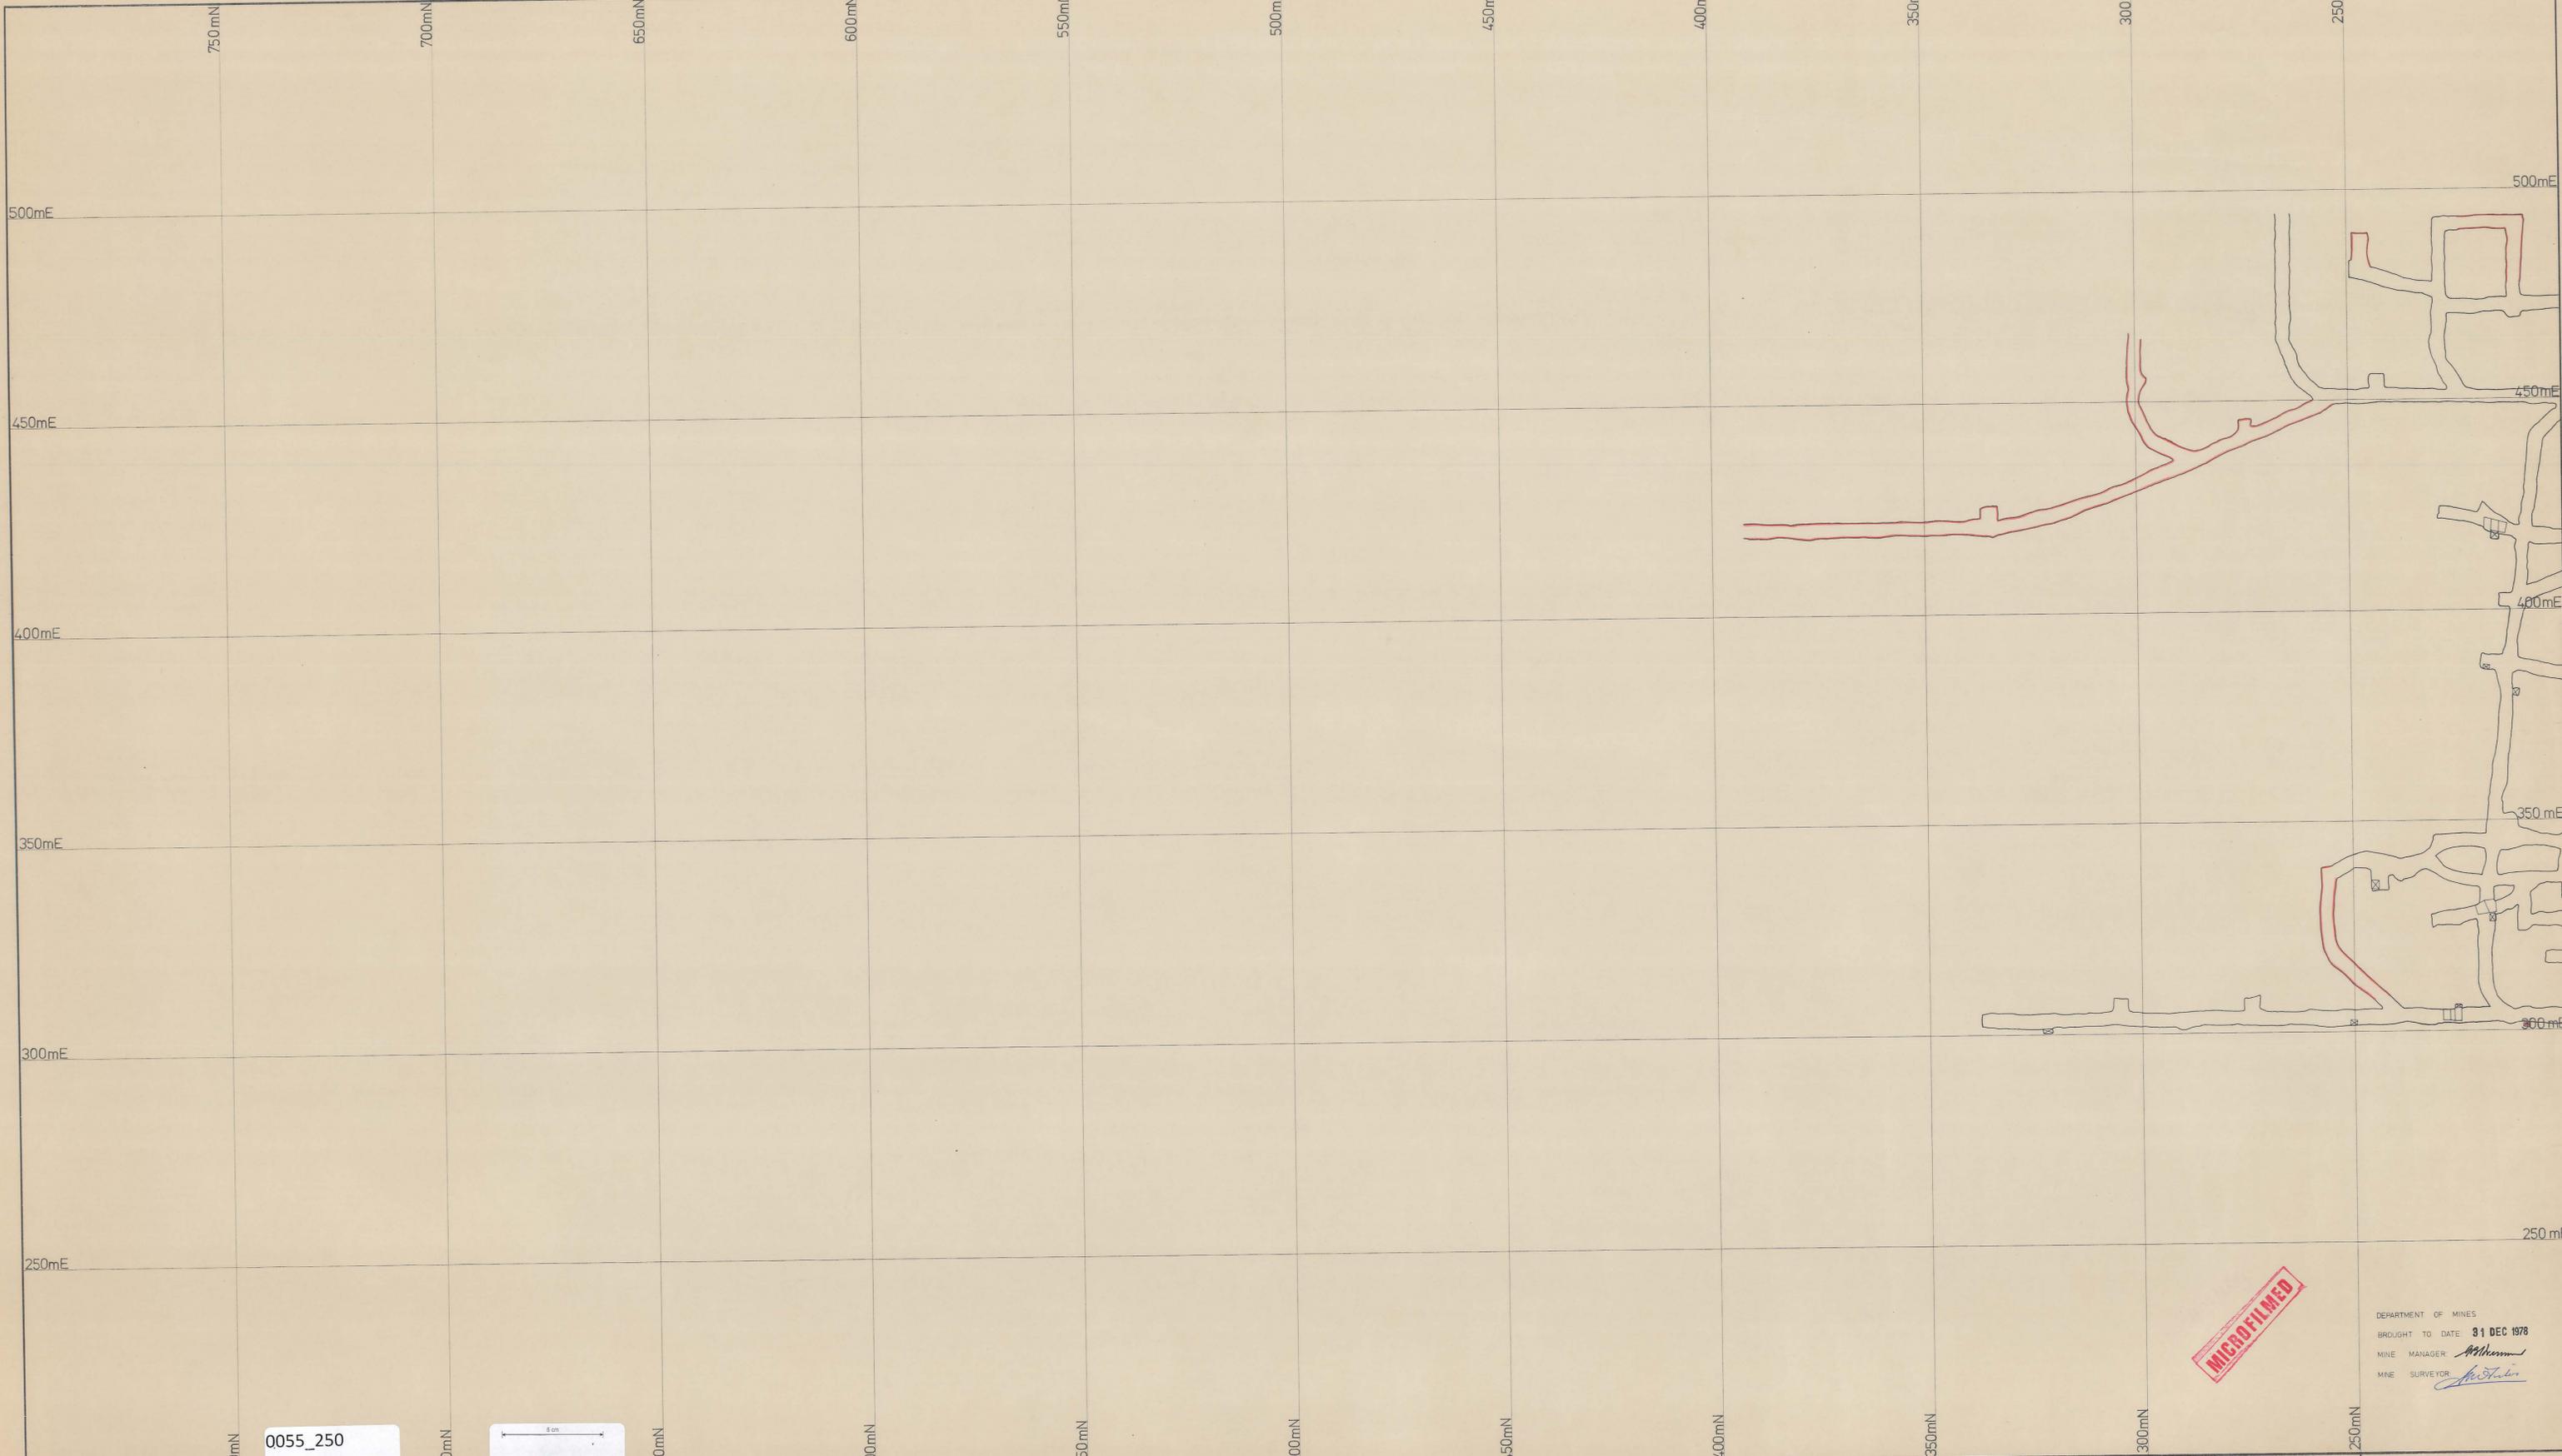

0055_250

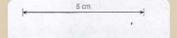

ELECTROLYTIC ZINC COMPANY OF AUSTRALASIA LIMITED
WEST COAST MINES, T.A.S.

SURVEY BY		SCALE	1:500
DRAWN BY		DATE	1978
TRACED BY	A.G.M.	REFERENCE	

ROSEBERY MINE
No 16 LEVEL ①

79020

DRAWING No: ①



MICROFILMED

DEPARTMENT OF MINES
BROUGHT TO DATE **31 DEC 1978**
MINE MANAGER: *[Signature]*
MINE SURVEYOR: *[Signature]*