


0055\_251



0055\_251

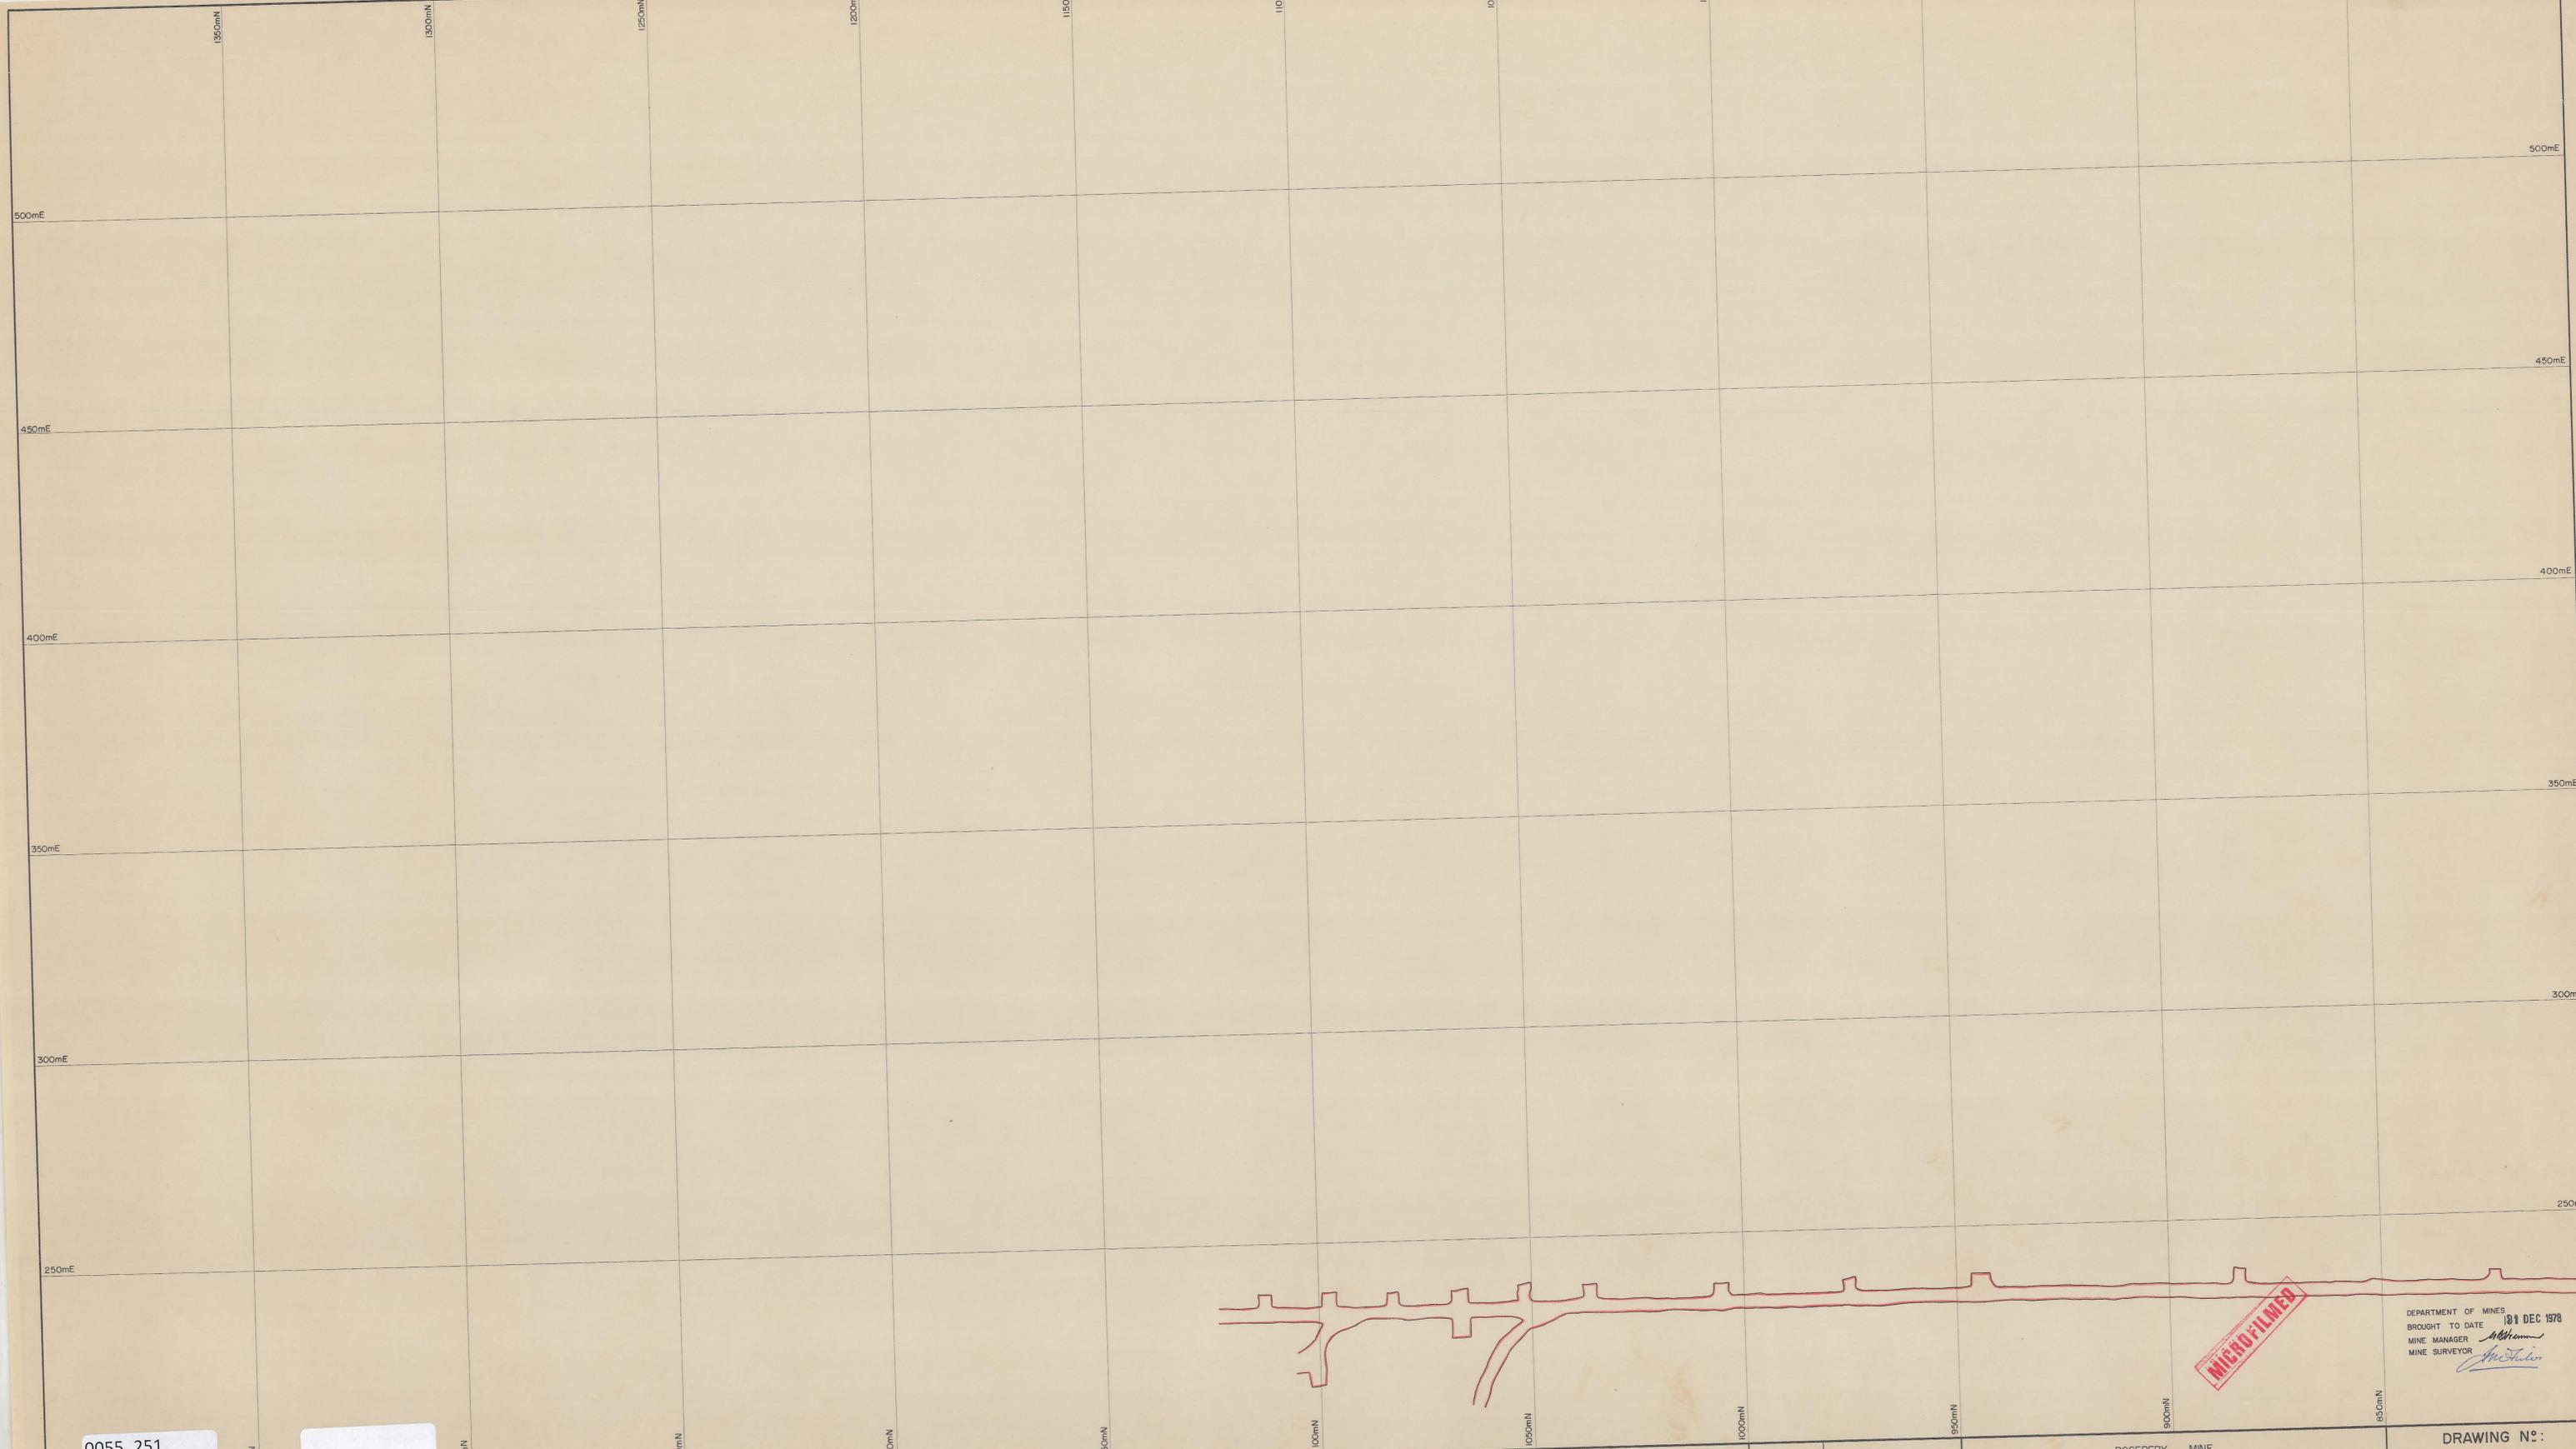

SCALE SHOWING 1:500 METRES AND EQUIVALENT FEET



ELECTROLYTIC ZINC COMPANY OF AUSTRALASIA LIMITED  
WEST COAST MINES, T.A.S.

SURVEY BY		SCALE	
DRAWN BY		DATE	
TRACED BY		REFERENCE	

ROSEBERY MINE  
N° 15 LEVEL (4)

79019

DEPARTMENT OF MINES  
BROUGHT TO DATE 18 DEC 1978  
MINE MANAGER *[Signature]*  
MINE SURVEYOR *[Signature]*

DRAWING N°:  
③  
④ ① ②

MICROFILMED