



0055_256

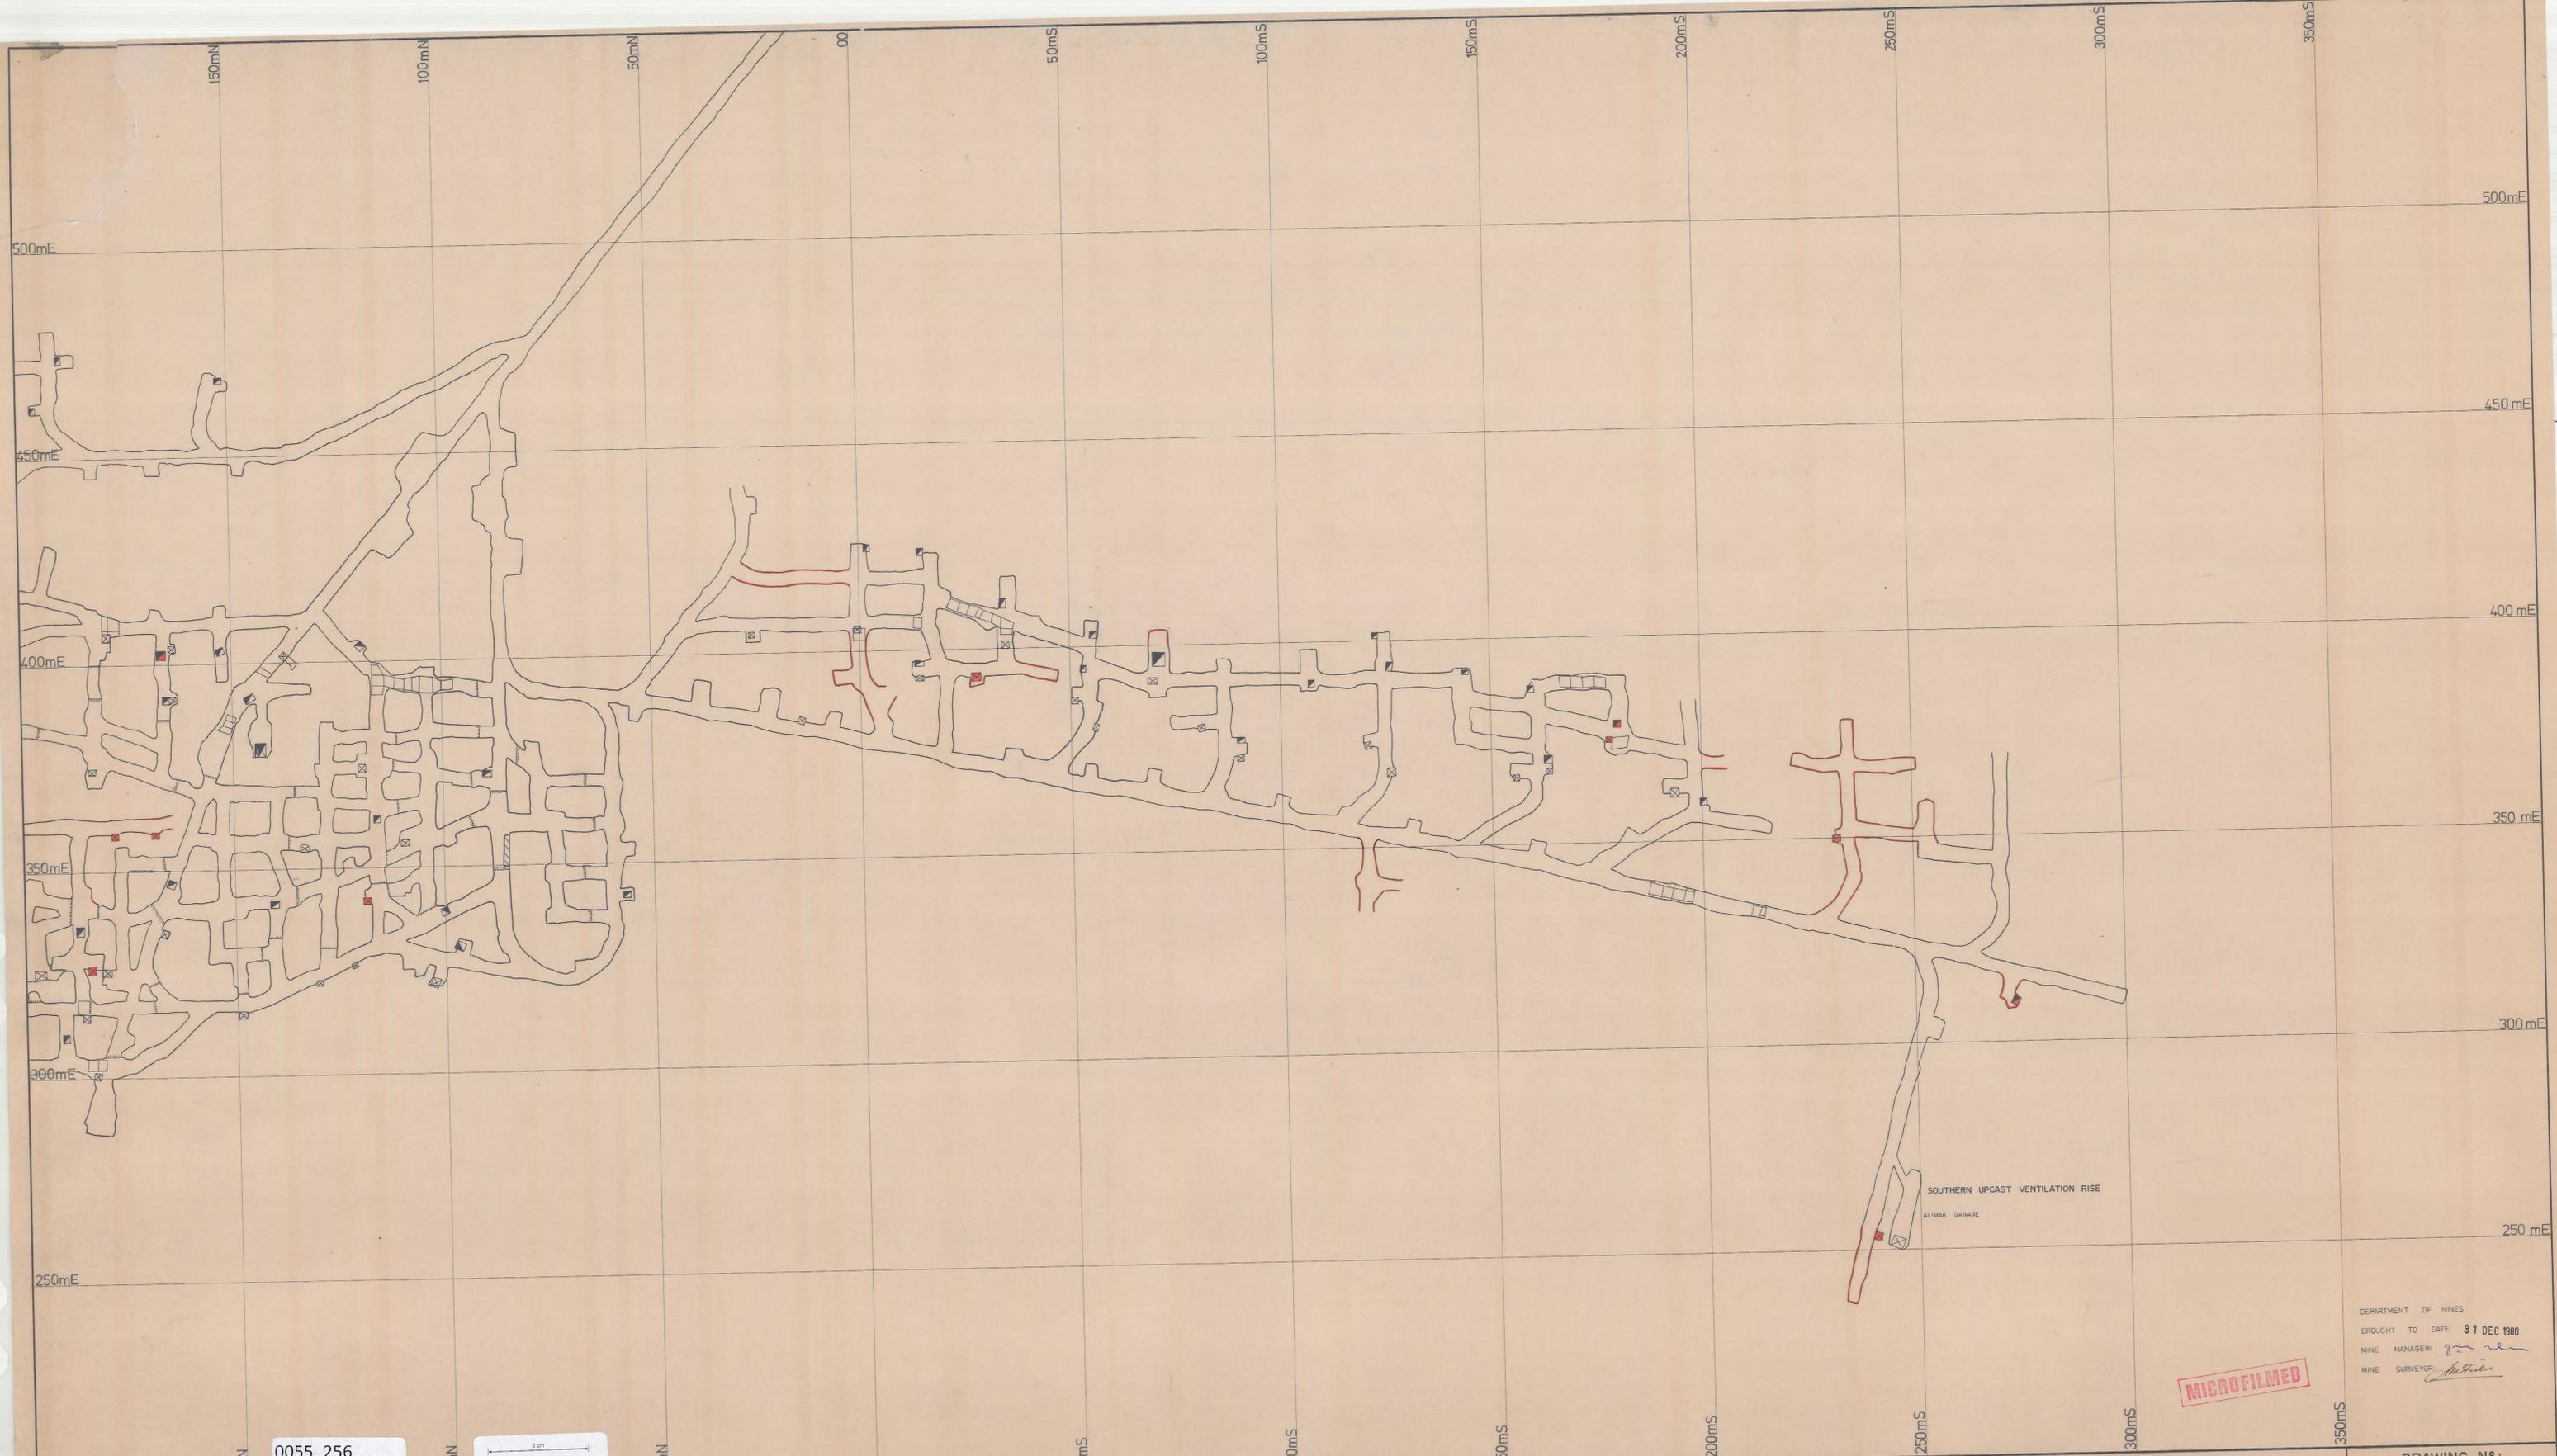

DEPARTMENT OF MINES
 BROUGHT TO DATE: 31 DEC 1980
 MINE MANAGER: *[Signature]*
 MINE SURVEYOR: *[Signature]*

MICROFILMED

0055_256

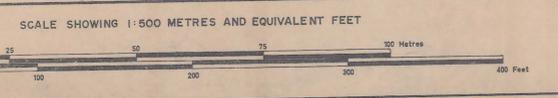

ELECTROLYTIC ZINC COMPANY OF AUSTRALASIA LIMITED
 WEST COAST MINES, TAS.

SURVEY BY		SCALE	1: 500
DRAWN BY		DATE	1975
TRACED BY	I.T.M.	REFERENCE	

ROSEBERRY MINE
 NO 16 LEVEL (2)

DRAWING NO: ① ② ③

81339