


0055_257



0055_257

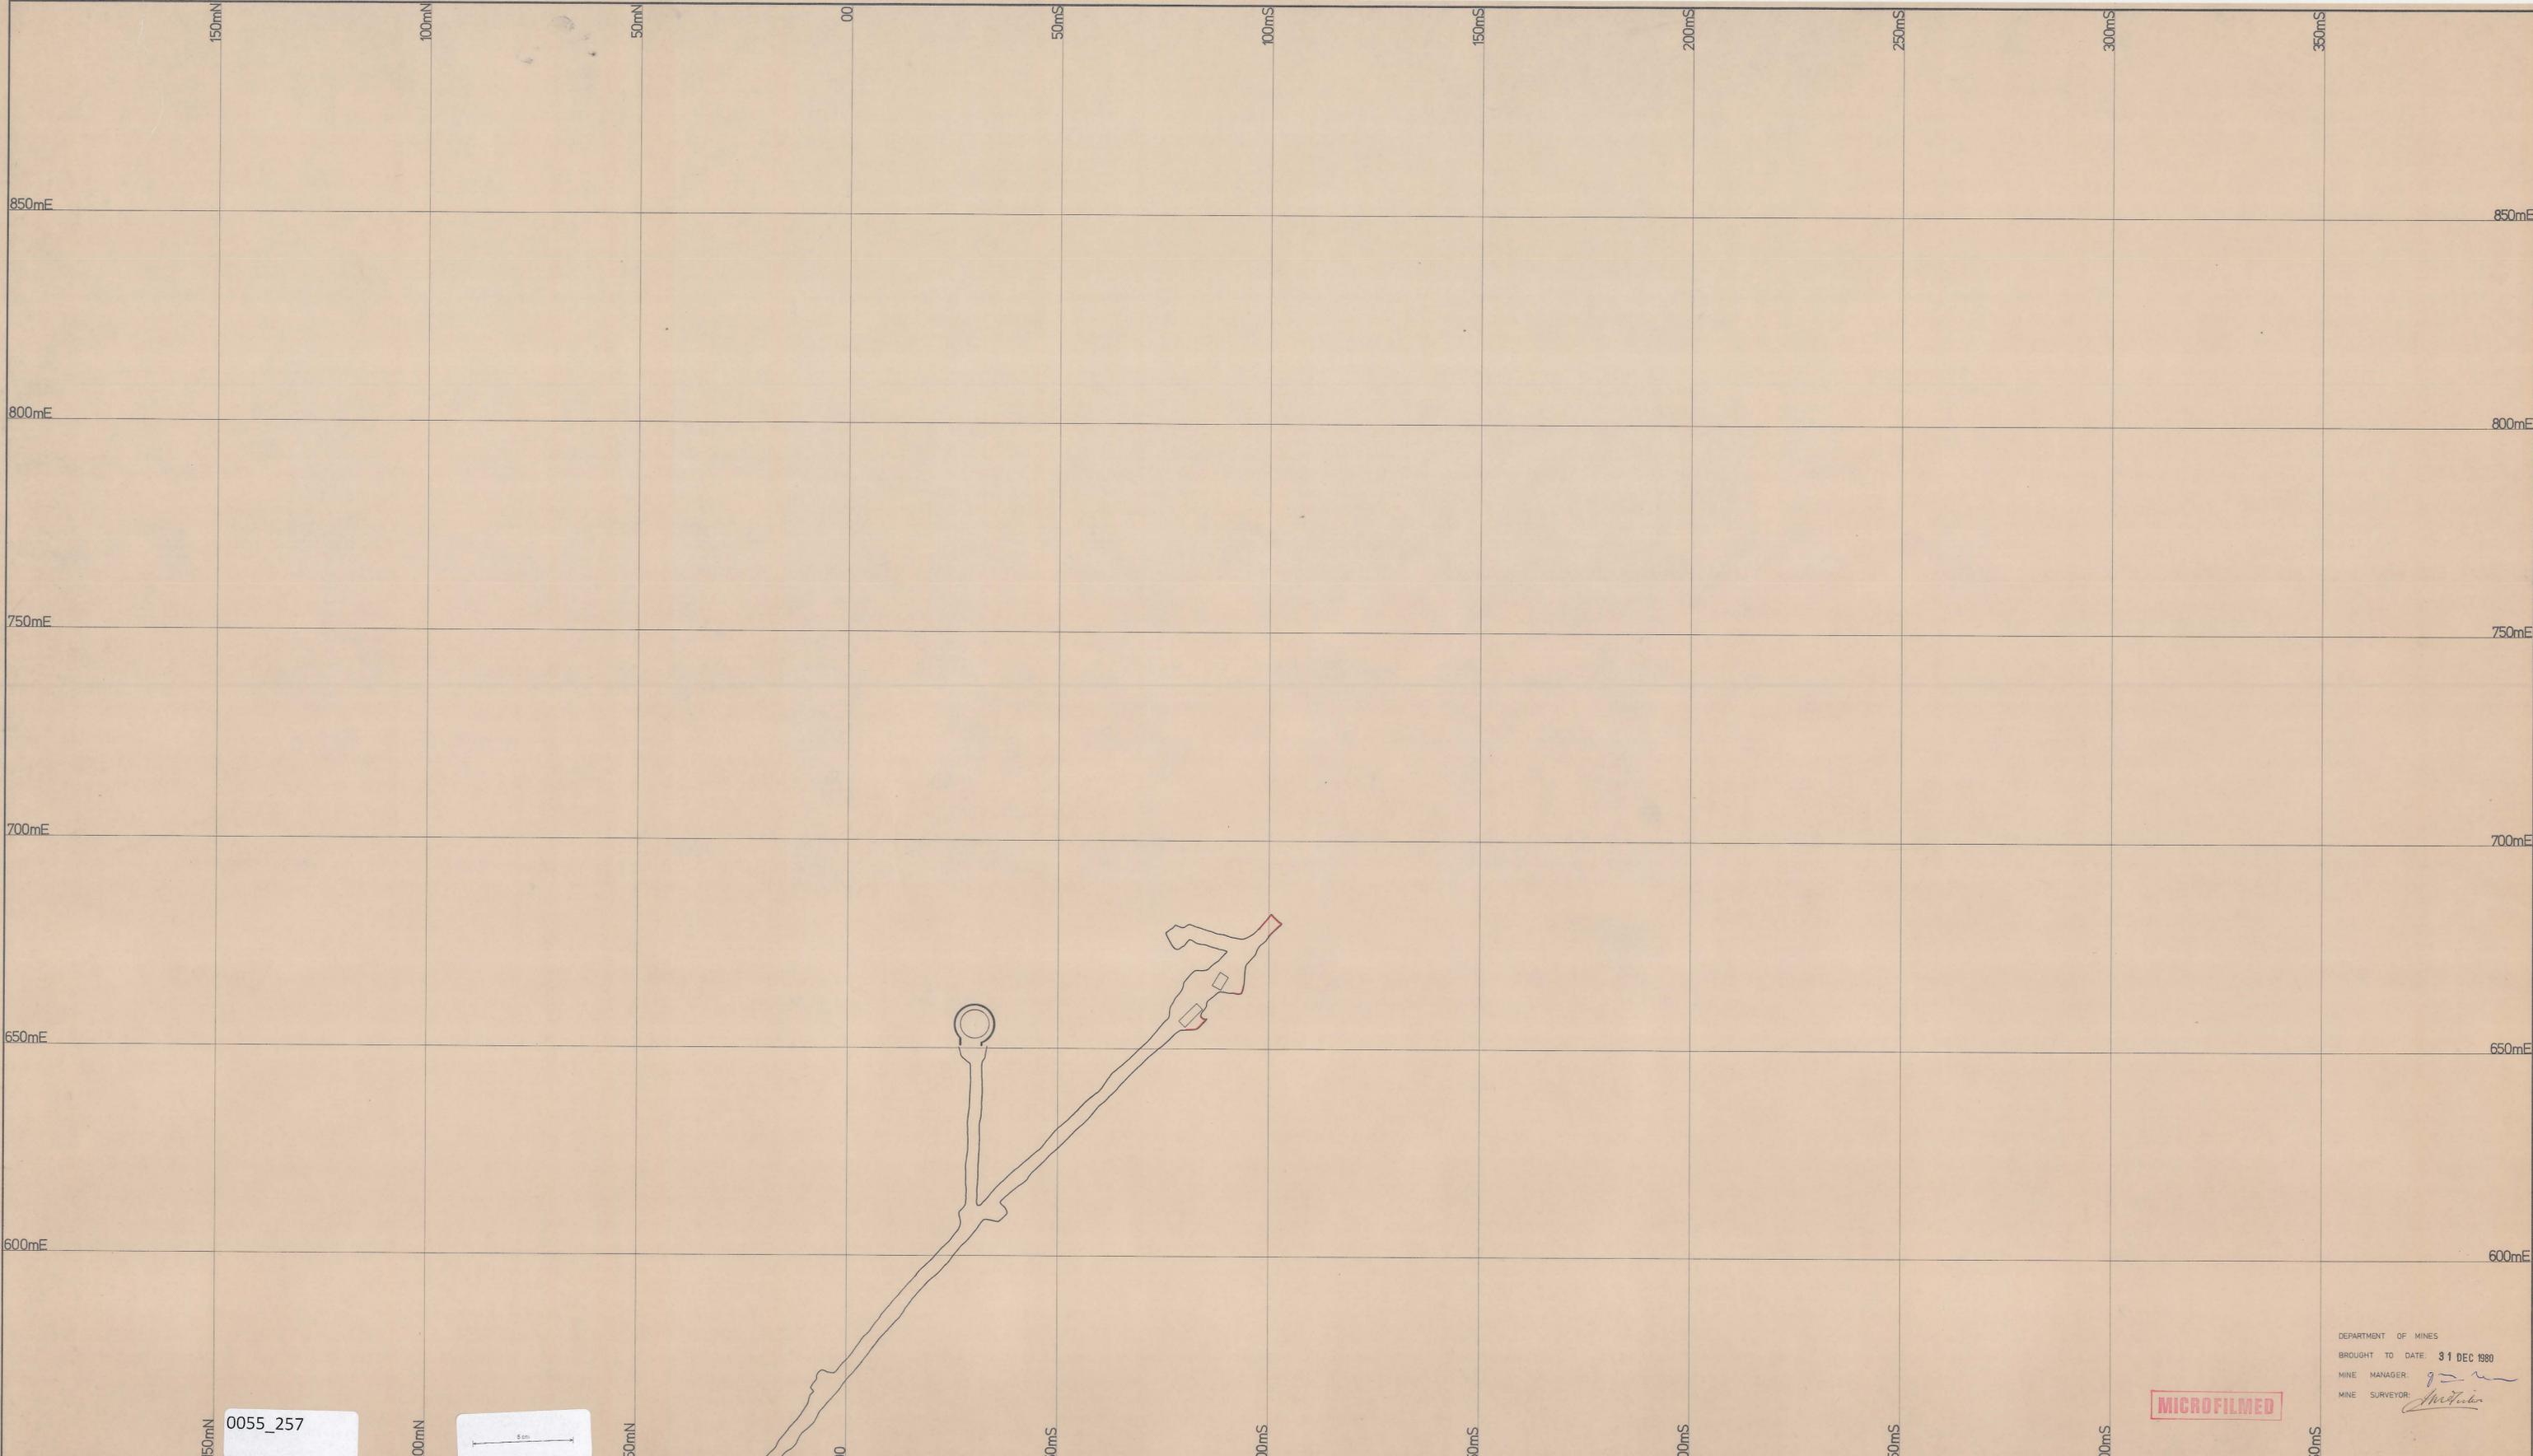

MICROFILMED

DEPARTMENT OF MINES
 BROUGHT TO DATE: 31 DEC 1980
 MINE MANAGER: *[Signature]*
 MINE SURVEYOR: *[Signature]*

SCALE SHOWING 1:500 METRES AND EQUIVALENT FEET

ELECTROLYTIC ZINC COMPANY OF AUSTRALASIA LIMITED
 WEST COAST MINES, TAS.

SURVEY BY		SCALE	1:500
DRAWN BY		DATE	1975
TRACED BY	I.T.M.	REFERENCE	

ROSEBERY MINE
 N^o 16 LEVEL (3)

DRAWING N^o:
 81340