



0055\_259

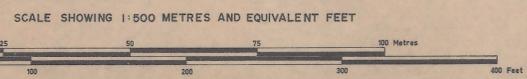

0055\_259

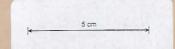

ELECTROLYTIC ZINC COMPANY OF AUSTRALASIA LIMITED  
WEST COAST MINES, T.A.S.

SURVEY BY	SCALE	1:500
DRAWN BY	DATE	1975
TRACED BY I.T.M.	REFERENCE	

ROSEBERY MINE  
No 17 LEVEL (3)

MICROFILMED

DEPARTMENT OF MINES  
BROUGHT TO DATE: 31 DEC 1980  
MINE MANAGER: *[Signature]*  
MINE SURVEYOR: *[Signature]*

DRAWING N<sup>o</sup>:  
②  
①  
③  
④  
8/342