


0055_260

0055_260

1 cm

MICROFILMED

DEPARTMENT OF MINES
BROUGHT TO DATE: 31 DEC 1980
MINE MANAGER: *[Signature]*
MINE SURVEYOR: *[Signature]*

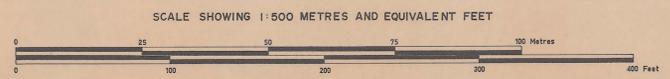

ELECTROLYTIC ZINC COMPANY OF AUSTRALASIA LIMITED
WEST COAST MINES, T.A.S.

SURVEY BY	SCALE	1:500
DRAWN BY	DATE	20 5 80
TRACED BY G. M. BENNETT	REFERENCE	

ROSEBERY MINE
DEVELOPMENT PLAN
DECLINE SPECIAL, Sheet 1

DRAWING N^o:
81343

