

0055_261




0055_261

5 cm

MICROFILMED

DEPARTMENT OF MINES
 BROUGHT TO DATE: 31 DEC 1980
 MINE MANAGER: *[Signature]*
 MINE SURVEYOR: *[Signature]*

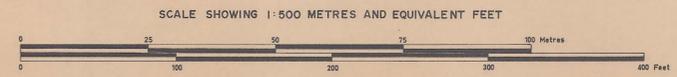

ELECTROLYTIC ZINC COMPANY OF AUSTRALASIA LIMITED
 WEST COAST MINES, T.A.S.

SURVEY BY		SCALE	1:500
DRAWN BY		DATE	15-01-81
TRACED BY	G. M. BENNETT	REFERENCE	

ROSEBERY MINE
 DEVELOPMENT PLAN
 DECLINE SPECIAL, Sheet 2

DRAWING NO: 81344