



0055_262

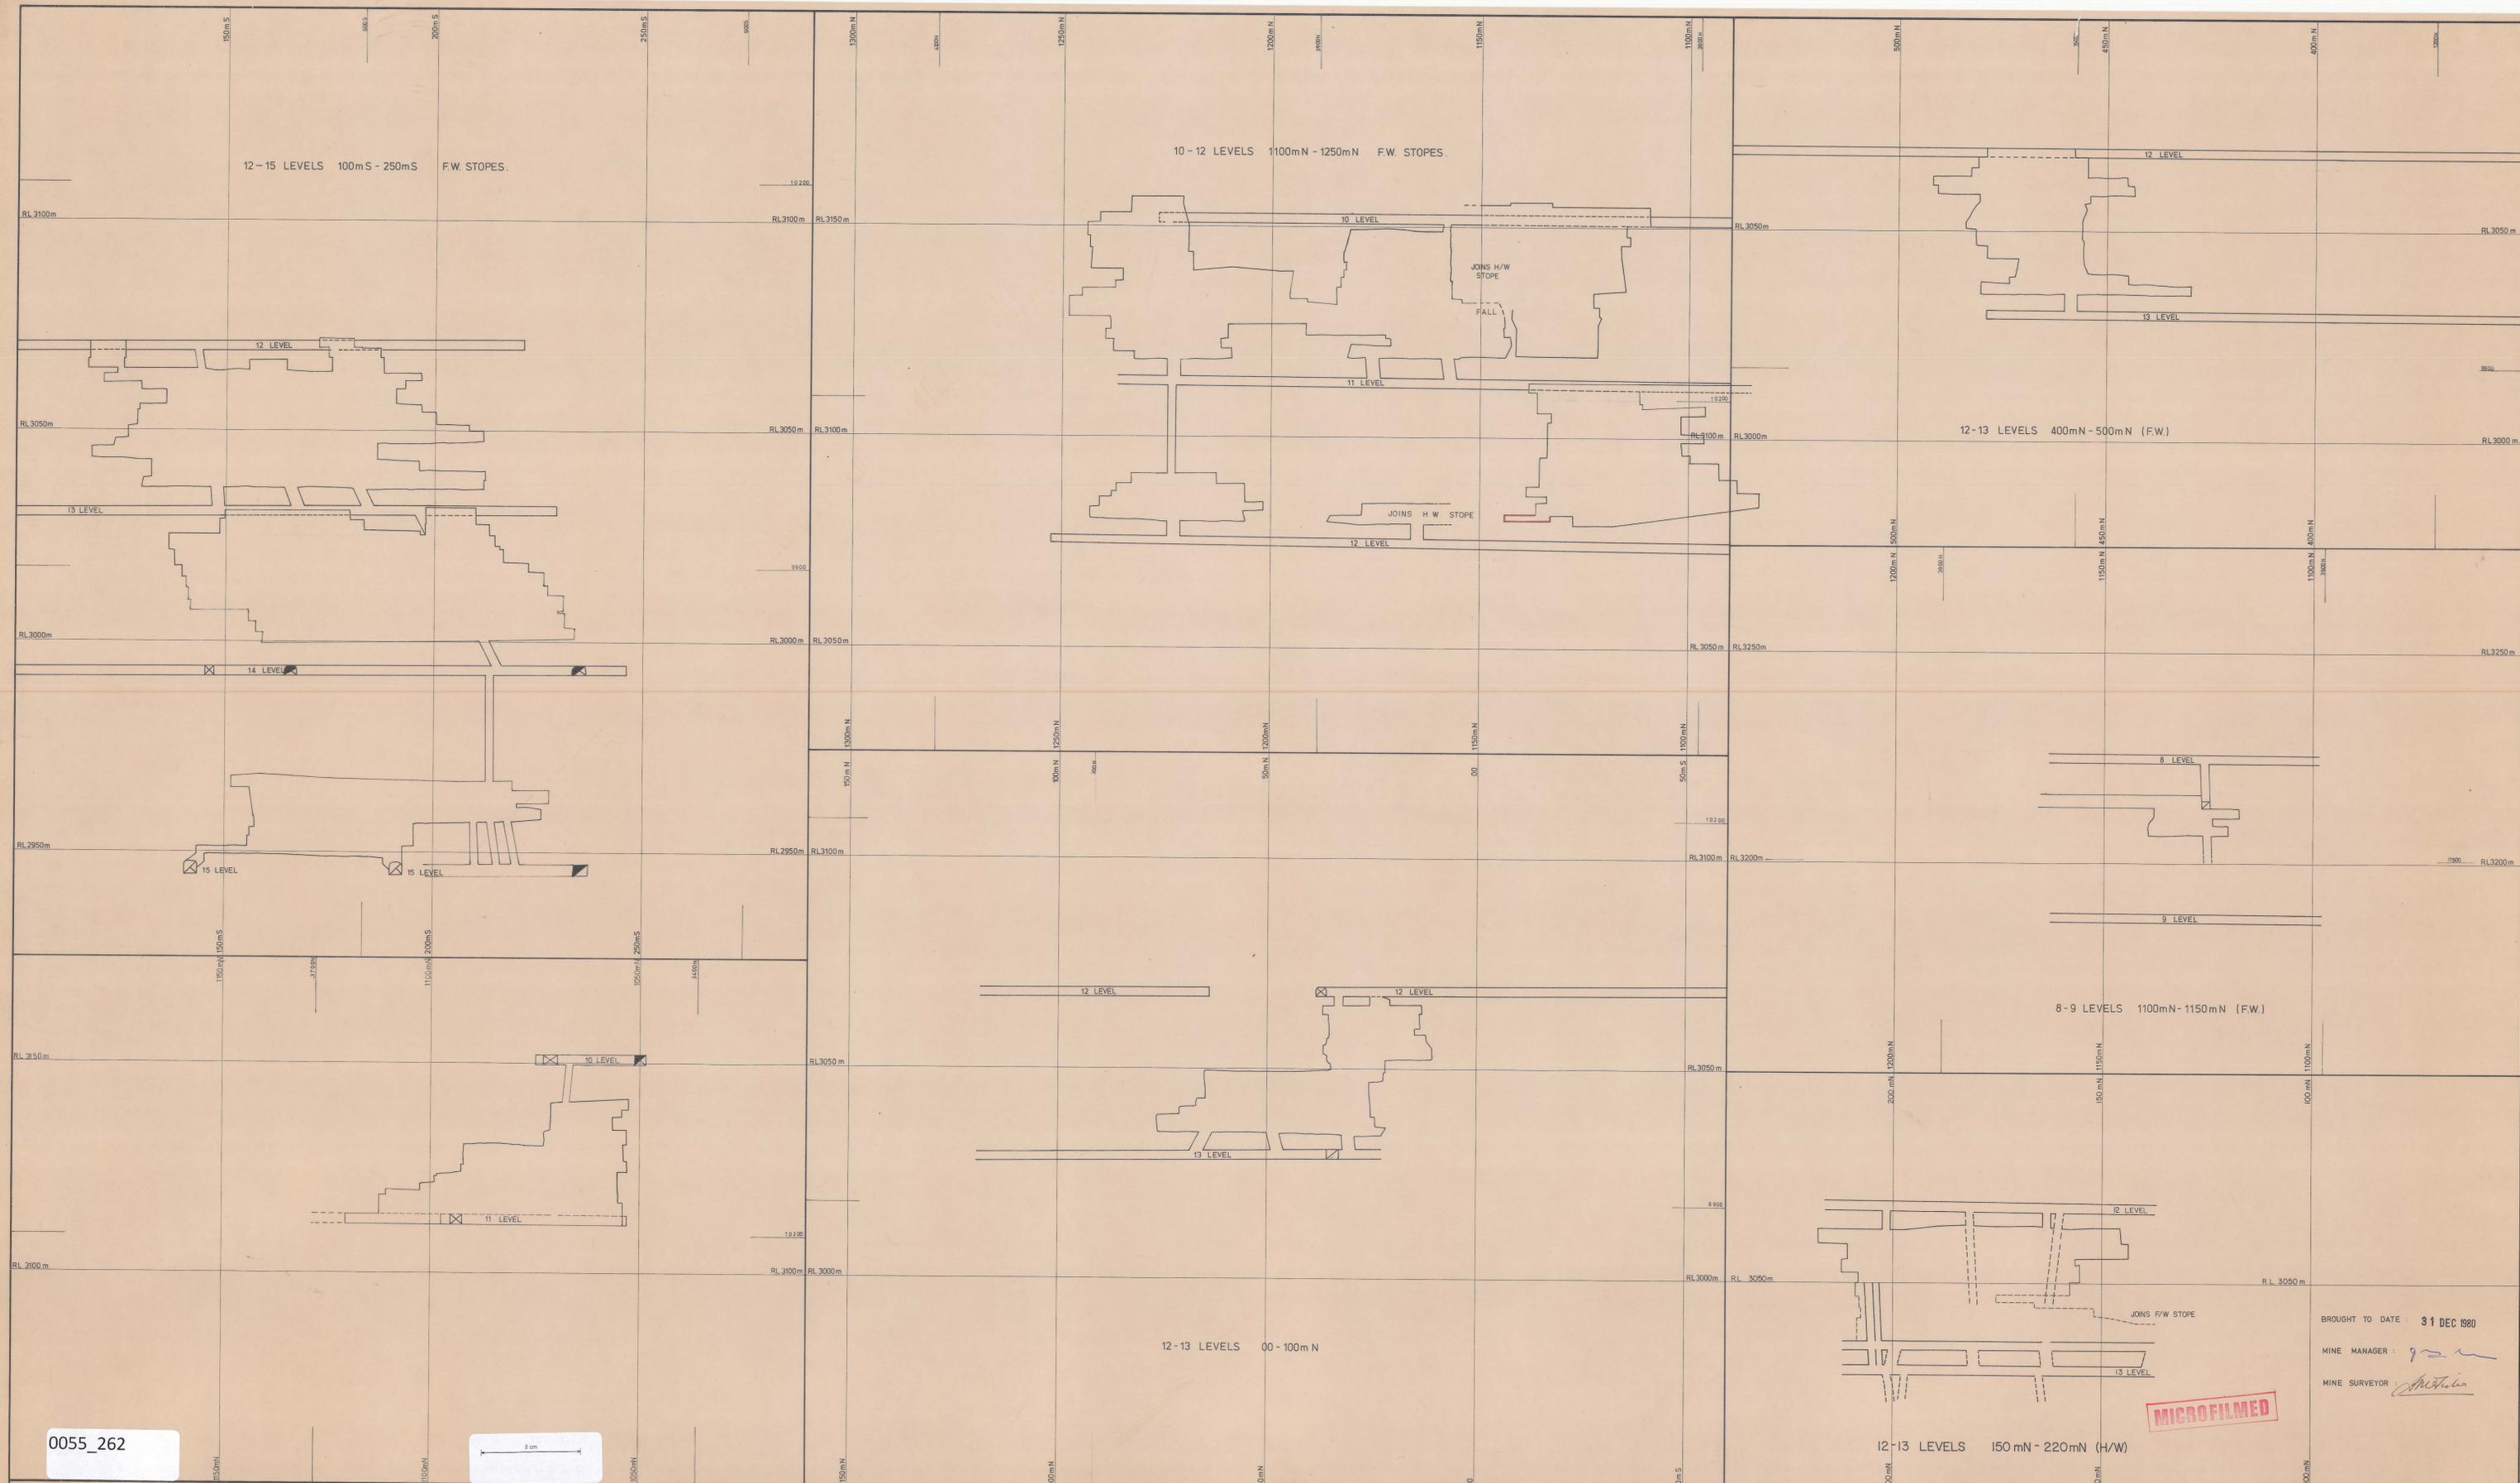

0055_262

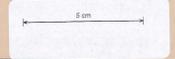

SCALE SHOWING 1:500 METRES AND EQUIVALENT FEET

ELECTROLYTIC ZINC COMPANY OF AUSTRALASIA LIMITED
 WEST COAST MINES, T.A.S.

SURVEY BY		SCALE	1 : 500
DRAWN BY		DATE	1973
TRACED BY	P. J. Lowe	REFERENCE	

ROSEBERY MINE
 LONGITUDINAL PROJECTION
 SPECIFIC STOPES.

BROUGHT TO DATE : 31 DEC 1980
 MINE MANAGER : *[Signature]*
 MINE SURVEYOR : *[Signature]*

MICROFILMED

DRAWING NO: 81345
 DEPARTMENT OF MINES