


0055_263

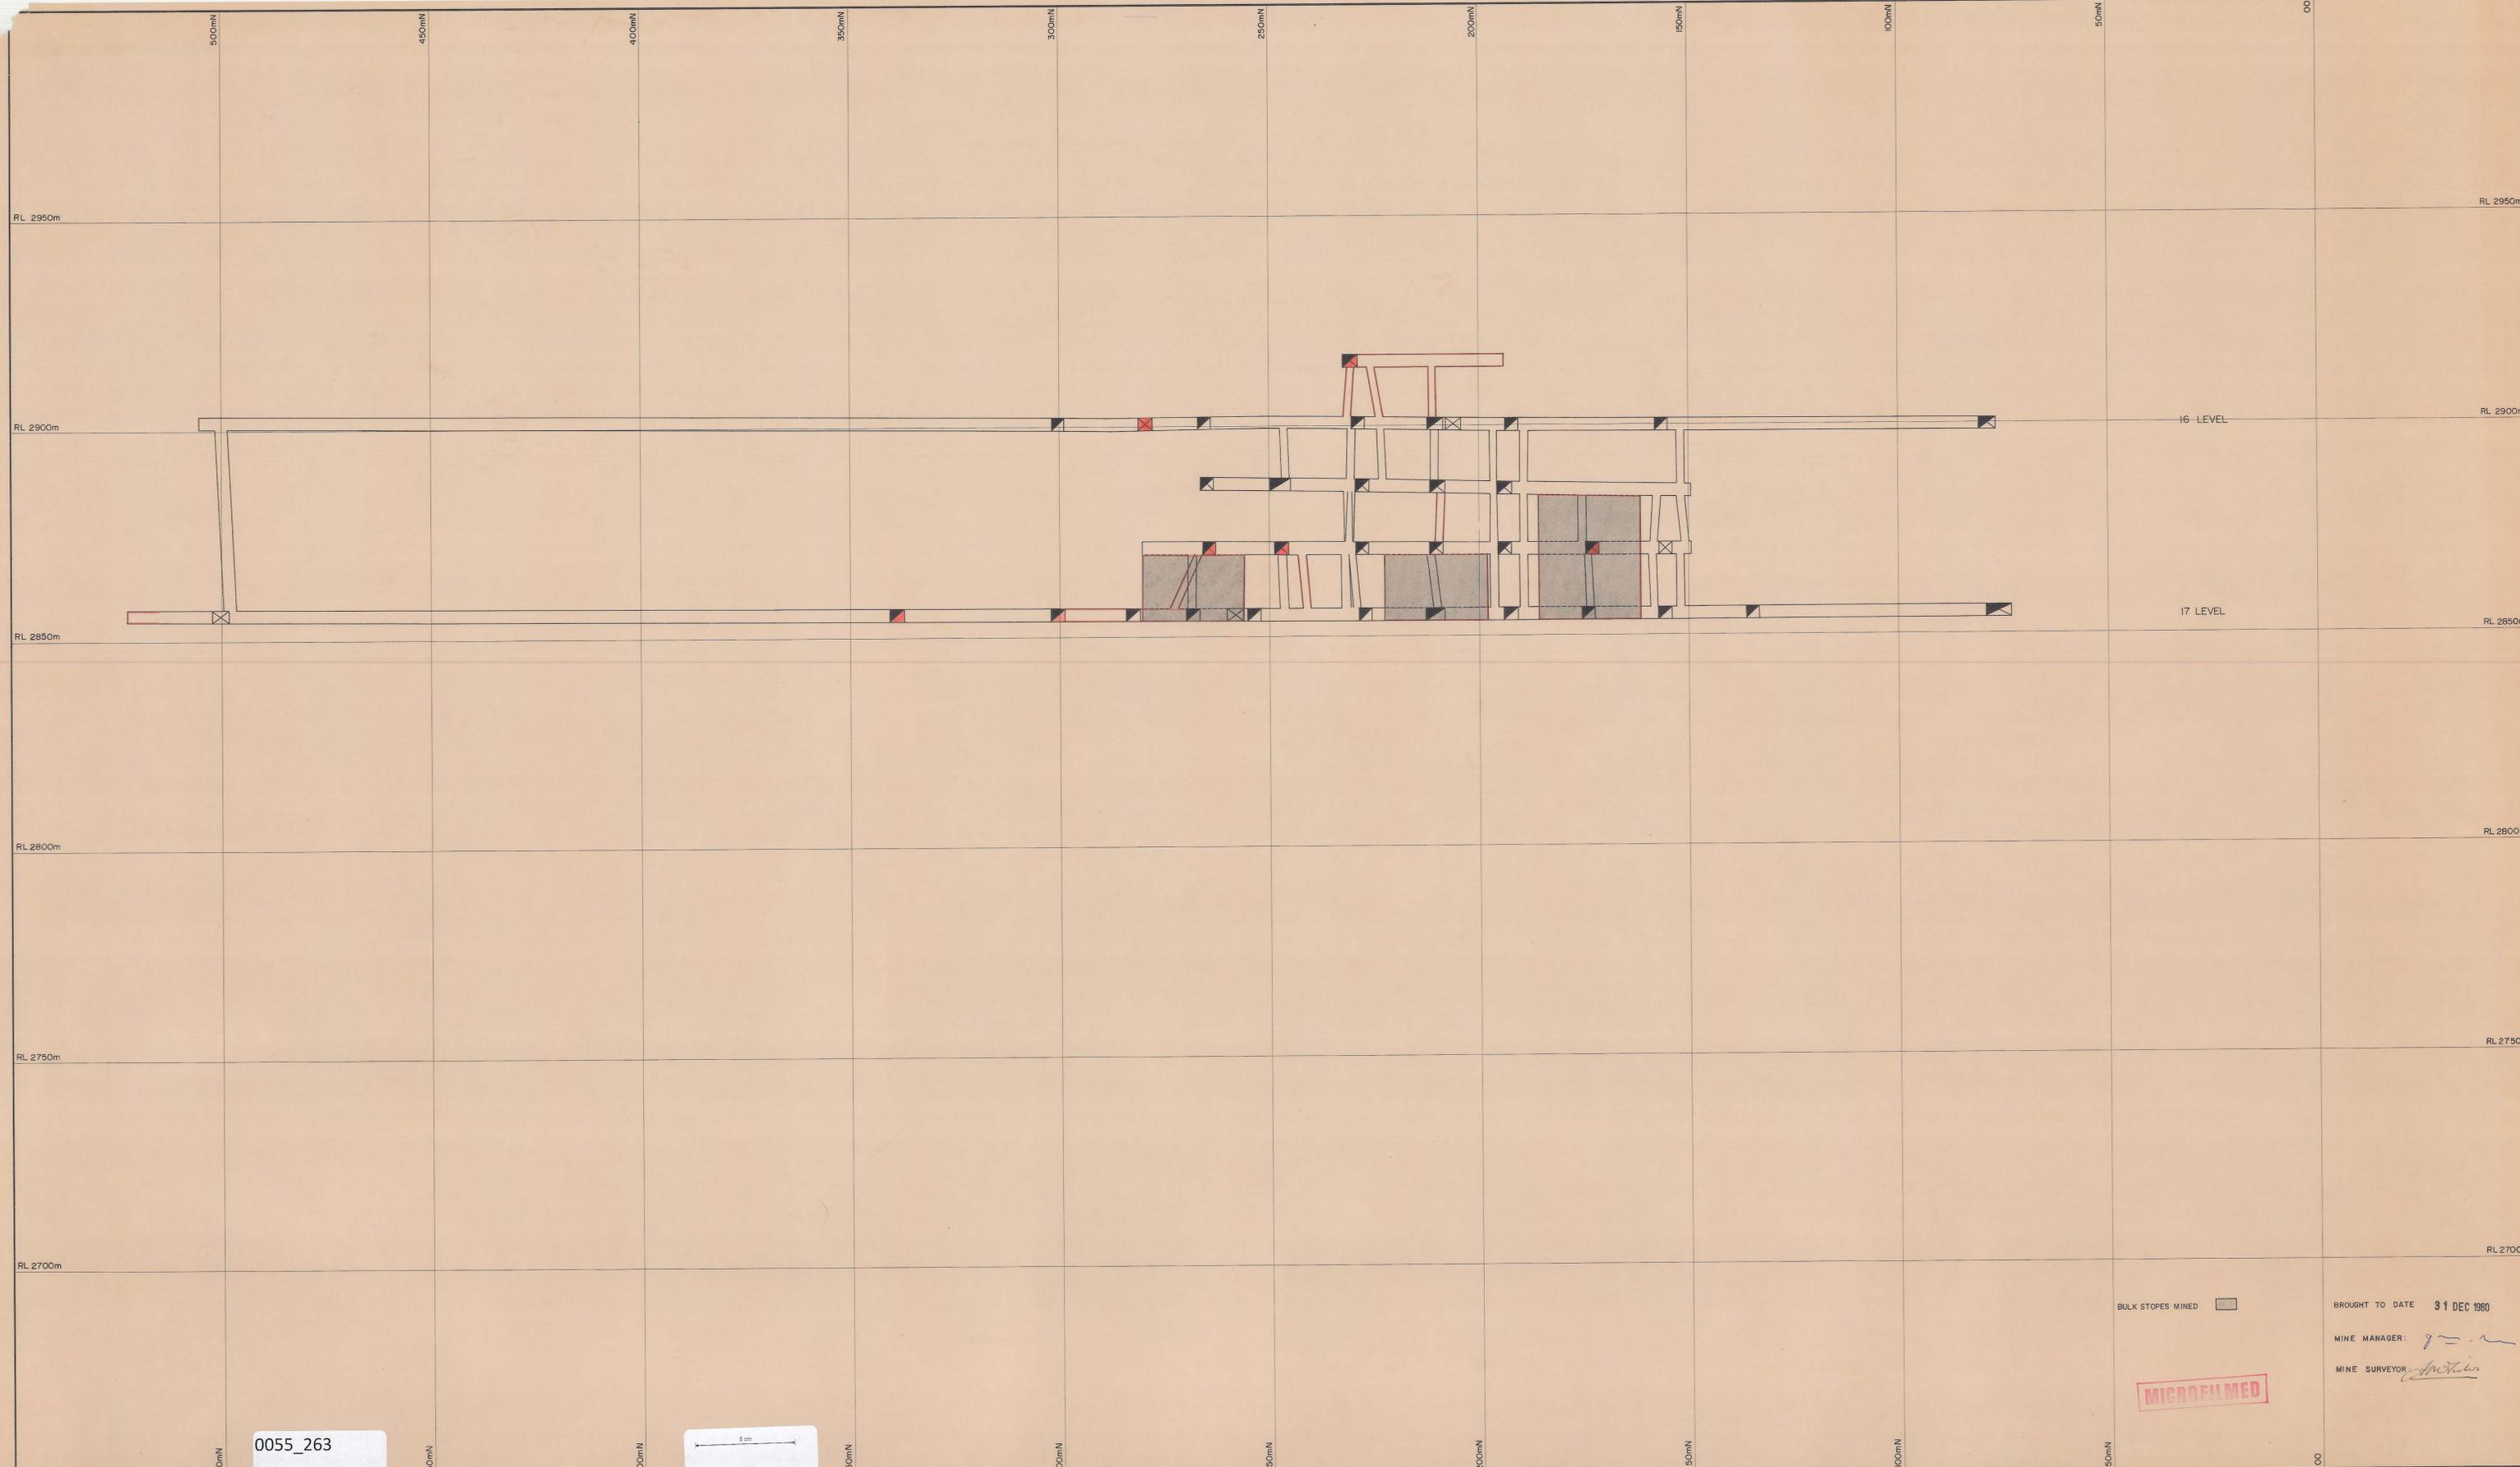

0055_263

BULK STOPES MINED

BROUGHT TO DATE 31 DEC 1980

MINE MANAGER: *[Signature]*

MINE SURVEYOR: *[Signature]*

MICROFILMED

SCALE SHOWING 1:500 METRES AND EQUIVALENT FEET



ELECTROLYTIC ZINC COMPANY OF AUSTRALASIA LIMITED
WEST COAST MINES, T.A.S.

SURVEY BY		SCALE	1:500
DRAWN BY	A.G. MORRISON	DATE	19.01.79
TRACED BY	A.G.M.	REFERENCE	

ROSEBERY MINE
LONGITUDINAL PROJECTION
'H' LENS. H/W STOPE
50mS-550mN BELOW 15 LEVEL

DRAWING NO:
DEPARTMENT OF MINES

81346