


0055\_264



0055\_264

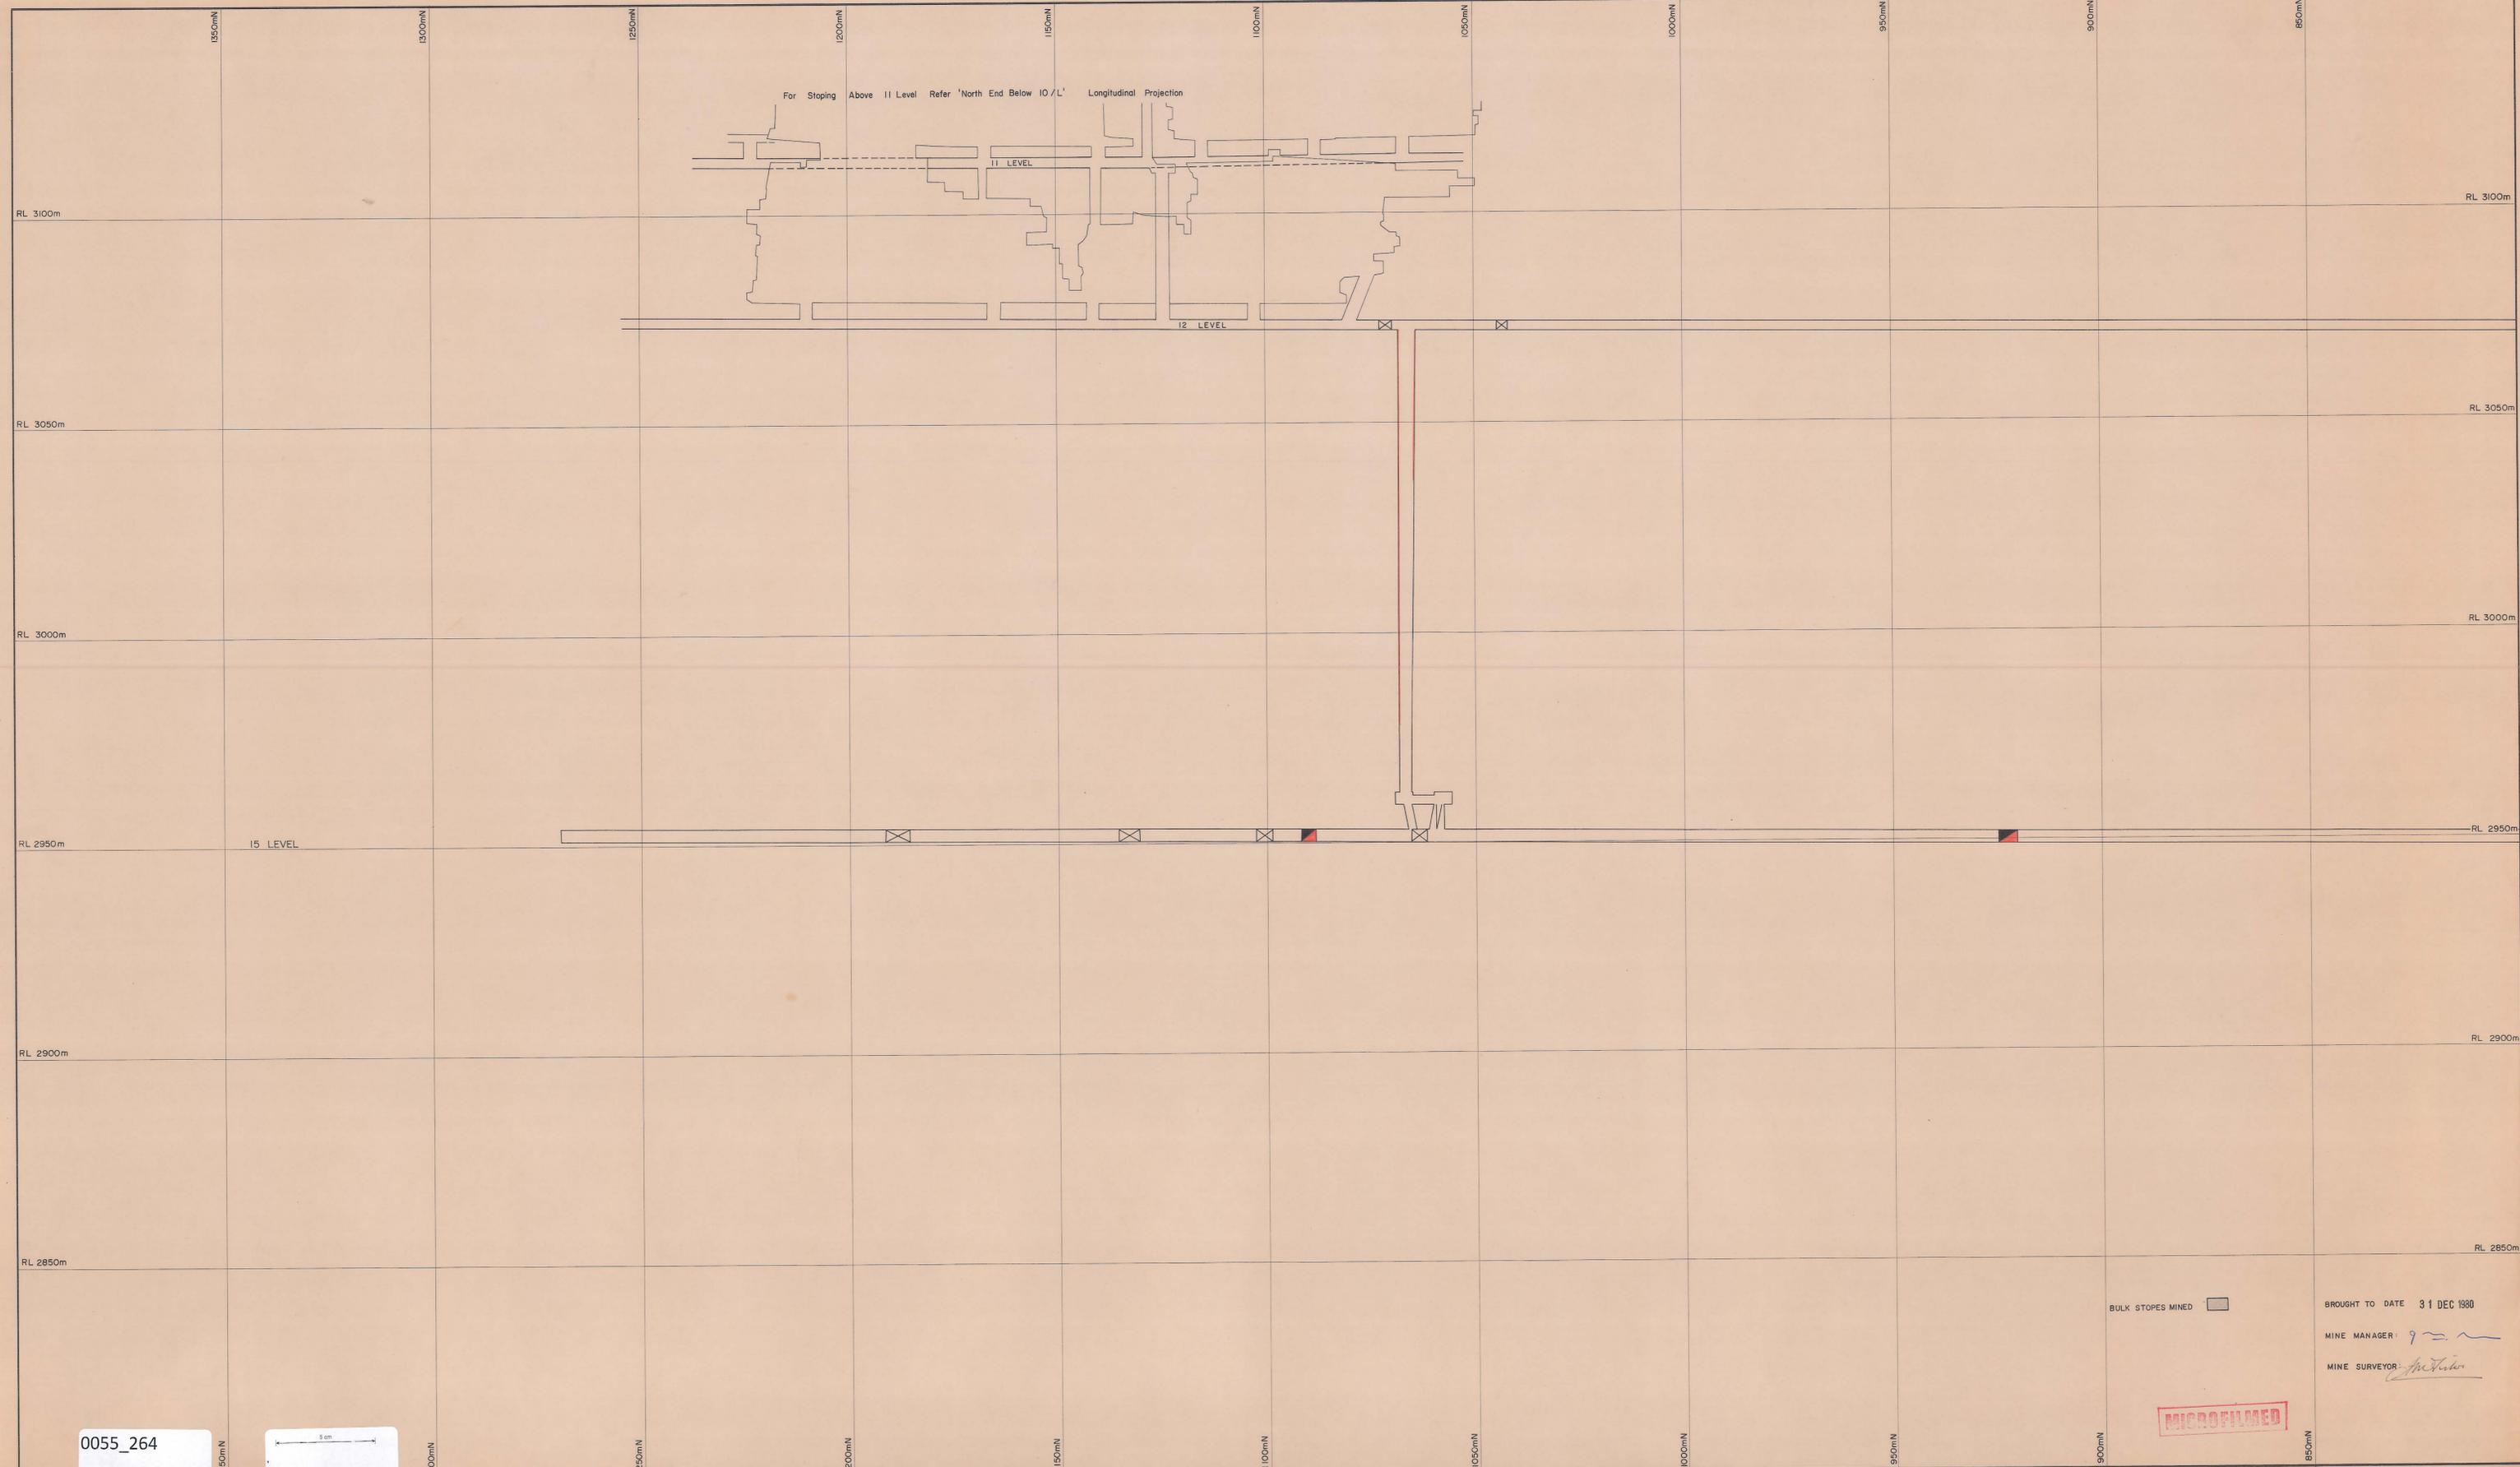

BULK STOPES MINED

BROUGHT TO DATE 31 DEC 1980

MINE MANAGER: *[Signature]*

MINE SURVEYOR: *[Signature]*

MICROFILMED

**ELECTROLYTIC ZINC COMPANY OF AUSTRALASIA LIMITED**  
WEST COAST MINES, T.A.S.

SURVEY BY		SCALE	1:500
DRAWN BY	A. G. MORRISON	DATE	19 01 79
TRACED BY	A. G. M.	REFERENCE	

ROSEBERY MINE  
LONGITUDINAL PROJECTION  
800mN-1400mN - BELOW 10/L

DRAWING NO.:  
DEPARTMENT OF MINES  
81347