


0055\_265



0055\_265

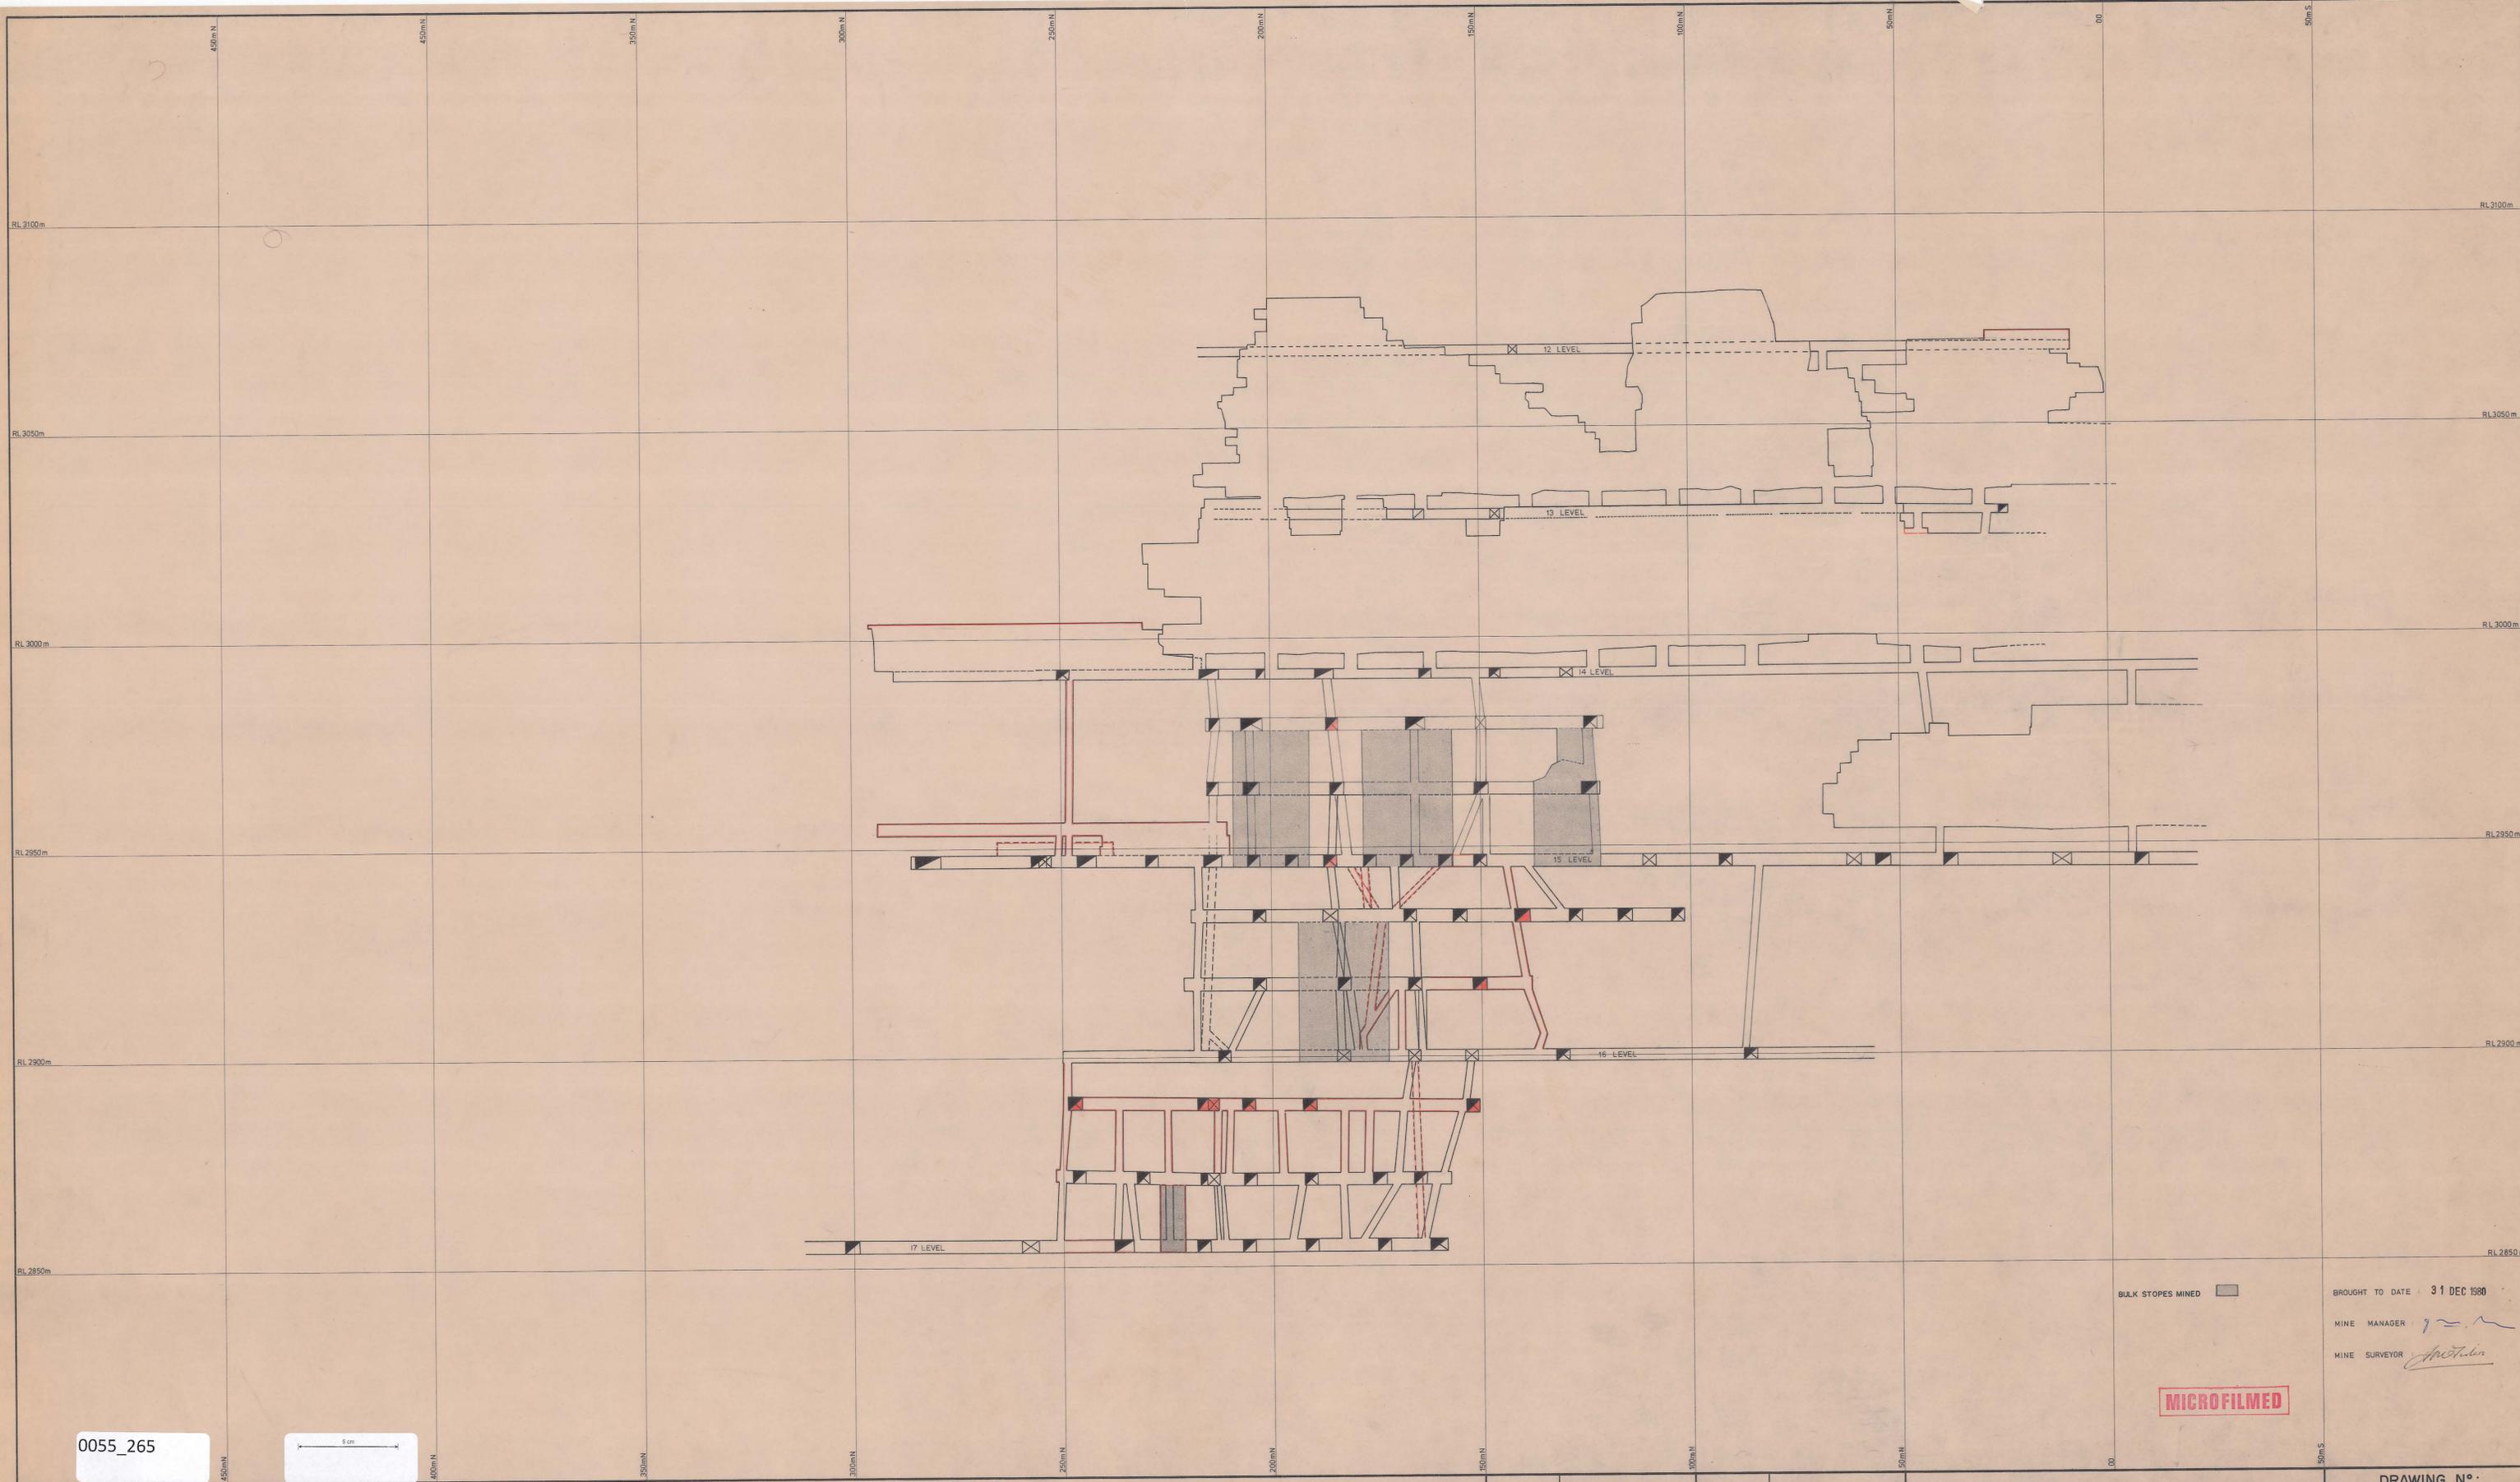

SCALE SHOWING 1:500 METRES AND EQUIVALENT FEET



**ELECTROLYTIC ZINC COMPANY OF AUSTRALASIA LIMITED**  
 WEST COAST MINES, T.A.S.

SURVEY BY		SCALE	1 : 500
DRAWN BY		DATE	1973
TRACED BY	P.J. Lowe	REFERENCE	

ROSEBERY MINE  
 LONGITUDINAL PROJECTION  
 H.W. STOPES.

**MICROFILMED**

BROUGHT TO DATE 31 DEC 1980  
 MINE MANAGER *[Signature]*  
 MINE SURVEYOR *[Signature]*

DRAWING NO.:  
 DEPARTMENT OF MINES

81348