



0055\_267

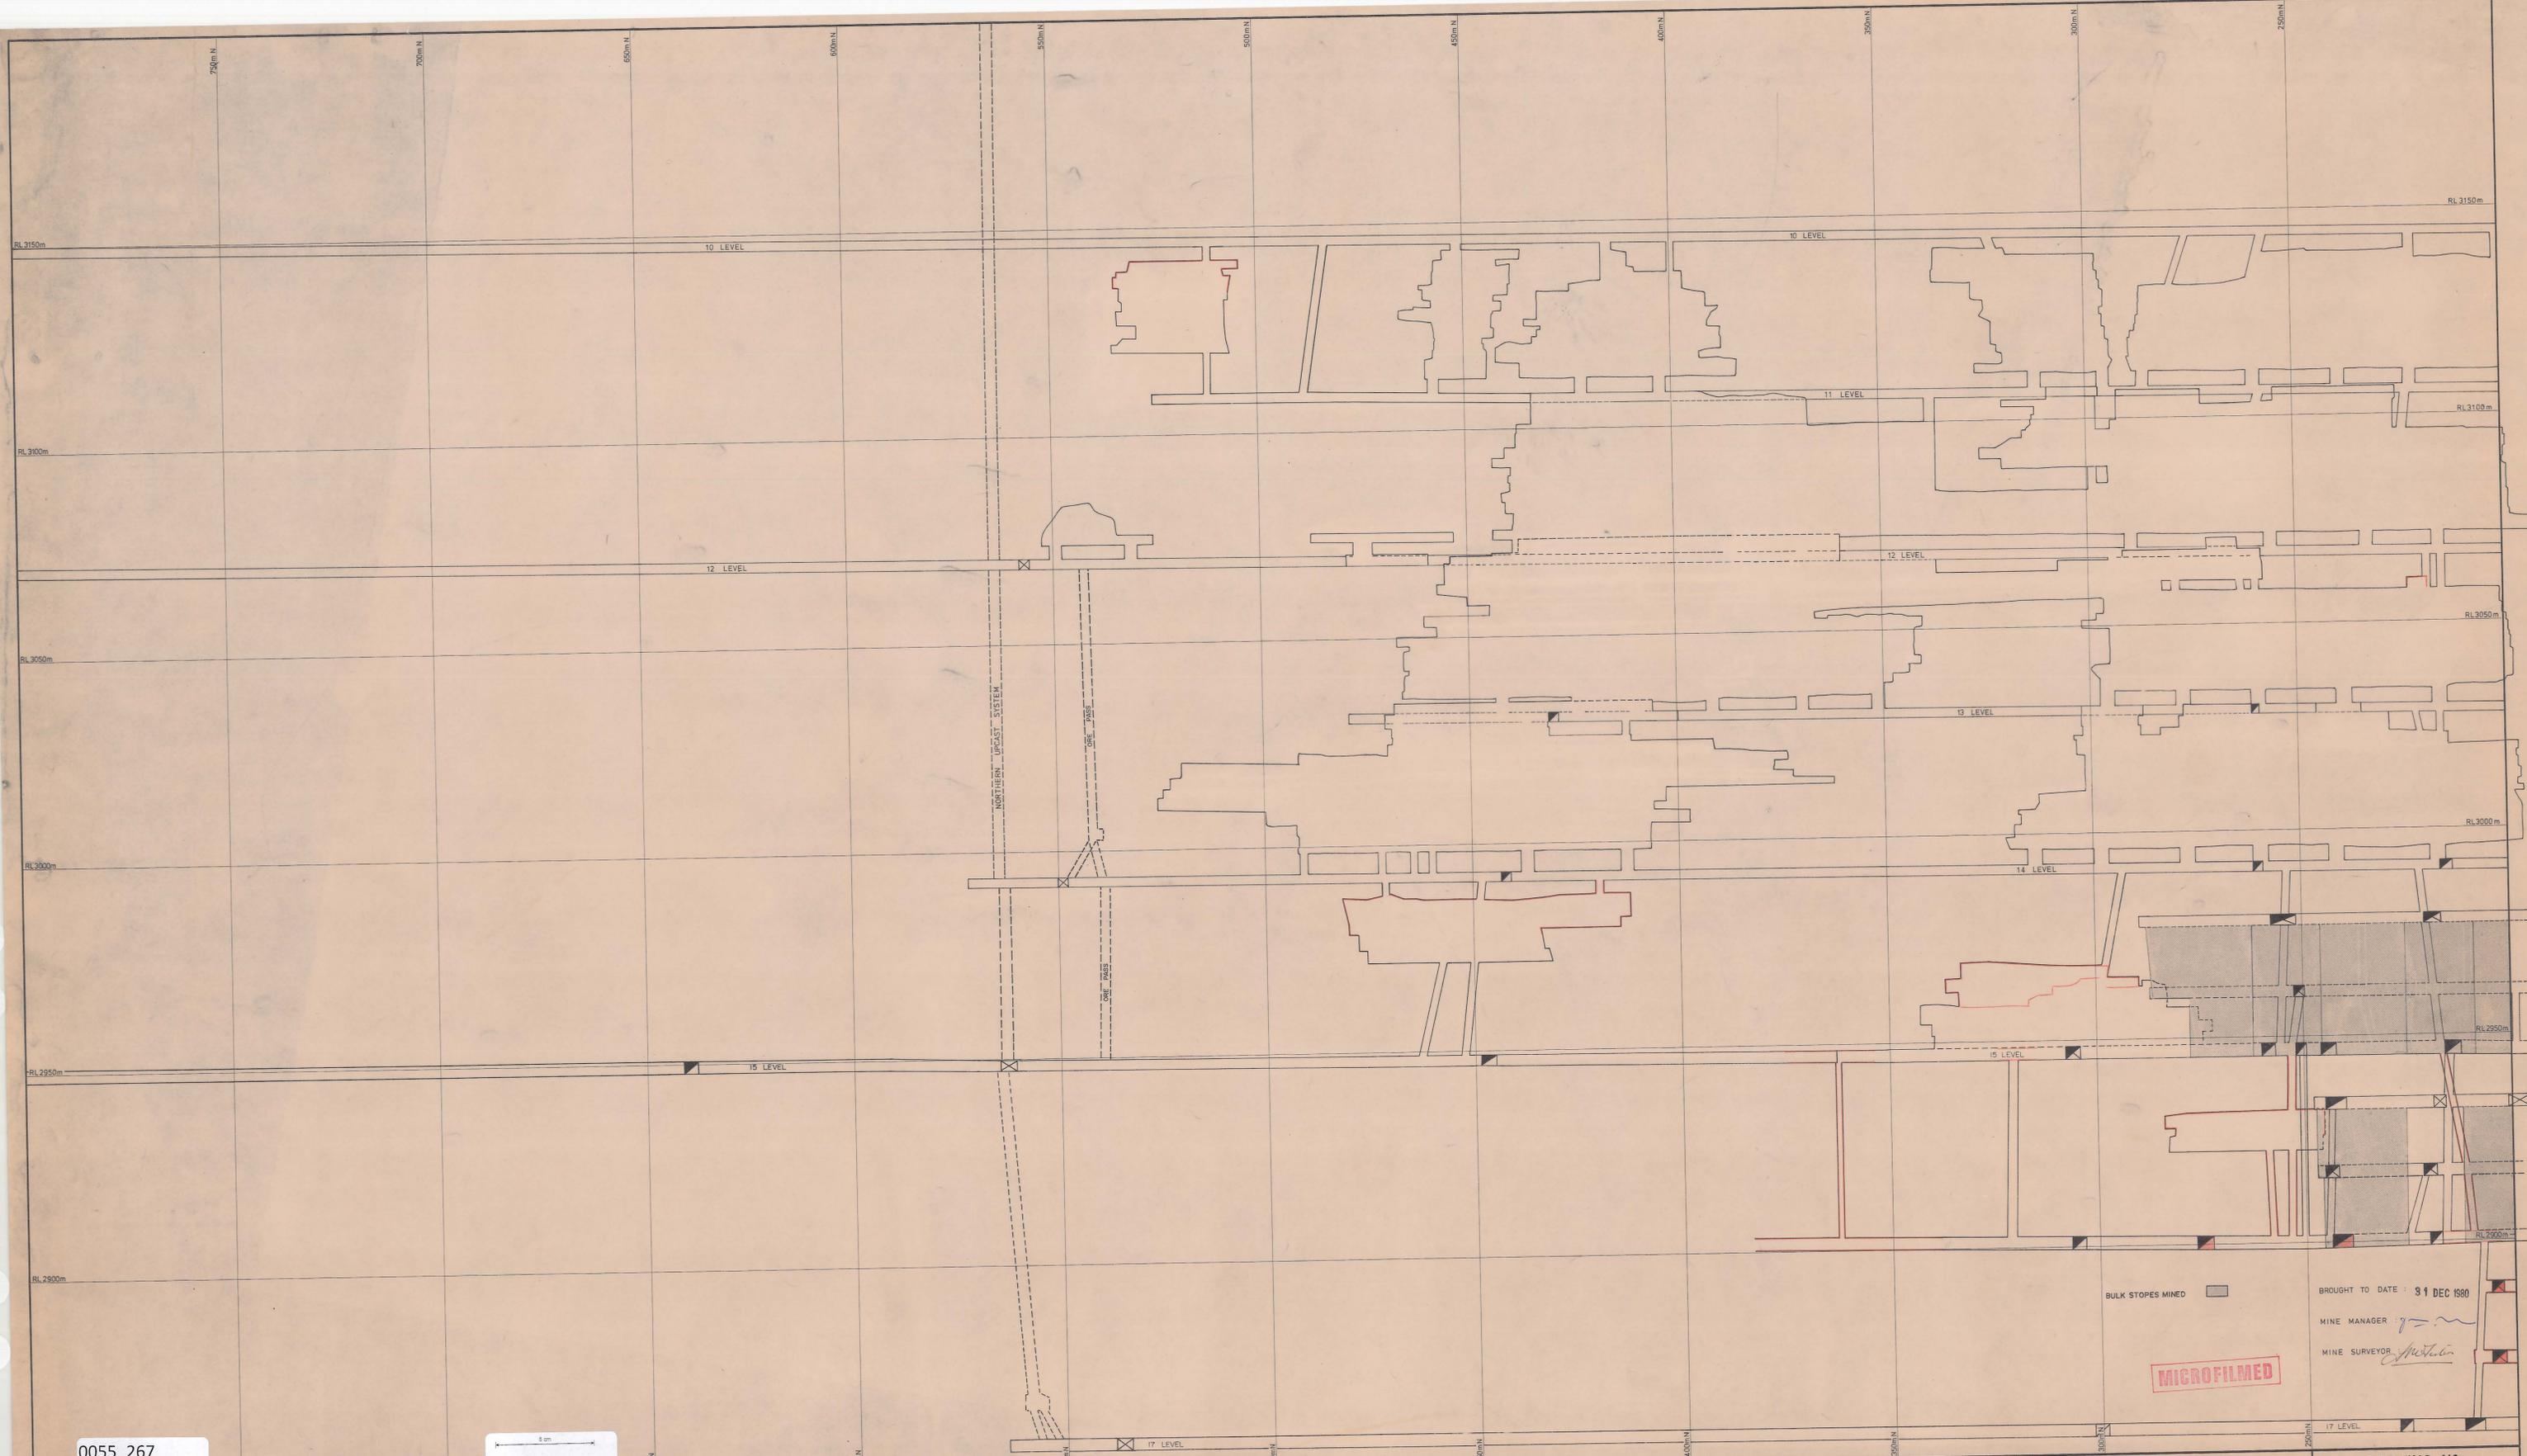

0055\_267

5m

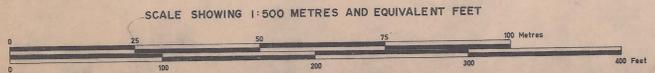

ELECTROLYTIC ZINC COMPANY OF AUSTRALASIA LIMITED  
 WEST COAST MINES, T.A.S.

SURVEY BY		SCALE	1 : 500
DRAWN BY		DATE	1973
TRACED BY	P. J. Lowe	REFERENCE	

ROSEBERY MINE  
 LONGITUDINAL PROJECTION  
 200mN - 800mN - BELOW 10/L.

MICROFILMED

BROUGHT TO DATE : 31 DEC 1980  
 MINE MANAGER *[Signature]*  
 MINE SURVEYOR *[Signature]*

DRAWING N°:  
 DEPARTMENT OF MINES

8/350