


0055_268



0055_268

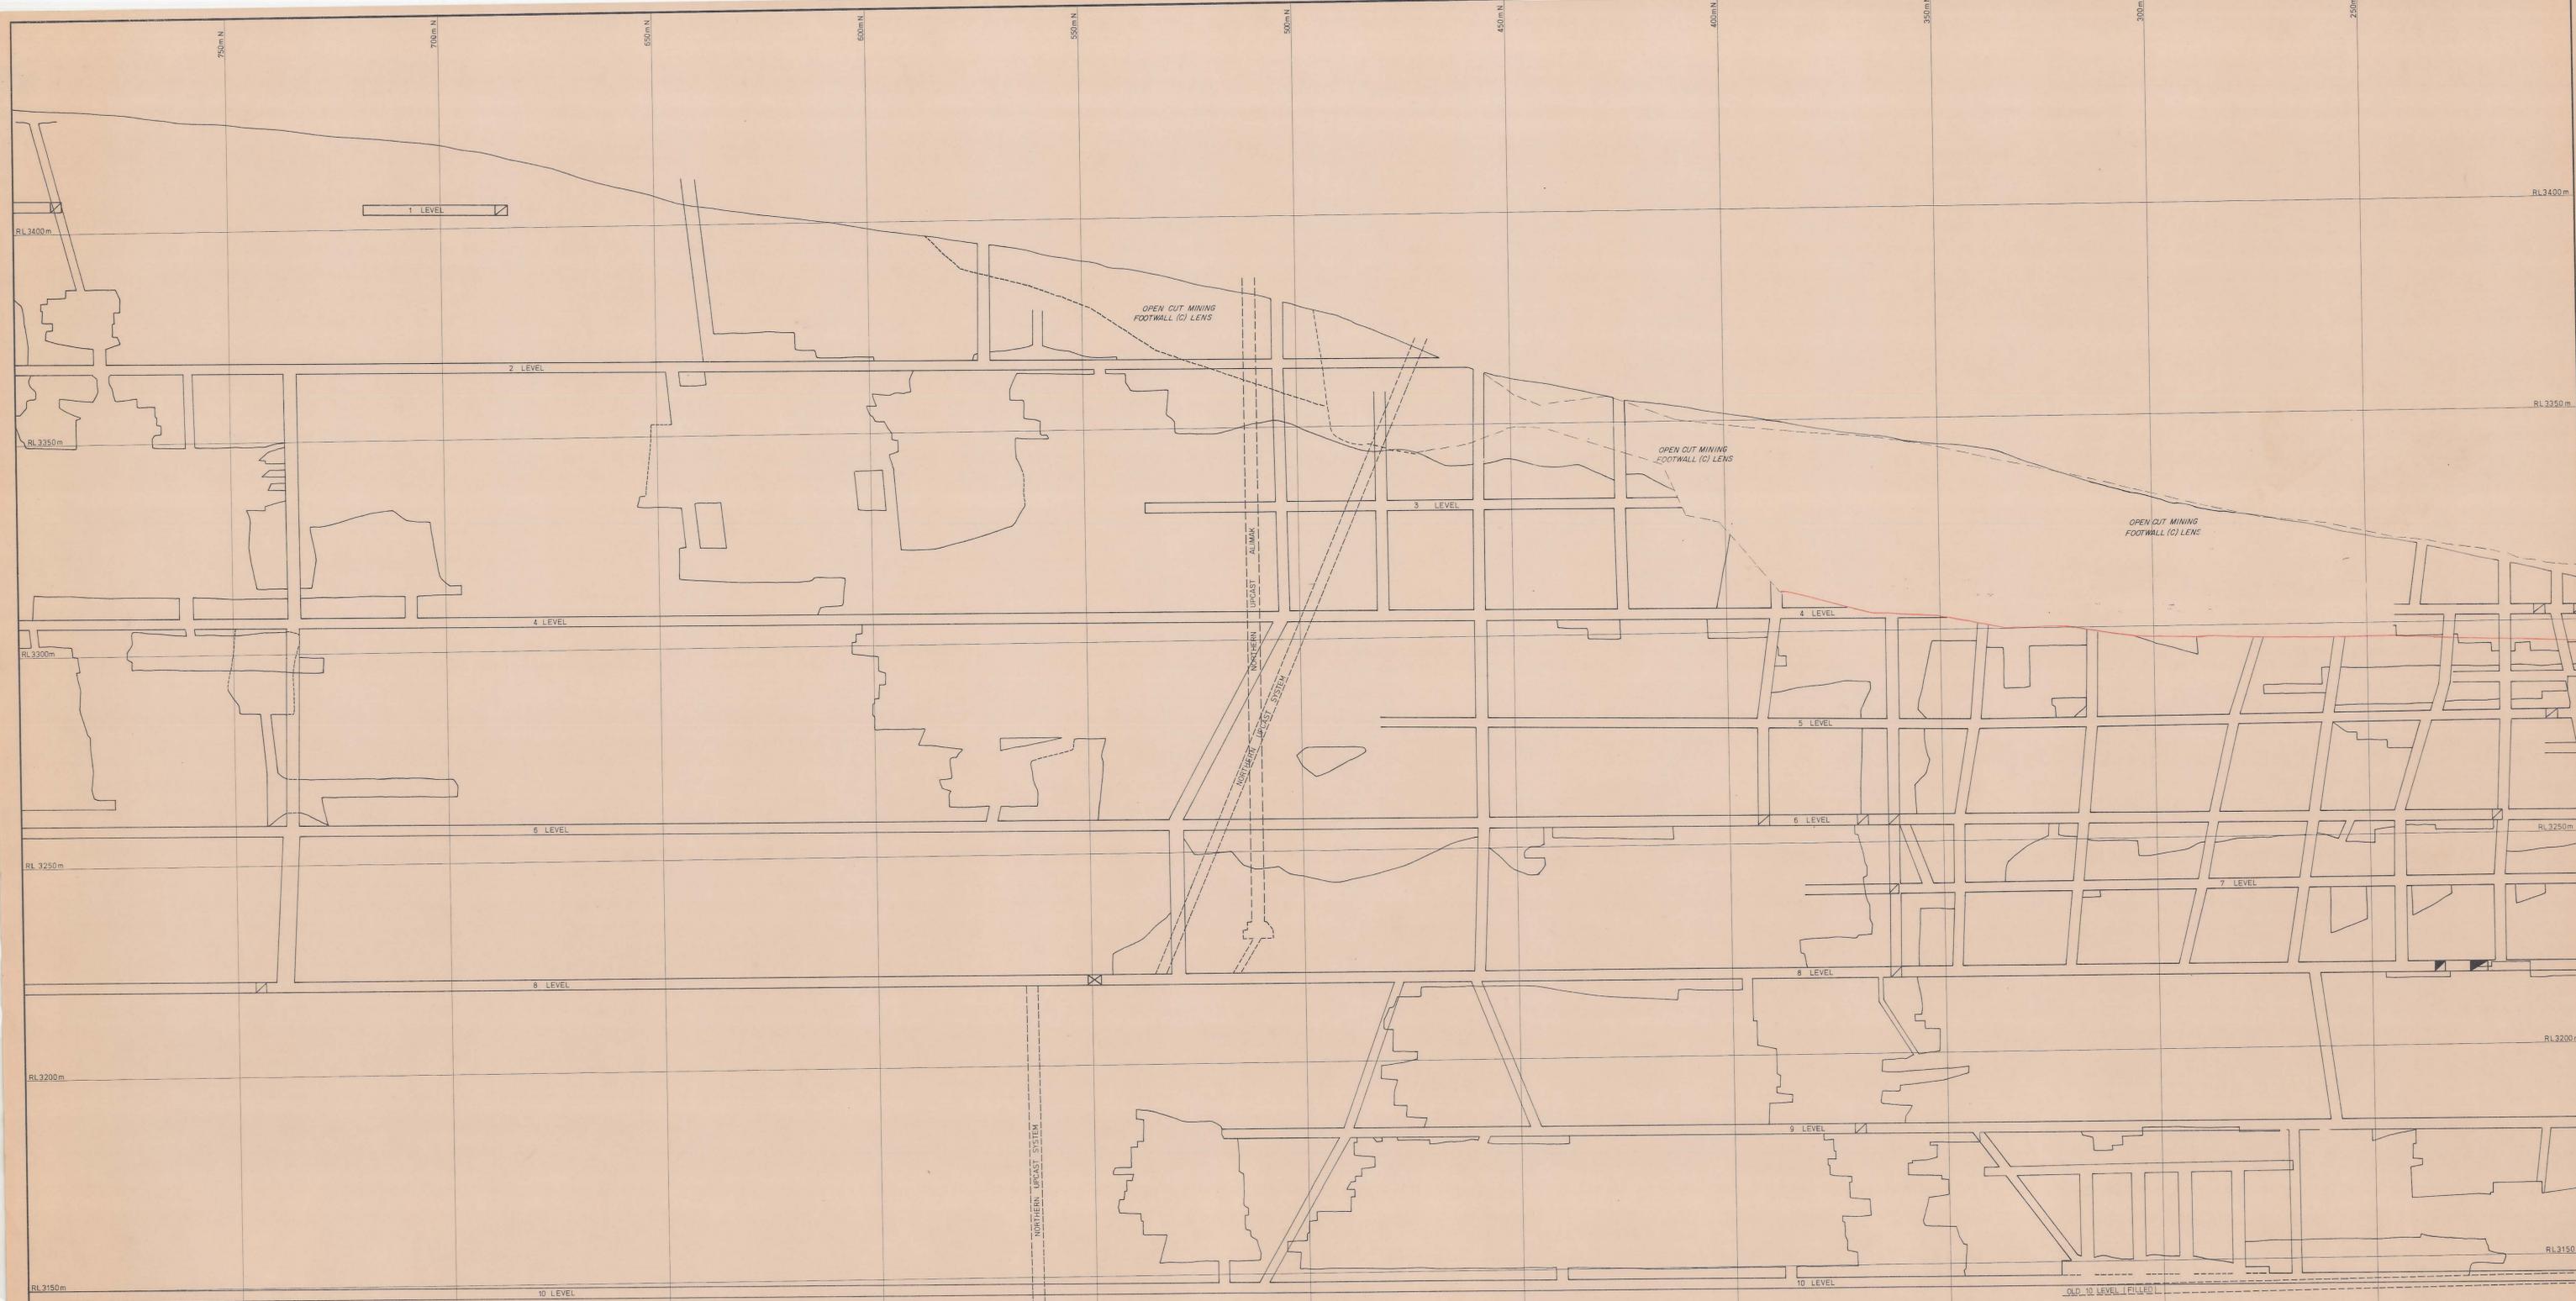

ELECTROLYTIC ZINC COMPANY OF AUSTRALASIA LIMITED
 WEST COAST MINES, T.A.S.

SURVEY BY	SCALE	1 : 500
DRAWN BY	DATE	1973
TRACED BY P. J. Lowe	REFERENCE	

ROSEBERY MINE
 LONGITUDINAL PROJECTION
 200mN-800mN — ABOVE 10/L.

BROUGHT TO DATE **31 DEC 1980**
 MINE MANAGER *[Signature]*
 MINE SURVEYOR *[Signature]*

MICROFILMED

DRAWING N^o:
 DEPARTMENT OF MINES

81351