


0055\_269



0055\_269

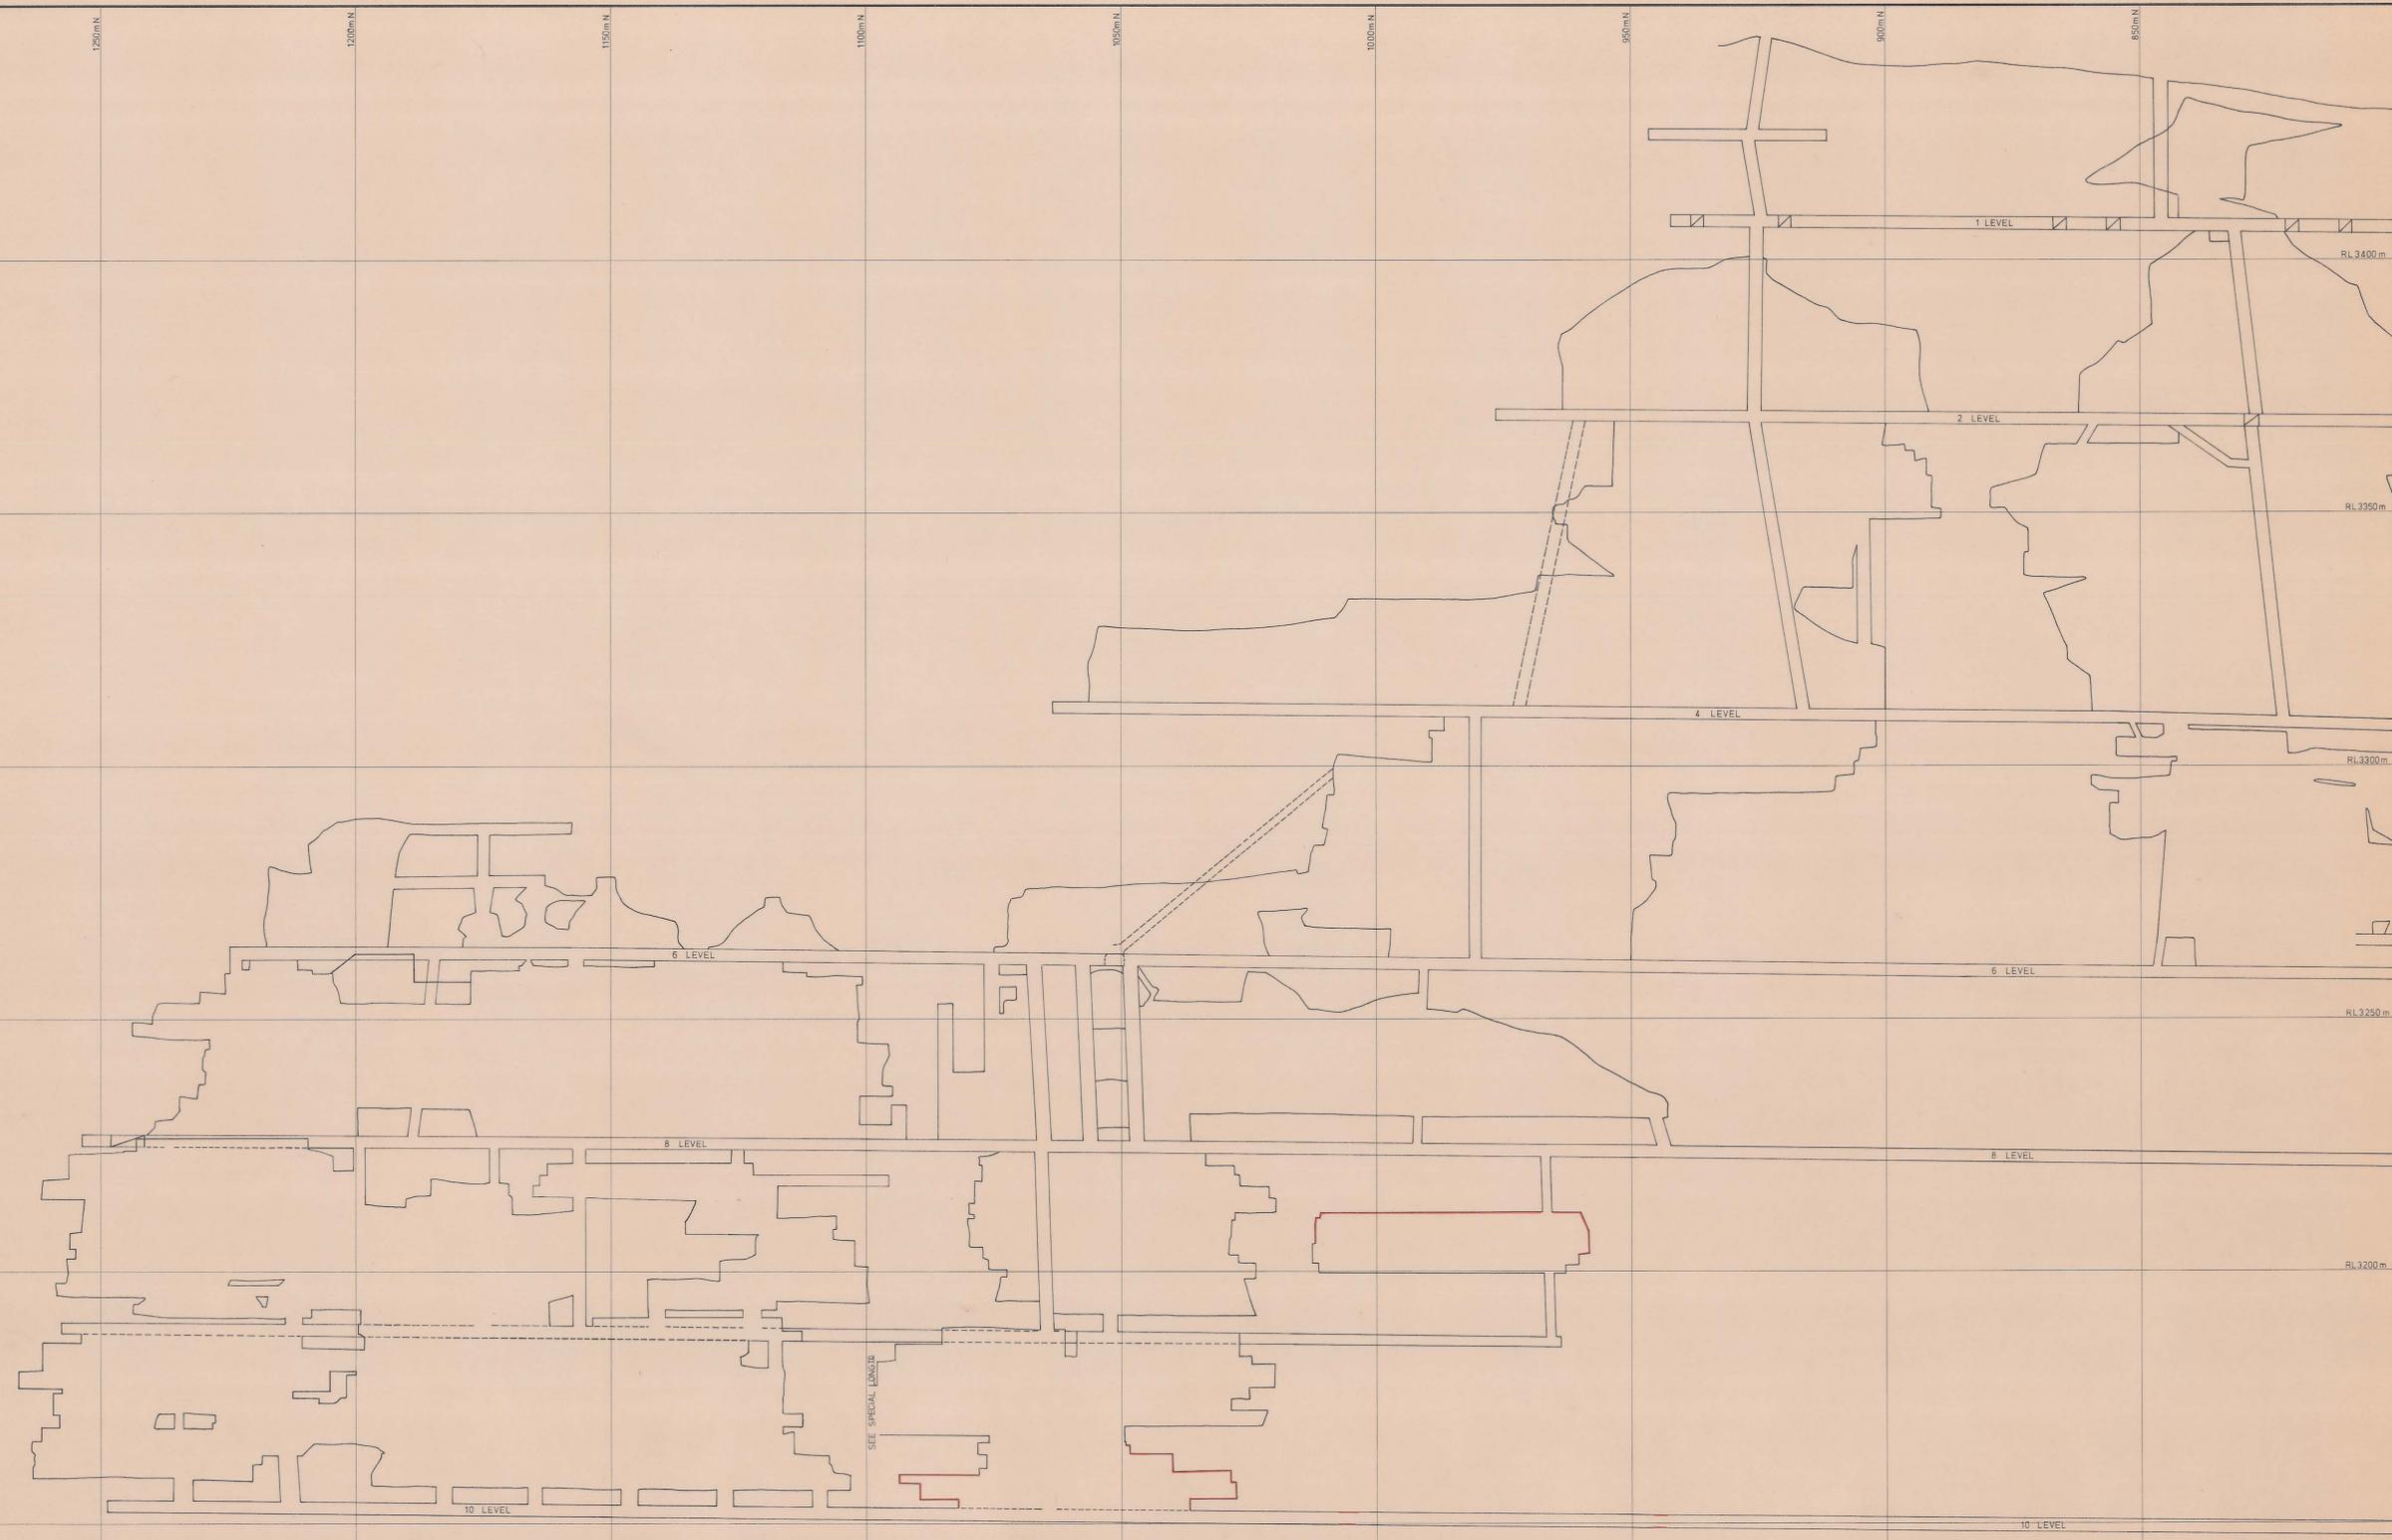

SCALE SHOWING 1:500 METRES AND EQUIVALENT FEET



ELECTROLYTIC ZINC COMPANY OF AUSTRALASIA LIMITED  
 WEST COAST MINES, TAS.

SURVEY BY		SCALE	1 : 500
DRAWN BY		DATE	1973
TRACED BY	P. J. Lowe	REFERENCE	

ROSEBERY MINE  
 LONGITUDINAL PROJECTION  
 NORTH END — ABOVE 10/L

MICROFILMED

BROUGHT TO DATE : 31 DEC 1980  
 MINE MANAGER : *[Signature]*  
 MINE SURVEYOR : *[Signature]*

DRAWING N° :  
 DEPARTMENT OF MINES

81/352