



0055_270

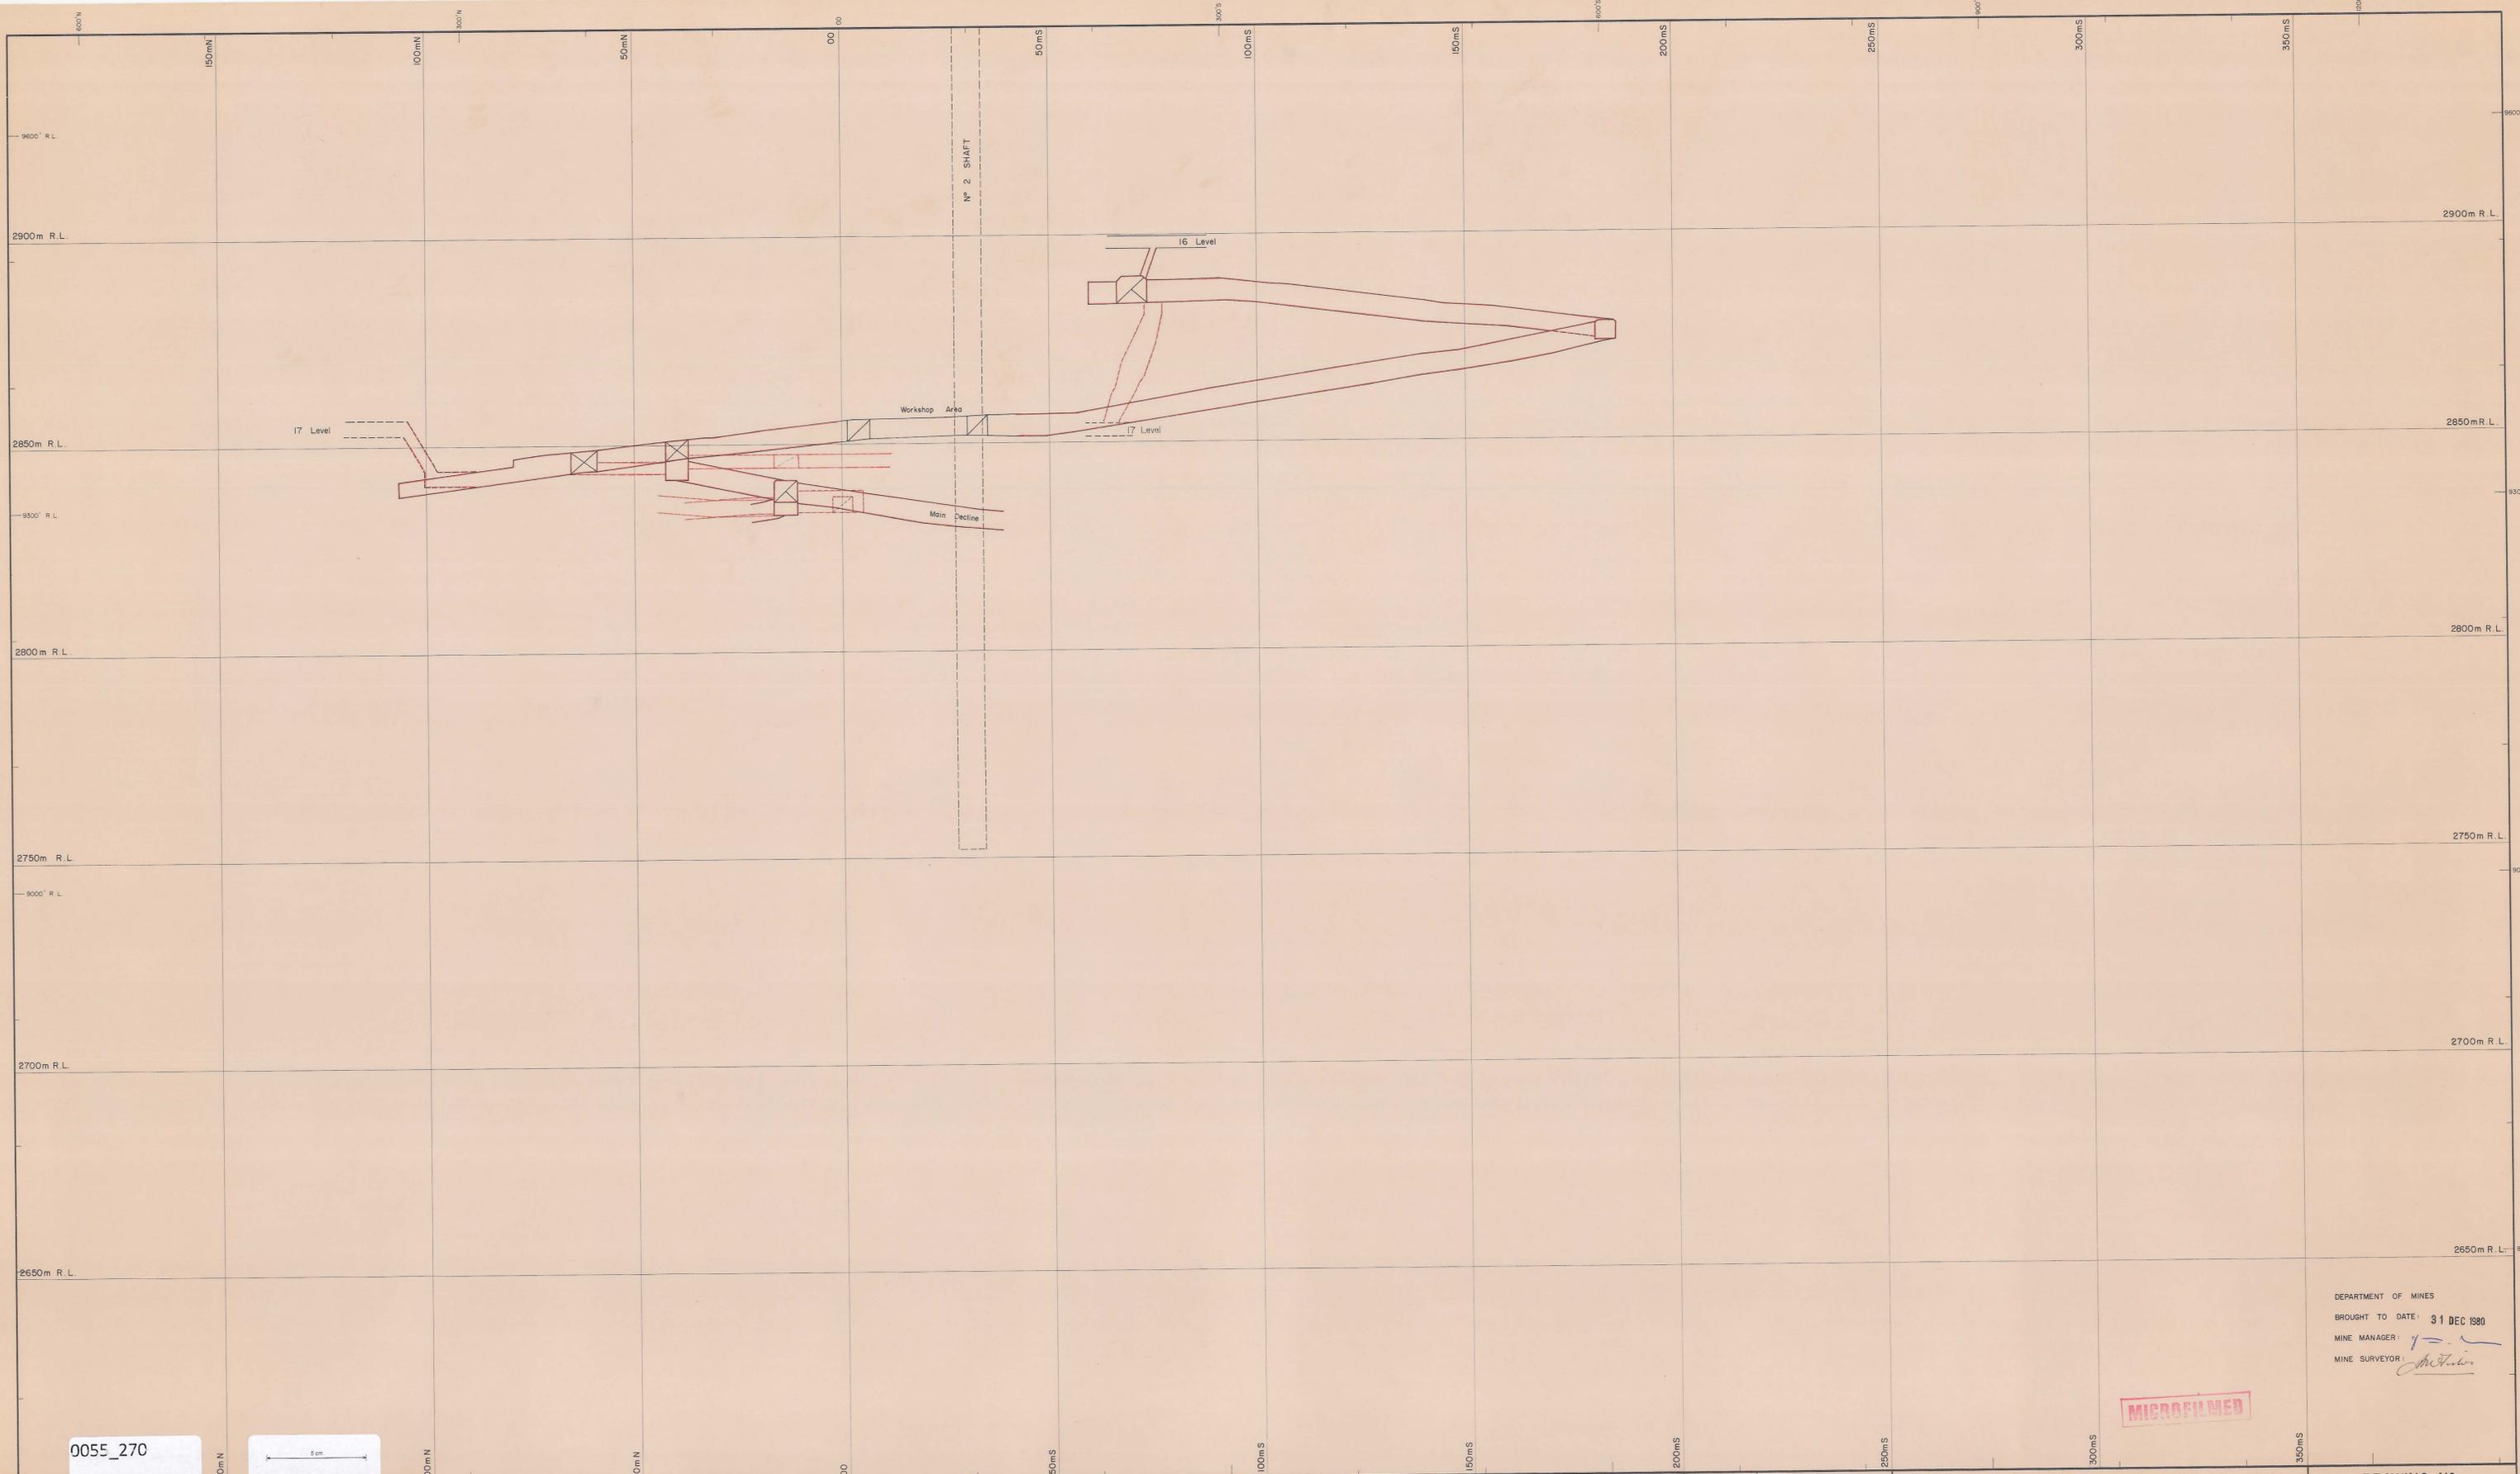

0055_270

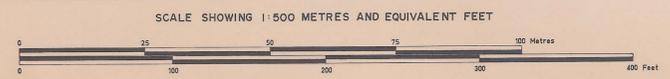

ELECTROLYTIC ZINC COMPANY OF AUSTRALASIA LIMITED
WEST COAST MINES, T.A.S.

SURVEY BY	SCALE	1:500
DRAWN BY K. CAREY	DATE	19 05 90
TRACED BY A. G. MORRISON	REFERENCE	

ROSEBERY MINE
LONGITUDINAL PROJECTION
DECLINE SPECIAL

DRAWING N°:
DEPARTMENT OF MINES
81353

DEPARTMENT OF MINES
BROUGHT TO DATE: 31 DEC 1980
MINE MANAGER: *[Signature]*
MINE SURVEYOR: *[Signature]*

MICROFILMED