

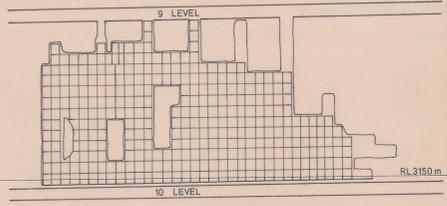


0055_271

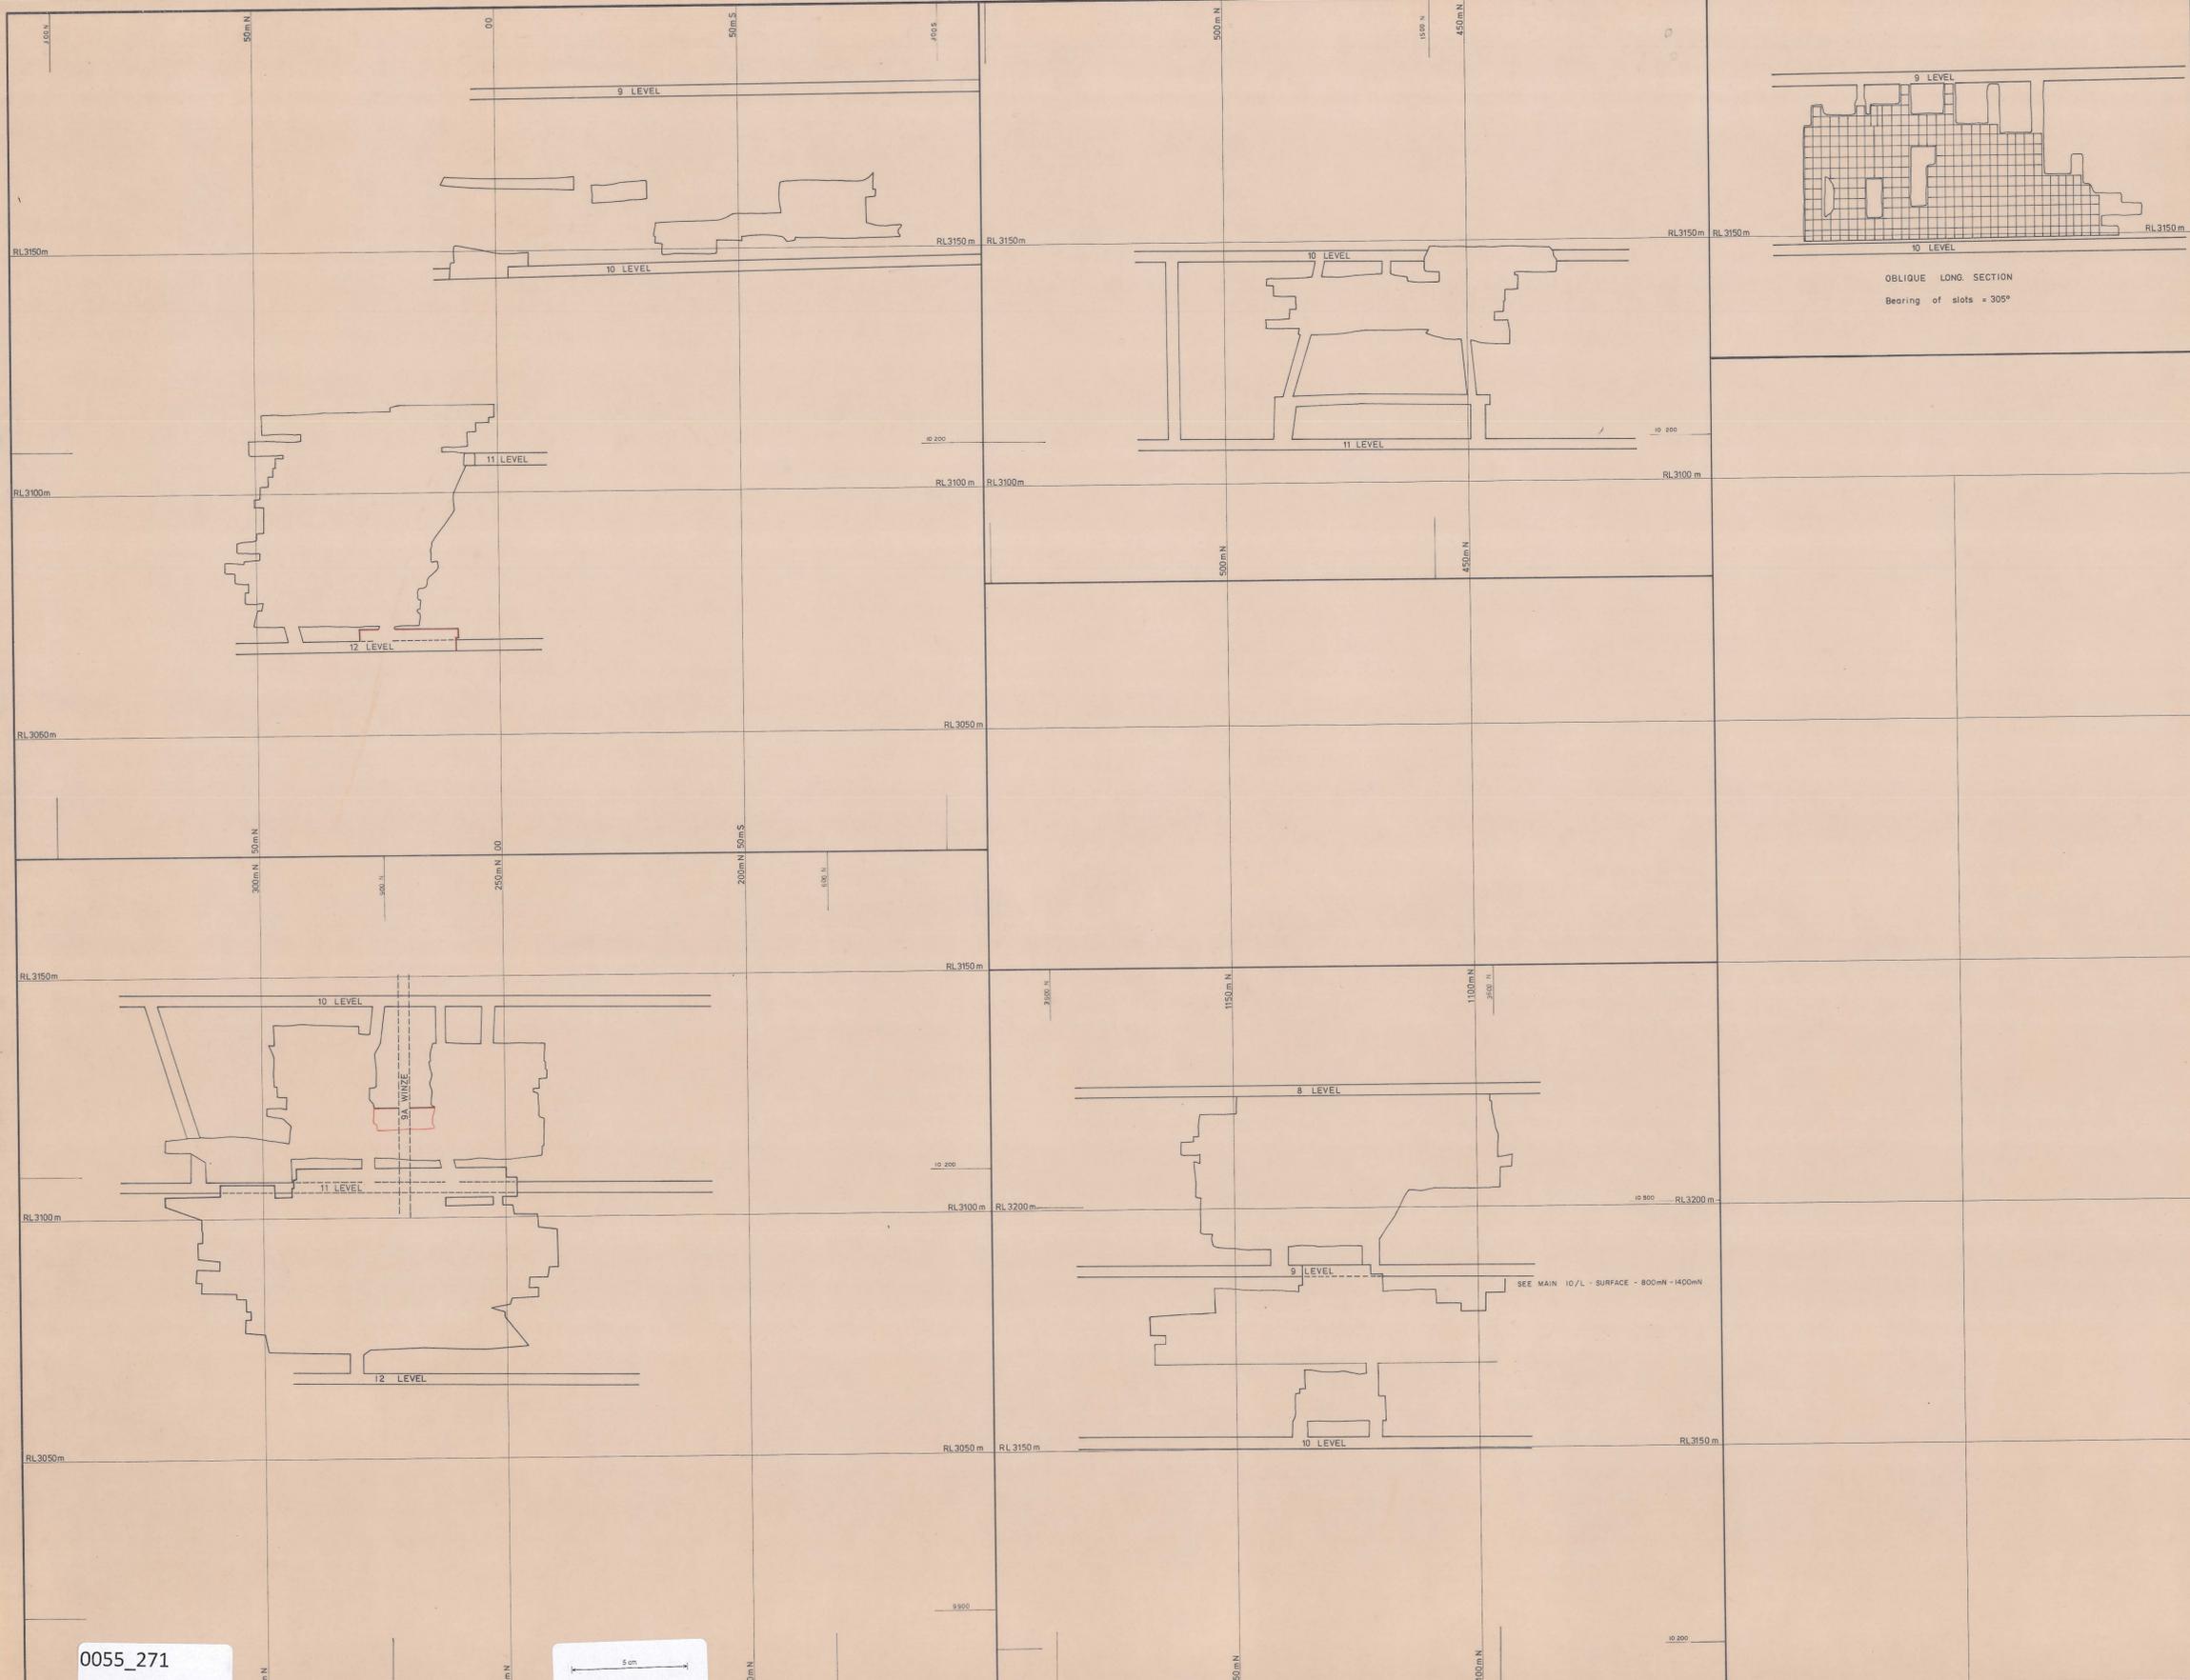

OBLIQUE LONG SECTION
Bearing of slots = 305°

0055_271

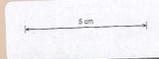

SCALE SHOWING 1:500 METRES AND EQUIVALENT FEET



ELECTROLYTIC ZINC COMPANY OF AUSTRALASIA LIMITED
WEST COAST MINES, T.A.S.

SURVEY BY	SCALE	1 : 500
DRAWN BY	DATE	1973
TRACED BY P. J. Lowe	REFERENCE	

ROSEBERY MINE
LONGITUDINAL PROJECTION
SPECIFIC STOPES

BROUGHT TO DATE : 31 DEC 1980
MINE MANAGER : *[Signature]*
MINE SURVEYOR : *[Signature]*

MICROFILMED

DRAWING N° :
DEPARTMENT OF MINES
81354