



0055_272

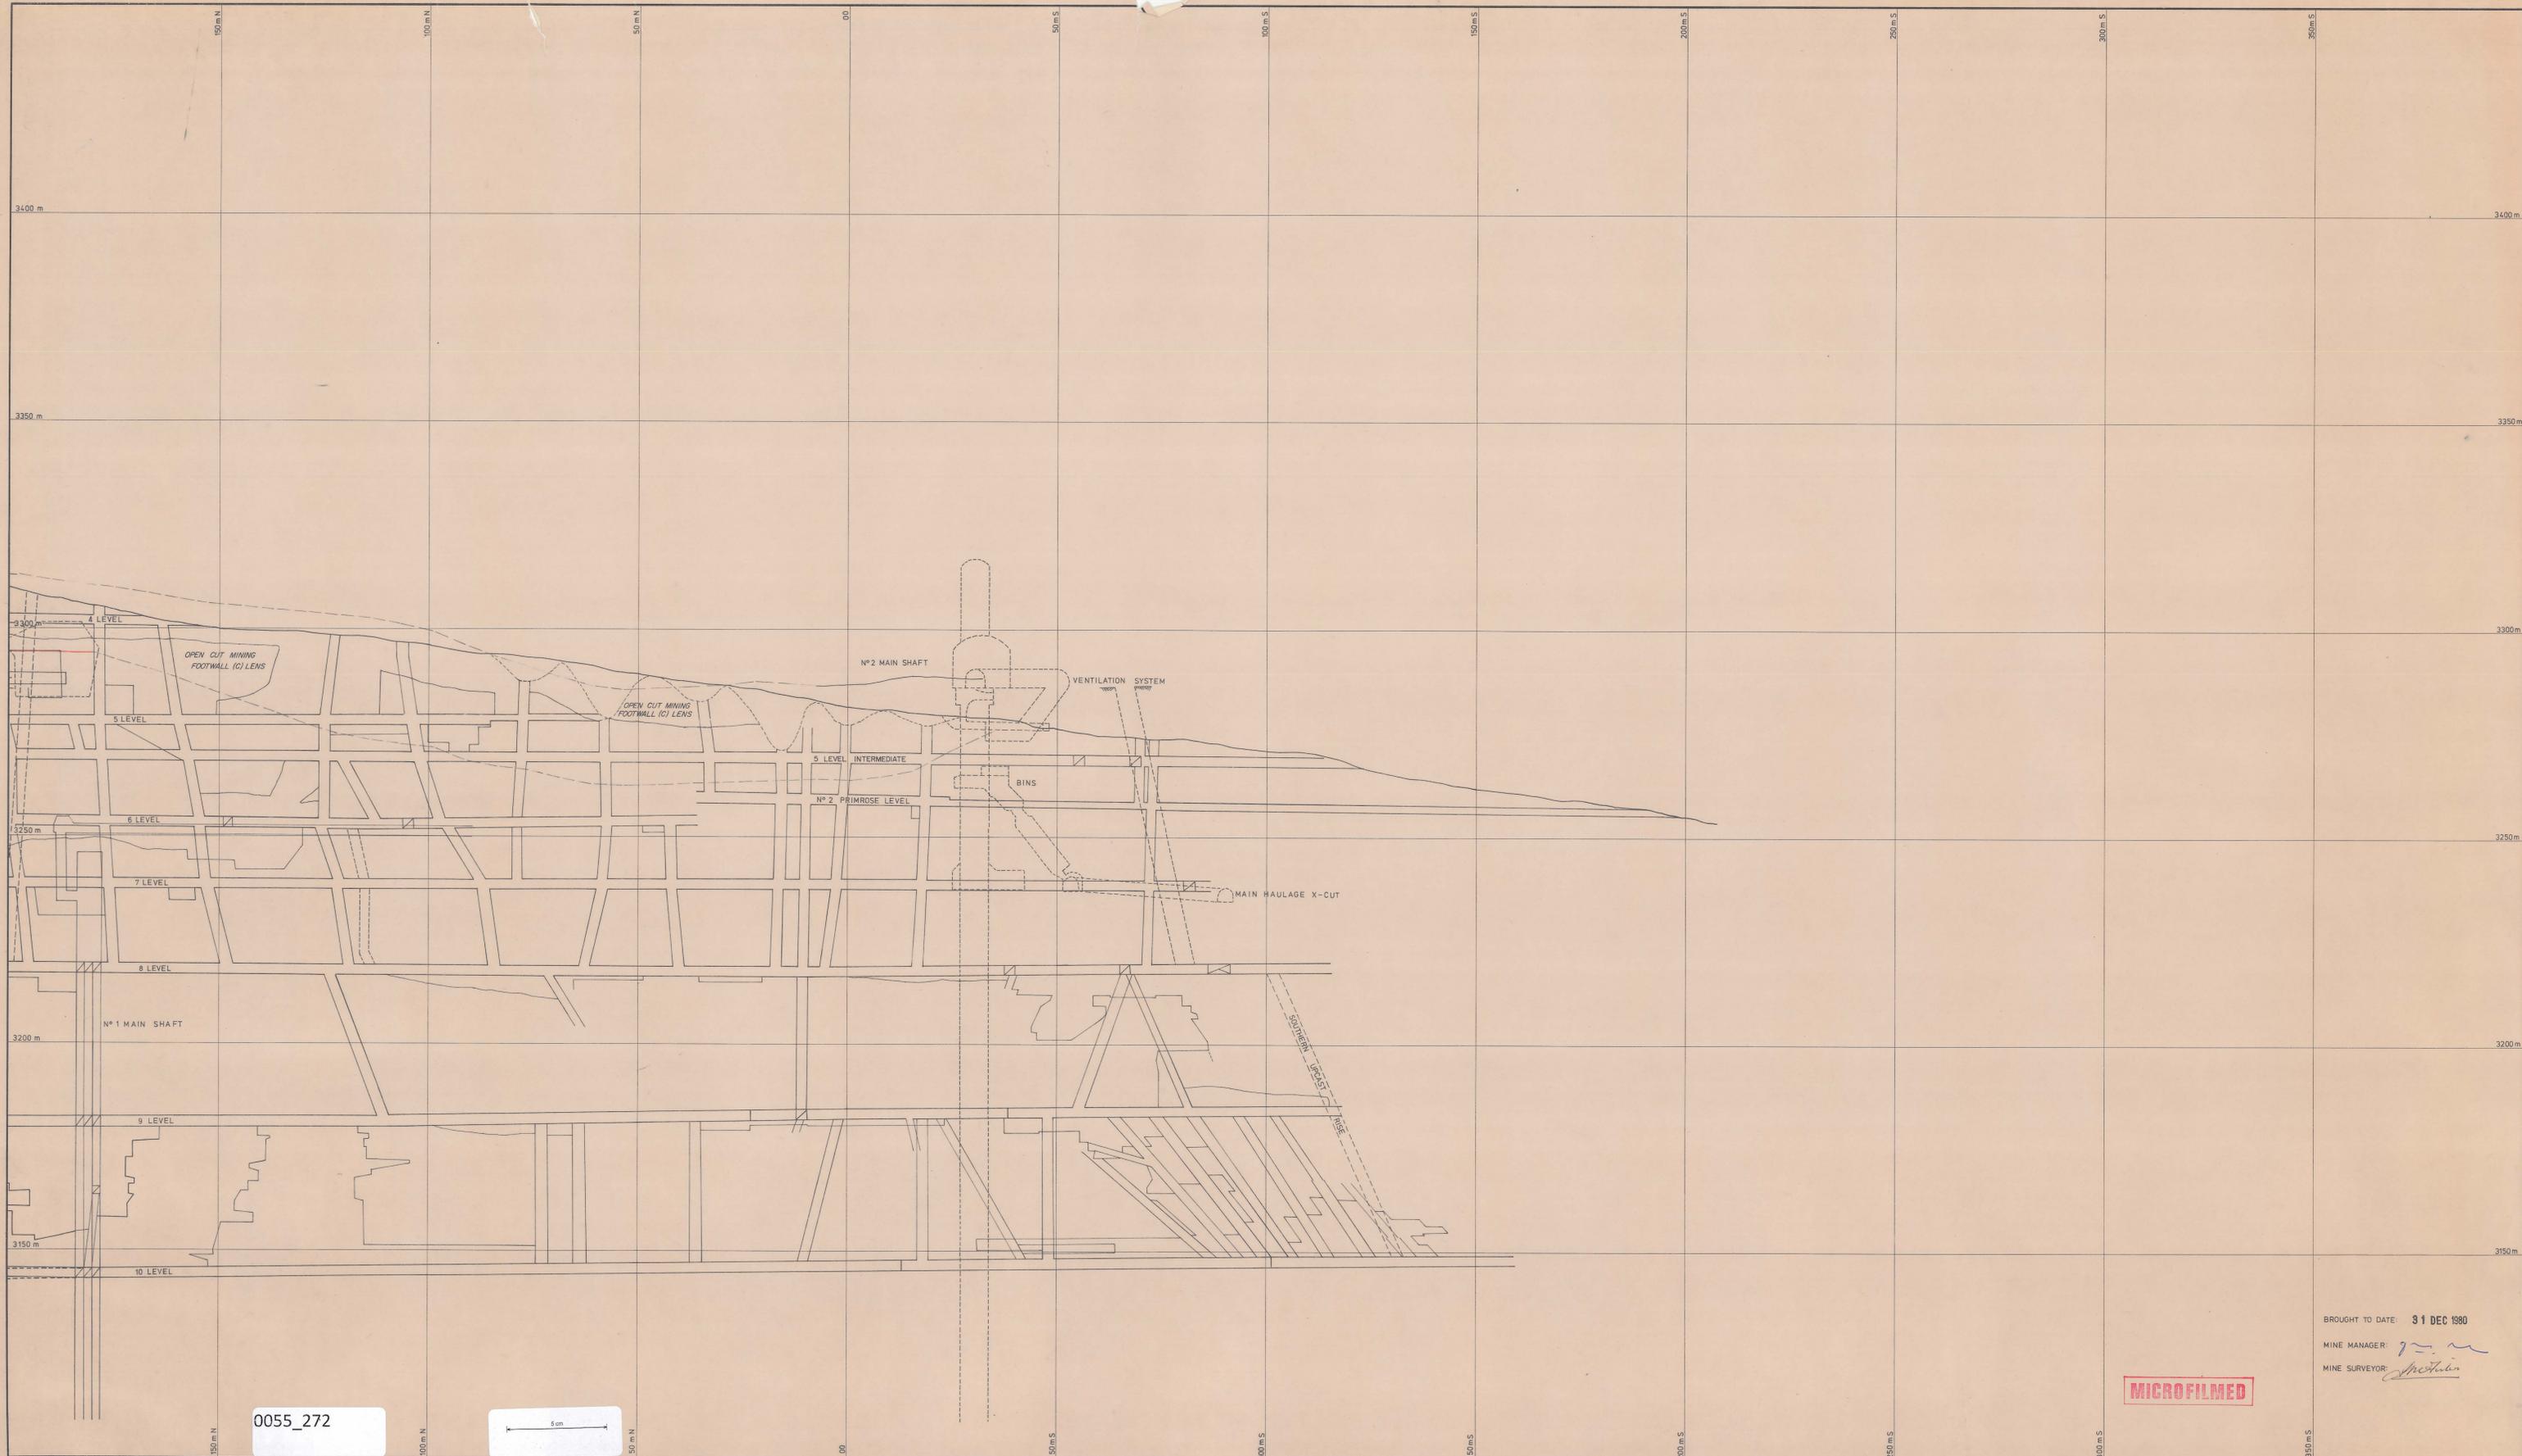


0055_272

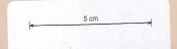

MICROFILMED

BROUGHT TO DATE: 31 DEC 1980
 MINE MANAGER: *[Signature]*
 MINE SURVEYOR: *[Signature]*

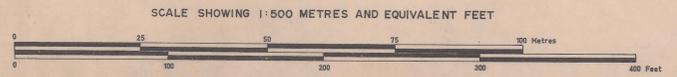

ELECTROLYTIC ZINC COMPANY OF AUSTRALASIA LIMITED
 WEST COAST MINES, T.A.S.

SURVEY BY		SCALE	1 : 500 METRES
DRAWN BY		DATE	1973
TRACED BY	S. M. Burrows	REFERENCE	

ROSEBERY MINE
 LONGITUDINAL PROJECTION
 10 LEVEL - SURFACE

DRAWING N°:
 DEPARTMENT OF MINES
 PLAN 81355