



0055_273



0055_273

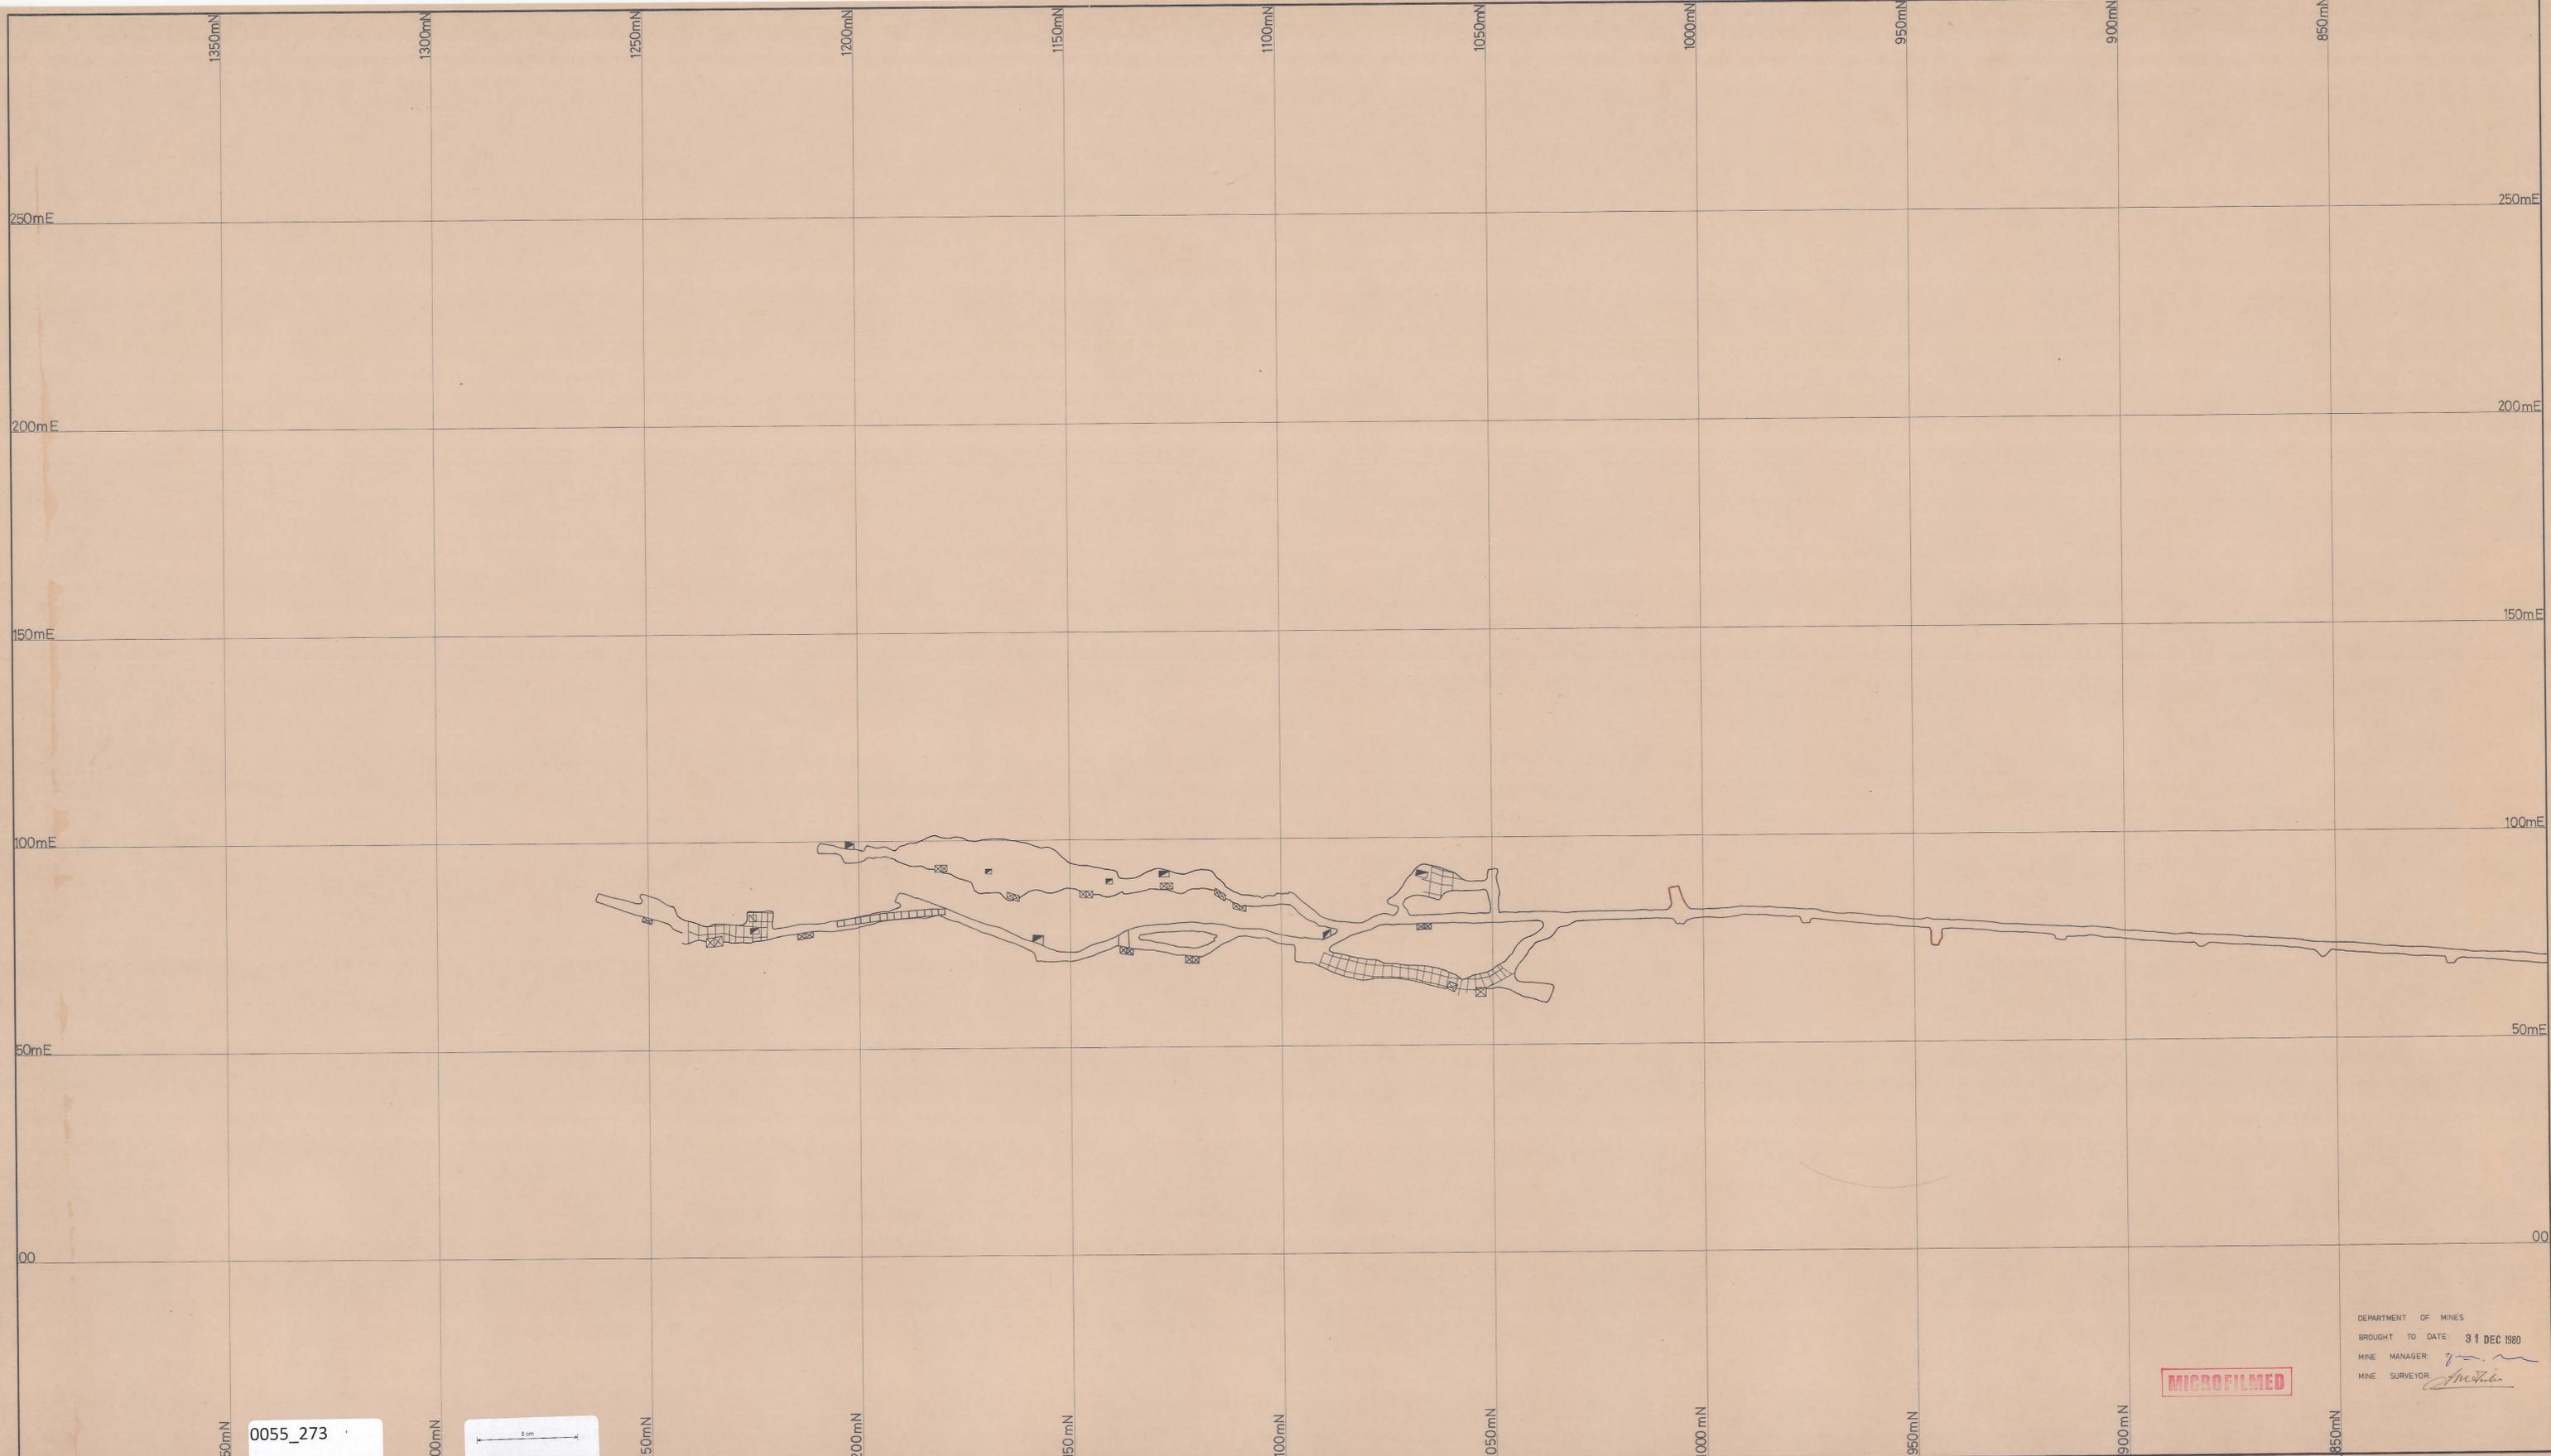

SCALE SHOWING 1:500 METRES AND EQUIVALENT FEET

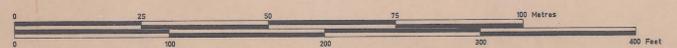

ELECTROLYTIC ZINC COMPANY OF AUSTRALASIA LIMITED
WEST COAST MINES, T.A.S.

SURVEY BY		SCALE	1:500
DRAWN BY		DATE	1975
TRACED BY	RJR	REFERENCE	

ROSEBERRY MINE
Nº 10 LEVEL ①

MICROFILMED

DEPARTMENT OF MINES
BROUGHT TO DATE: 31 DEC 1980
MINE MANAGER: *[Signature]*
MINE SURVEYOR: *[Signature]*

DRAWING Nº: ① ② ③
8/356