



0055_277

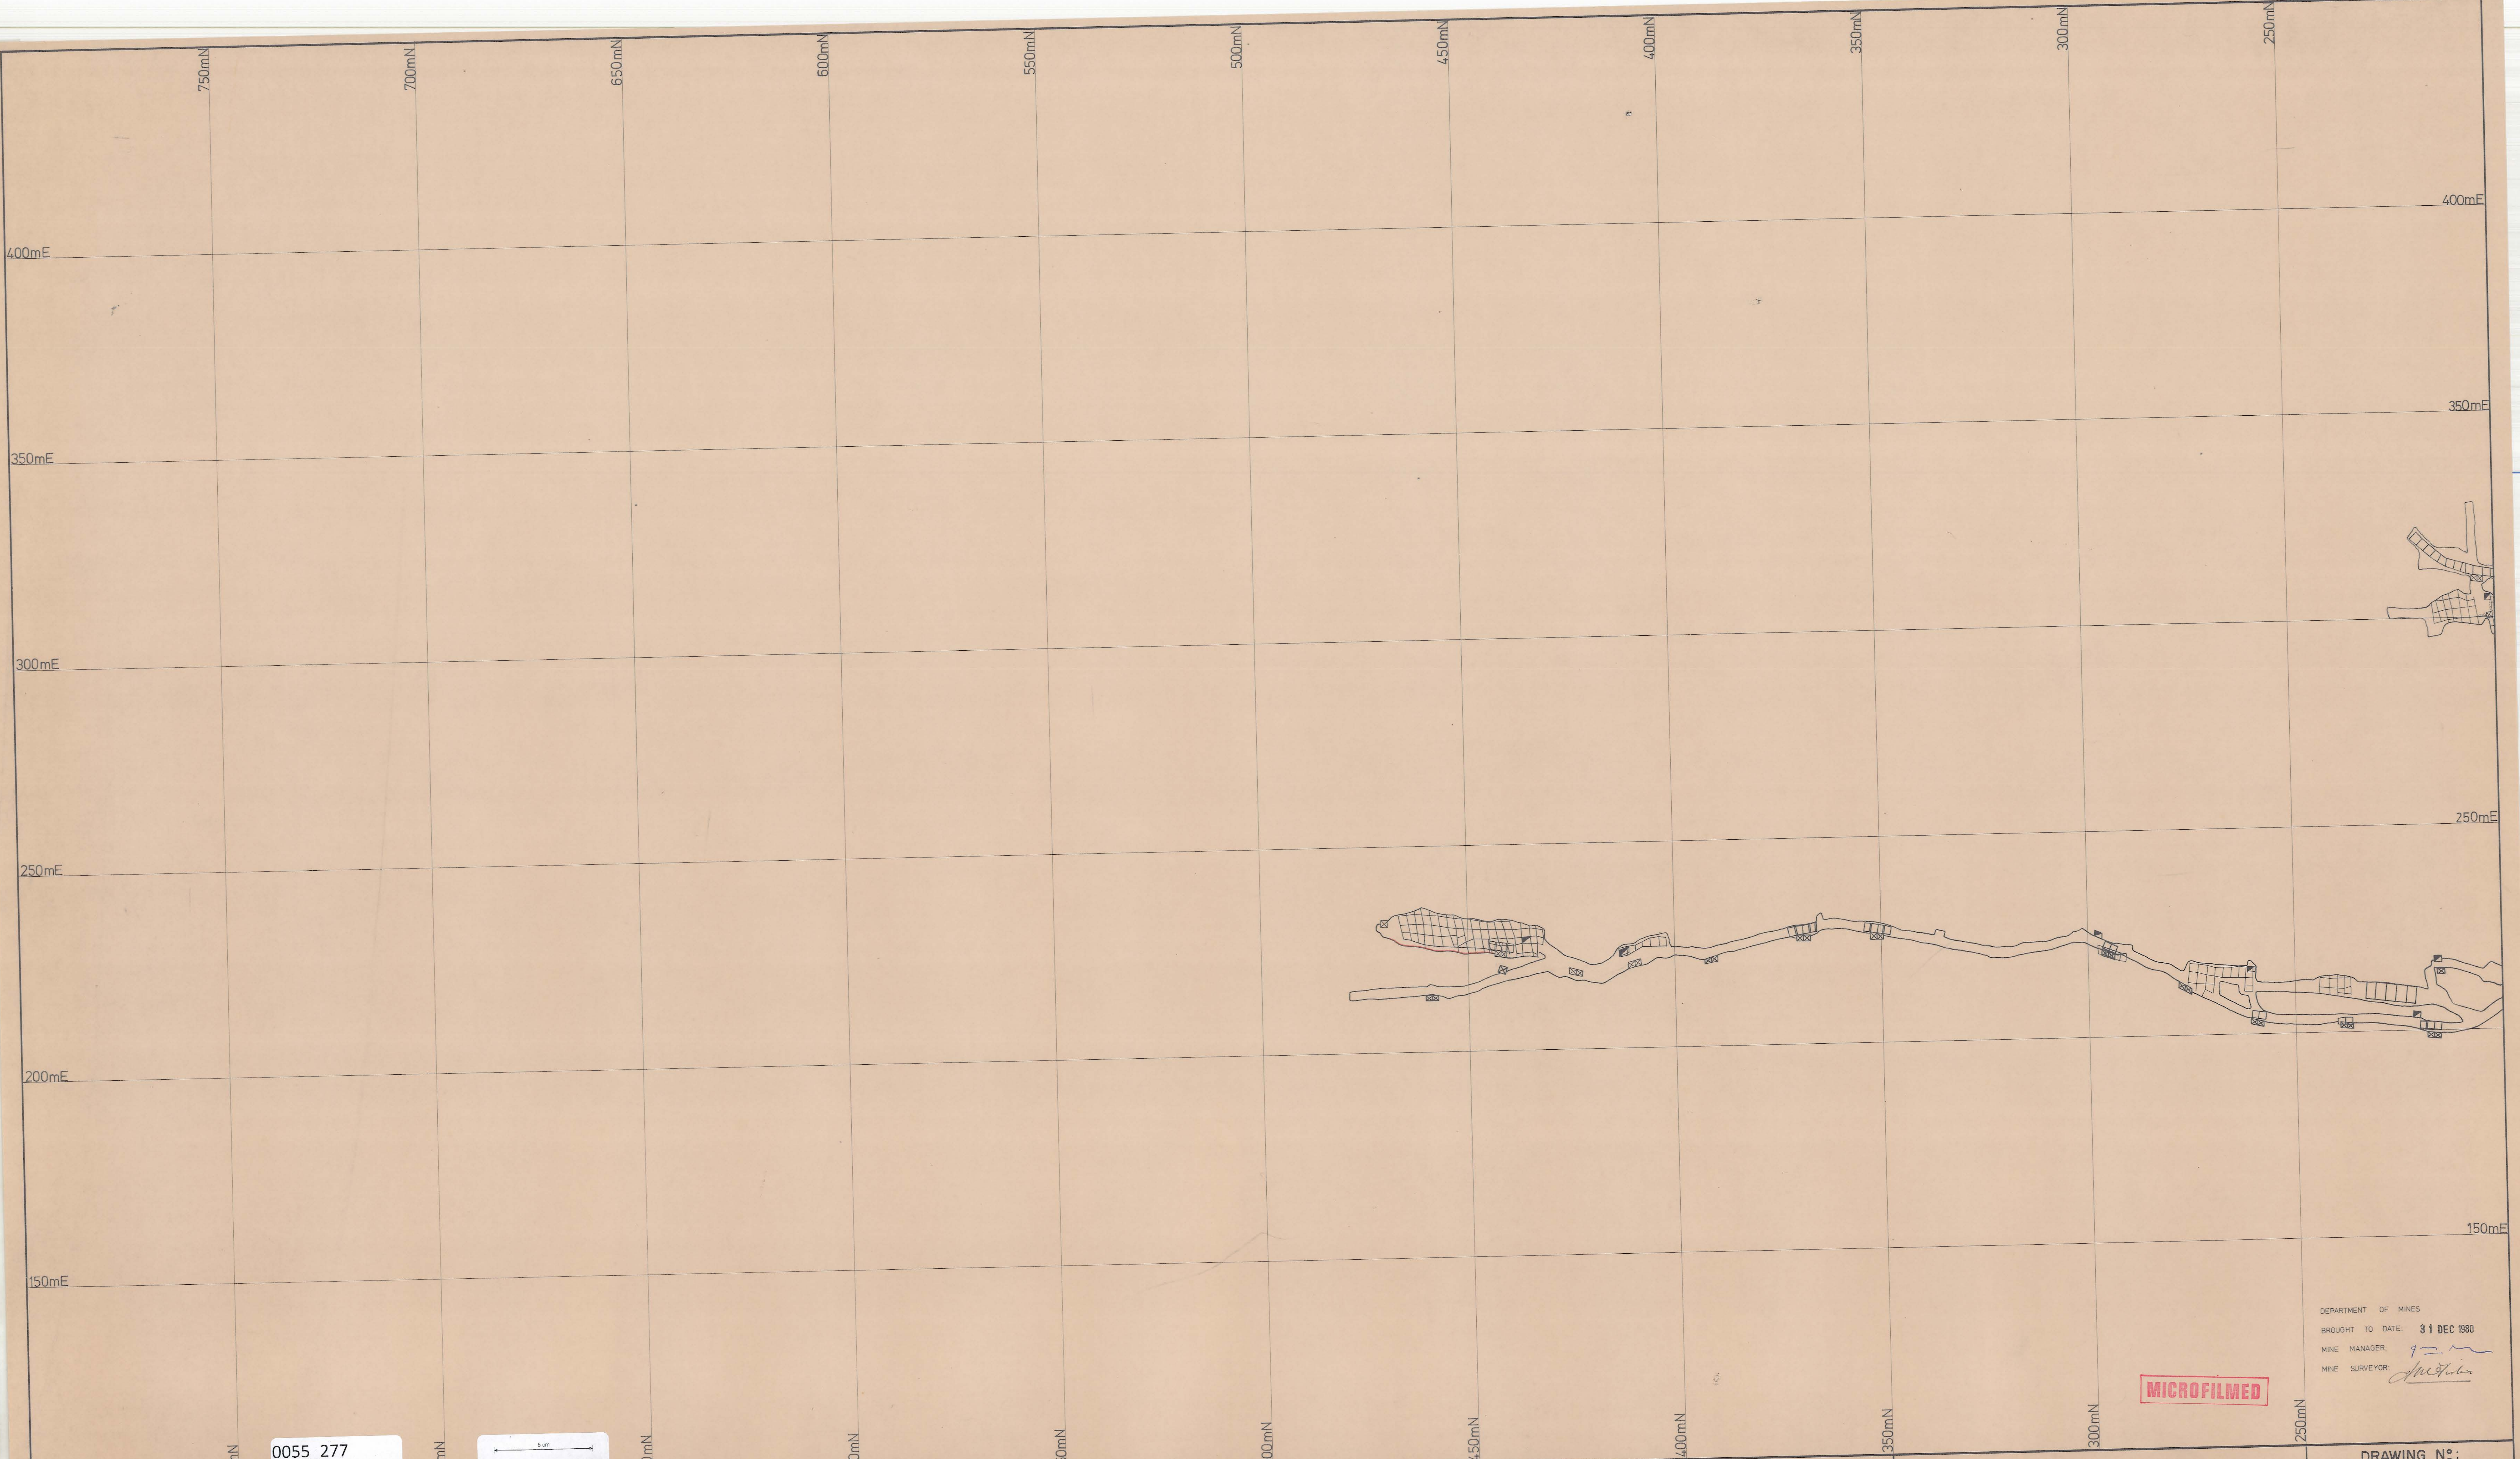

0055_277

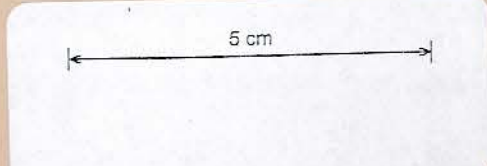

ELECTROLYTIC ZINC COMPANY OF AUSTRALASIA LIMITED
WEST COAST MINES, T.A.S.

SURVEY BY		SCALE	1 : 500
DRAWN BY		DATE	1975
TRACED BY	I.T.M.	REFERENCE	

ROSEBERY MINE
No 13 LEVEL ①

MICROFILMED

DEPARTMENT OF MINES
BROUGHT TO DATE: 31 DEC 1980
MINE MANAGER: *[Signature]*
MINE SURVEYOR: *[Signature]*

DRAWING No:



81360