



0055_279

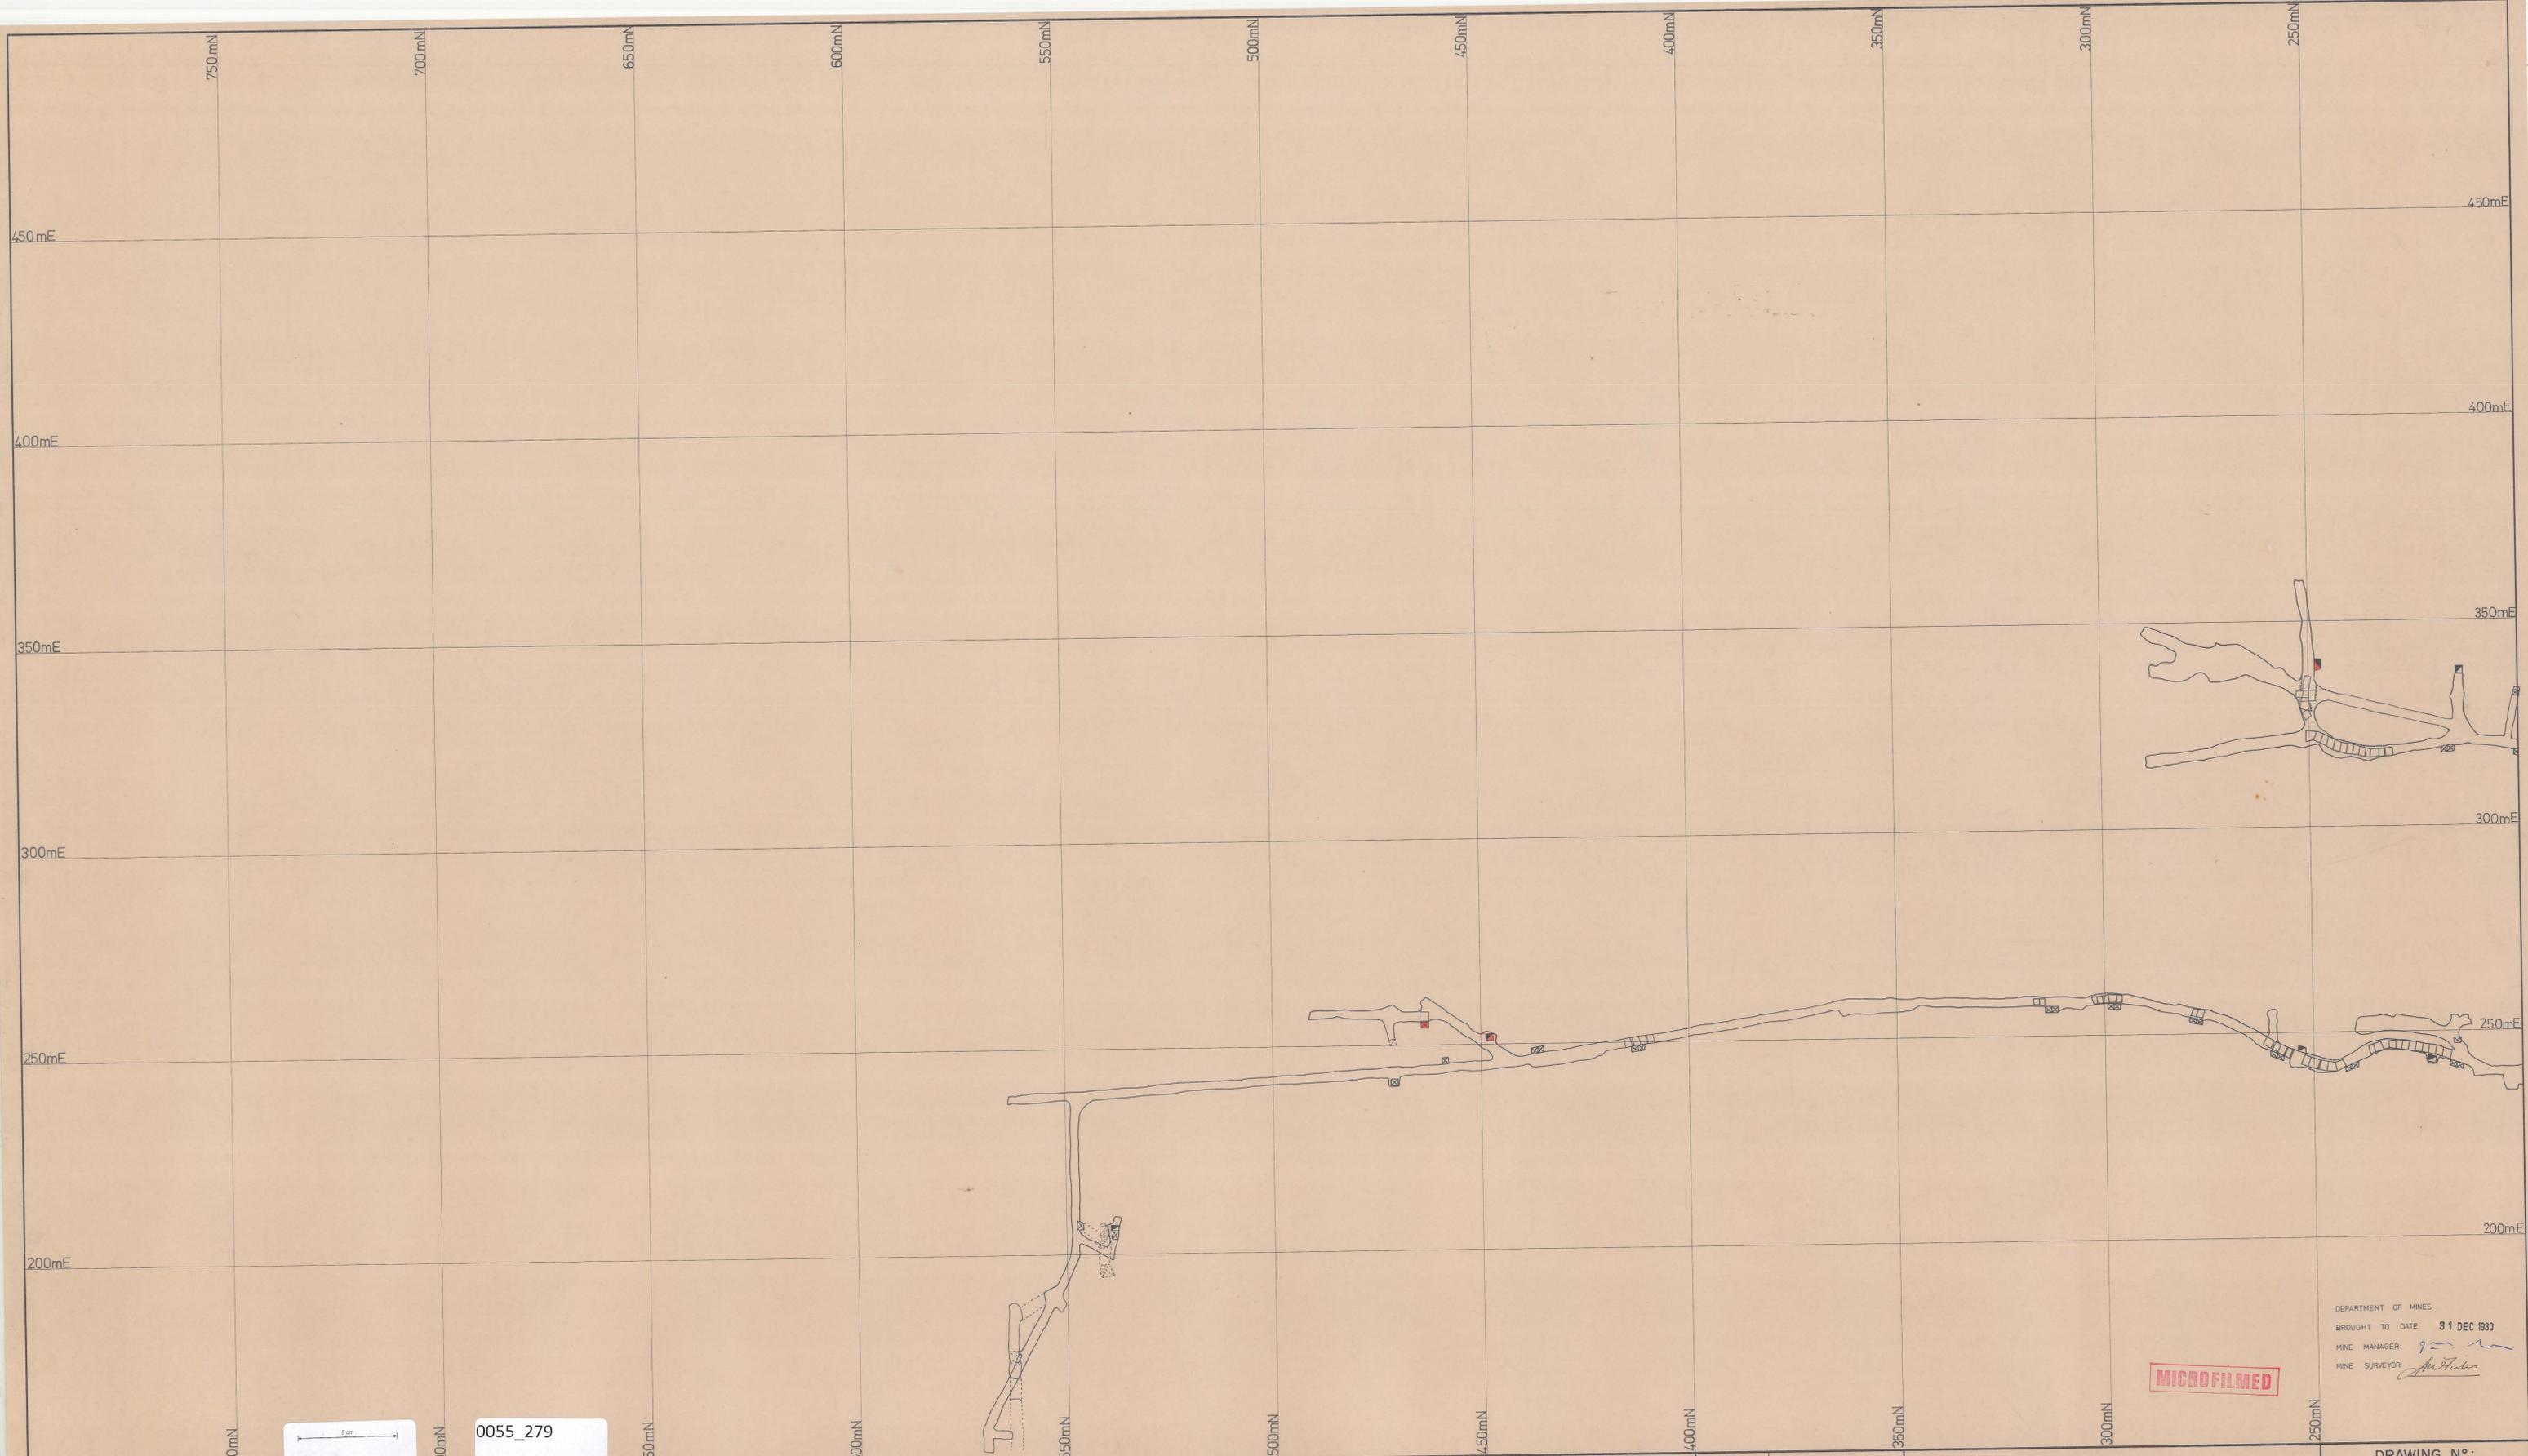

MICROFILMED

DEPARTMENT OF MINES
 BROUGHT TO DATE 31 DEC 1980
 MINE MANAGER *[Signature]*
 MINE SURVEYOR *[Signature]*

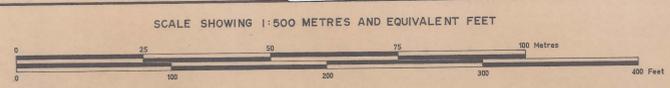

9m

0055_279

ELECTROLYTIC ZINC COMPANY OF AUSTRALASIA LIMITED
 WEST COAST MINES, TAS.

SURVEY BY		SCALE	1:500
DRAWN BY		DATE	1975
TRACED BY	I.T.M.	REFERENCE	

ROSEBERY MINE
 No 14 LEVEL ①

DRAWING NO.:

⑤	⑥
③	④
①	②

81362