


0055_280

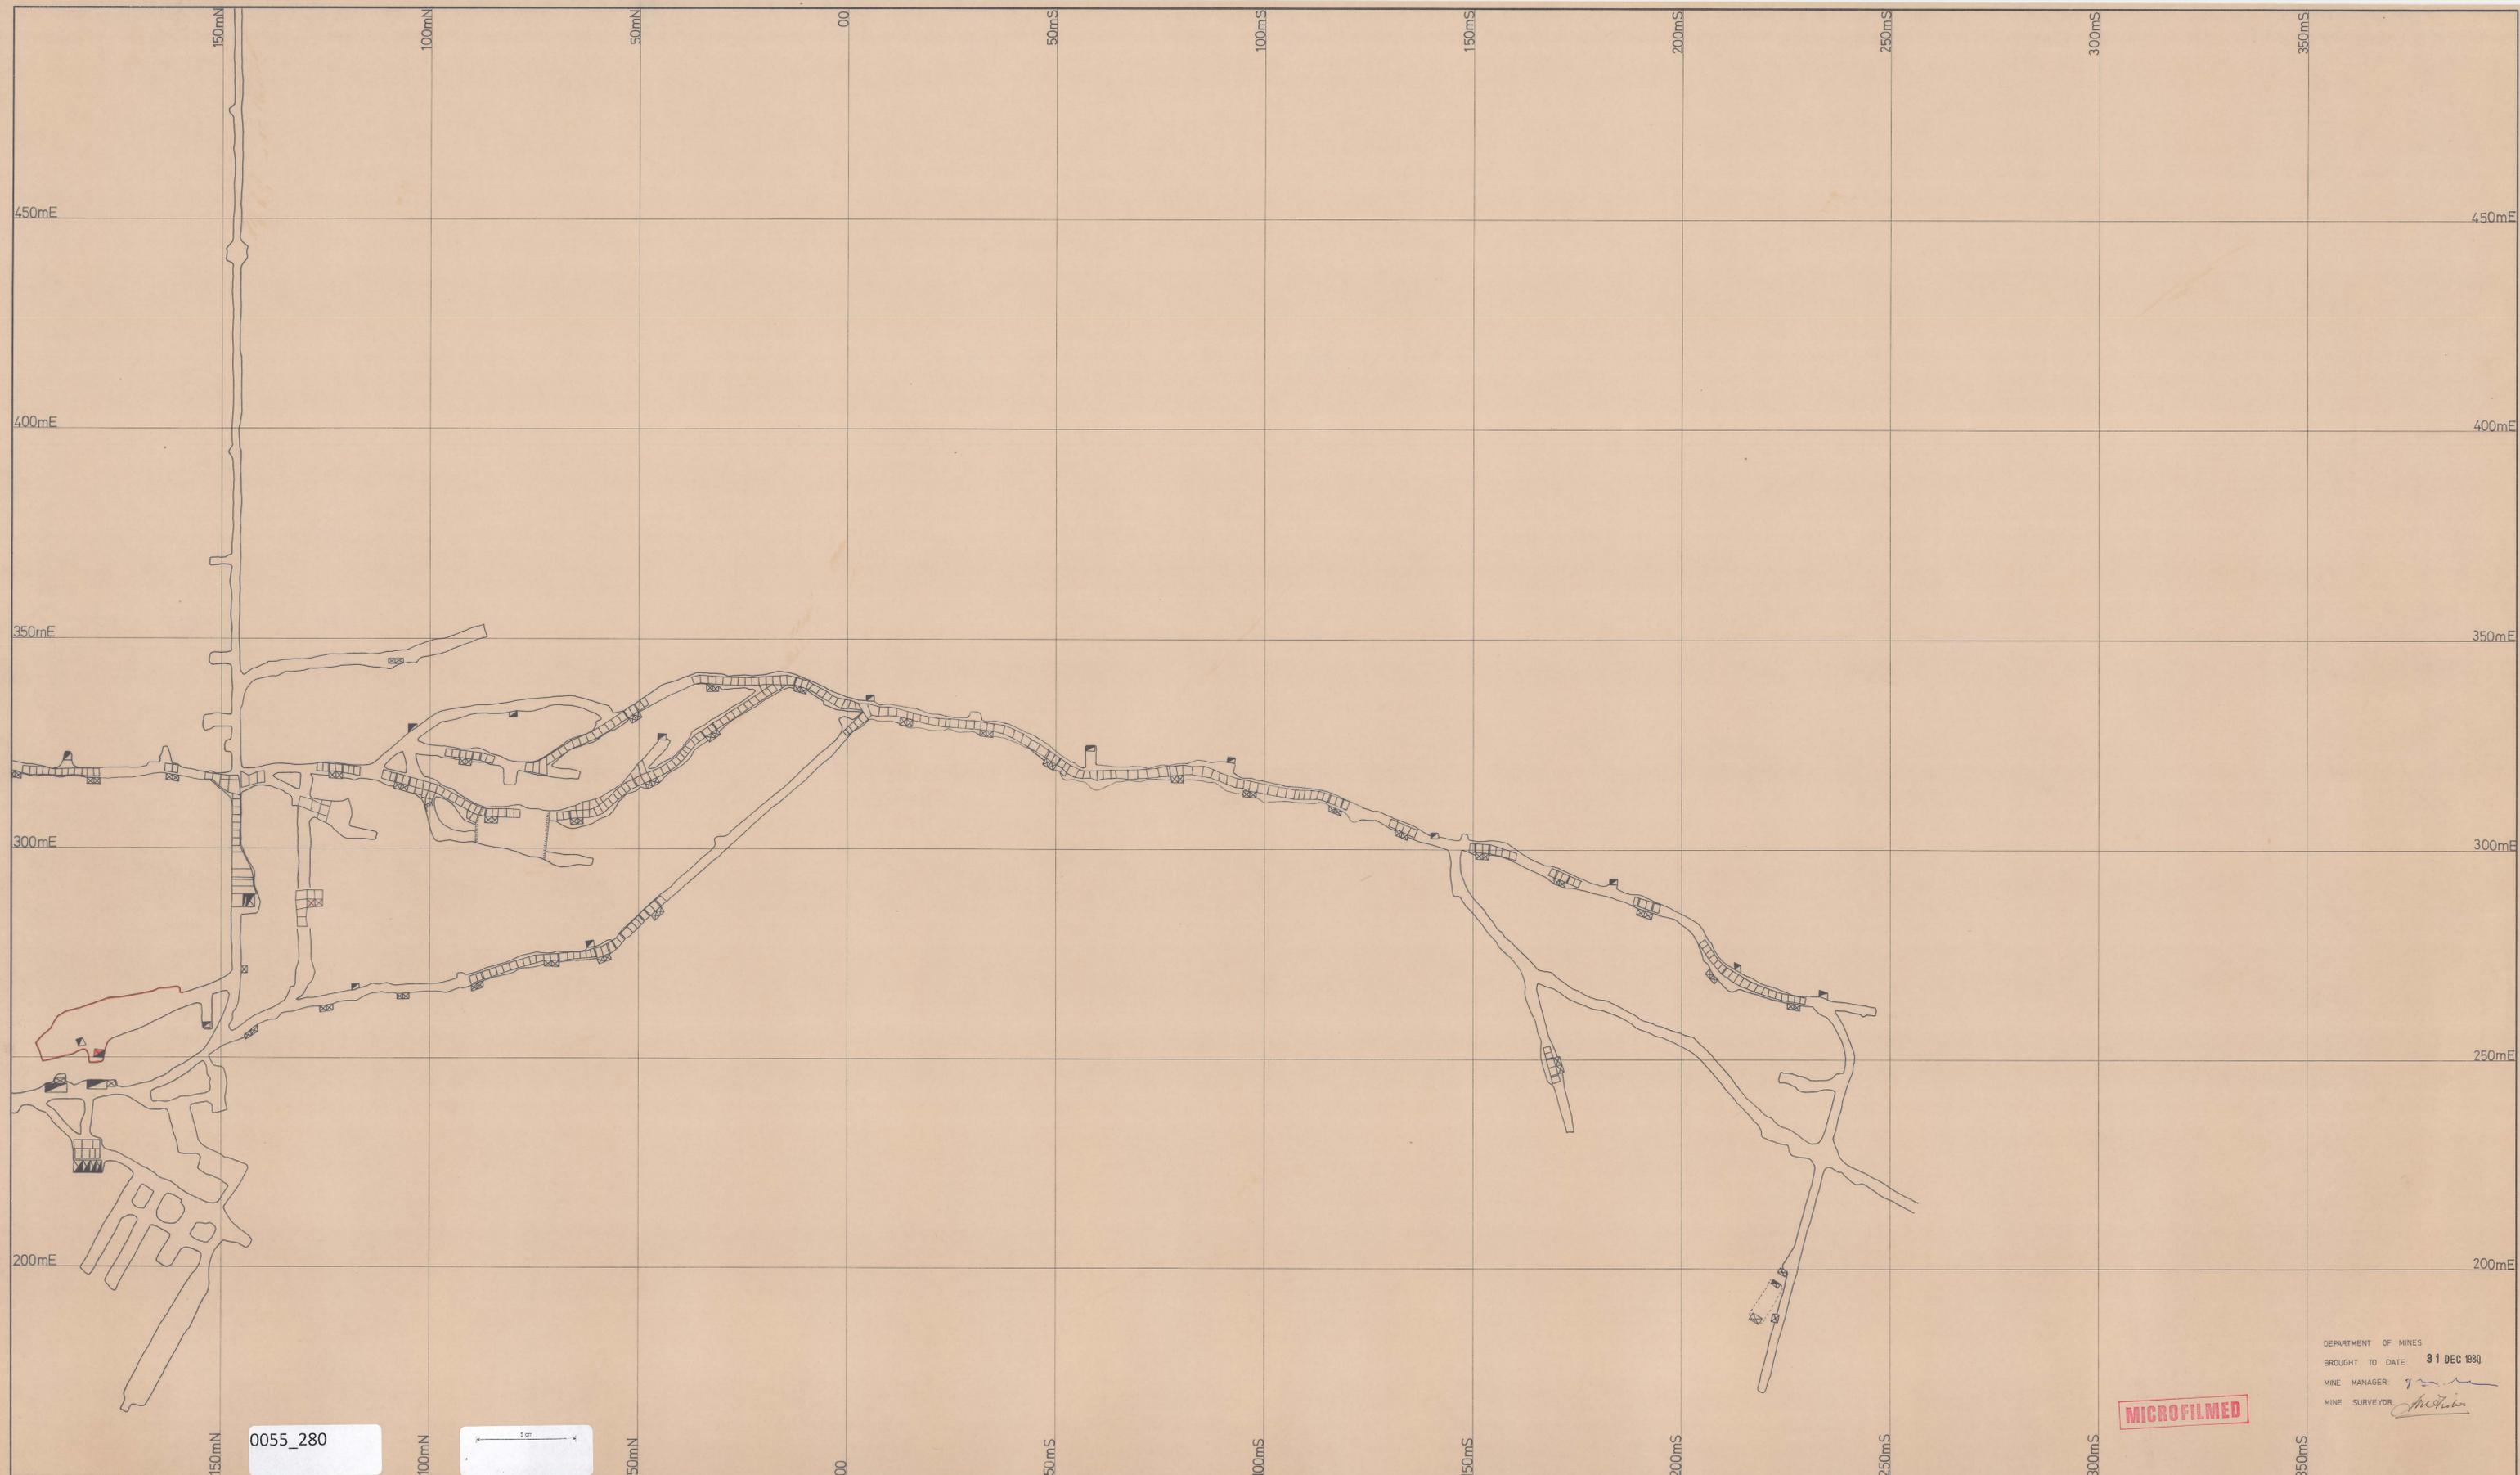


0055_280

5 cm

MICROFILMED

DEPARTMENT OF MINES
 BROUGHT TO DATE 31 DEC 1980
 MINE MANAGER *[Signature]*
 MINE SURVEYOR *[Signature]*

SCALE SHOWING 1:500 METRES AND EQUIVALENT FEET

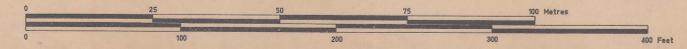

ELECTROLYTIC ZINC COMPANY OF AUSTRALASIA LIMITED
 WEST COAST MINES, T.A.S.

SURVEY BY		SCALE	1:500
DRAWN BY		DATE	1975
TRACED BY	I.T.M.	REFERENCE	

ROSEBERY MINE
 No 14 LEVEL (2)

DRAWING N^o:

5	6
3	4
1	2

81363