


0055\_283

0055\_283

**MICROFILMED**

DEPARTMENT OF MINES  
 BROUGHT TO DATE 131 DEC 1978  
 MINE MANAGER *A.W. ...*  
 MINE SURVEYOR *J. ...*

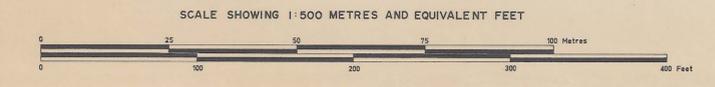

**ELECTROLYTIC ZINC COMPANY OF AUSTRALASIA LIMITED**  
 WEST COAST MINES, T.A.S.

SURVEY BY		SCALE	1:500
DRAWN BY		DATE	1975
TRACED BY	I.T.M.	REFERENCE	

ROSEBERY MINE  
 N<sup>o</sup> 14 LEVEL (1)

79015

DRAWING N<sup>o</sup> :

3	5	6
1	4	
2		