


5 m

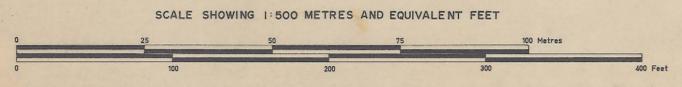

ELECTROLYTIC ZINC COMPANY OF AUSTRALASIA LIMITED
WEST COAST MINES, T.A.S.

SURVEY BY		SCALE	1 : 500
DRAWN BY		DATE	1975
TRACED BY	I.T.M.	REFERENCE	

ROSEBERY MINE
No 13 LEVEL ①

MICRO FILMED

0055_285

79013

DEPARTMENT OF MINES
BROUGHT TO DATE 31 DEC 1978
MINE MANAGER *Abraham*
MINE SURVEYOR *[Signature]*

DRAWING No: ① ②

0055_285