


5 cm

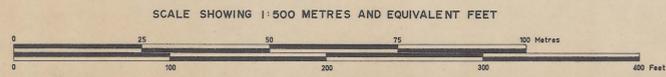

**ELECTROLYTIC ZINC COMPANY OF AUSTRALASIA LIMITED**  
WEST COAST MINES, T.A.S.

SURVEY BY		SCALE	1 : 500
DRAWN BY		DATE	1975
TRACED BY	I.T.M.	REFERENCE	

ROSEBERY MINE  
Nº 11 LEVEL (1)

0055\_288

**MICRO FILMED**

DEPARTMENT OF MINES  
BROUGHT TO DATE: 81 DEC 1978  
MINE MANAGER: *William*  
MINE SURVEYOR: *J. C. ...*

79010

DRAWING Nº:

0055\_288