


MICRO FILMED

DEPARTMENT OF MINES
 BROUGHT TO DATE 31 DEC 1978
 MINE MANAGER *[Signature]*
 MINE SURVEYOR *[Signature]*

0055_289

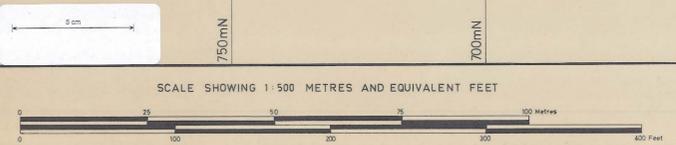

ELECTROLYTIC ZINC COMPANY OF AUSTRALASIA LIMITED
 WEST COAST MINES, TAS.

| | | | |
|-----------|--|-----------|-------|
| SURVEY BY | | SCALE | 1 500 |
| DRAWN BY | | DATE | 1976 |
| TRACED BY | | REFERENCE | |

ROSEBERRY MINE
 N° 8 LEVEL ④

19009

DRAWING N°

| | | |
|---|---|---|
| ① | ② | ③ |
| | ④ | |

0055_289