


DEPARTMENT OF MINES  
 BROUGHT TO DATE 31 DEC 1979  
 MINE MANAGER *M.H. ...*  
 MINE SURVEYOR *J.R. ...*

0055\_292

MICROFILMED

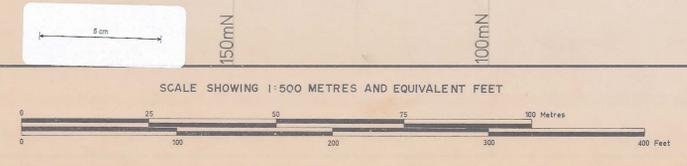

ELECTROLYTIC ZINC COMPANY OF AUSTRALASIA LIMITED  
 WEST COAST MINES, T.A.S.

SURVEY BY		SCALE	1:500
DRAWN BY		DATE	1975
TRACED BY	RJR	REFERENCE	

ROSEBERY MINE  
 No 17 LEVEL (1)

DRAWING No: 1

21331