


0055_293

DEPARTMENT OF MINES
 BROUGHT TO DATE 31 DEC 1979
 MINE MANAGER *A. B. Hammett*
 MINE SURVEYOR *A. B. Hammett*

0055_293

MICROFILMED

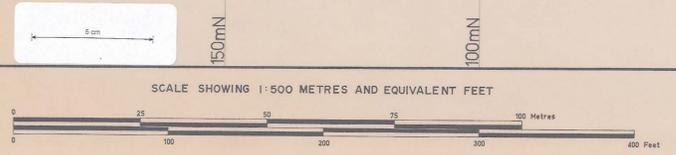

ELECTROLYTIC ZINC COMPANY OF AUSTRALASIA LIMITED
 WEST COAST MINES, T.A.S.

SURVEY BY		SCALE	1:500
DRAWN BY		DATE	1975
TRACED BY	I.T.M.	REFERENCE	

ROSEBERY MINE
 No 16 LEVEL (3)

DRAWING No: 1 2 3
 8/330