



0055\_295

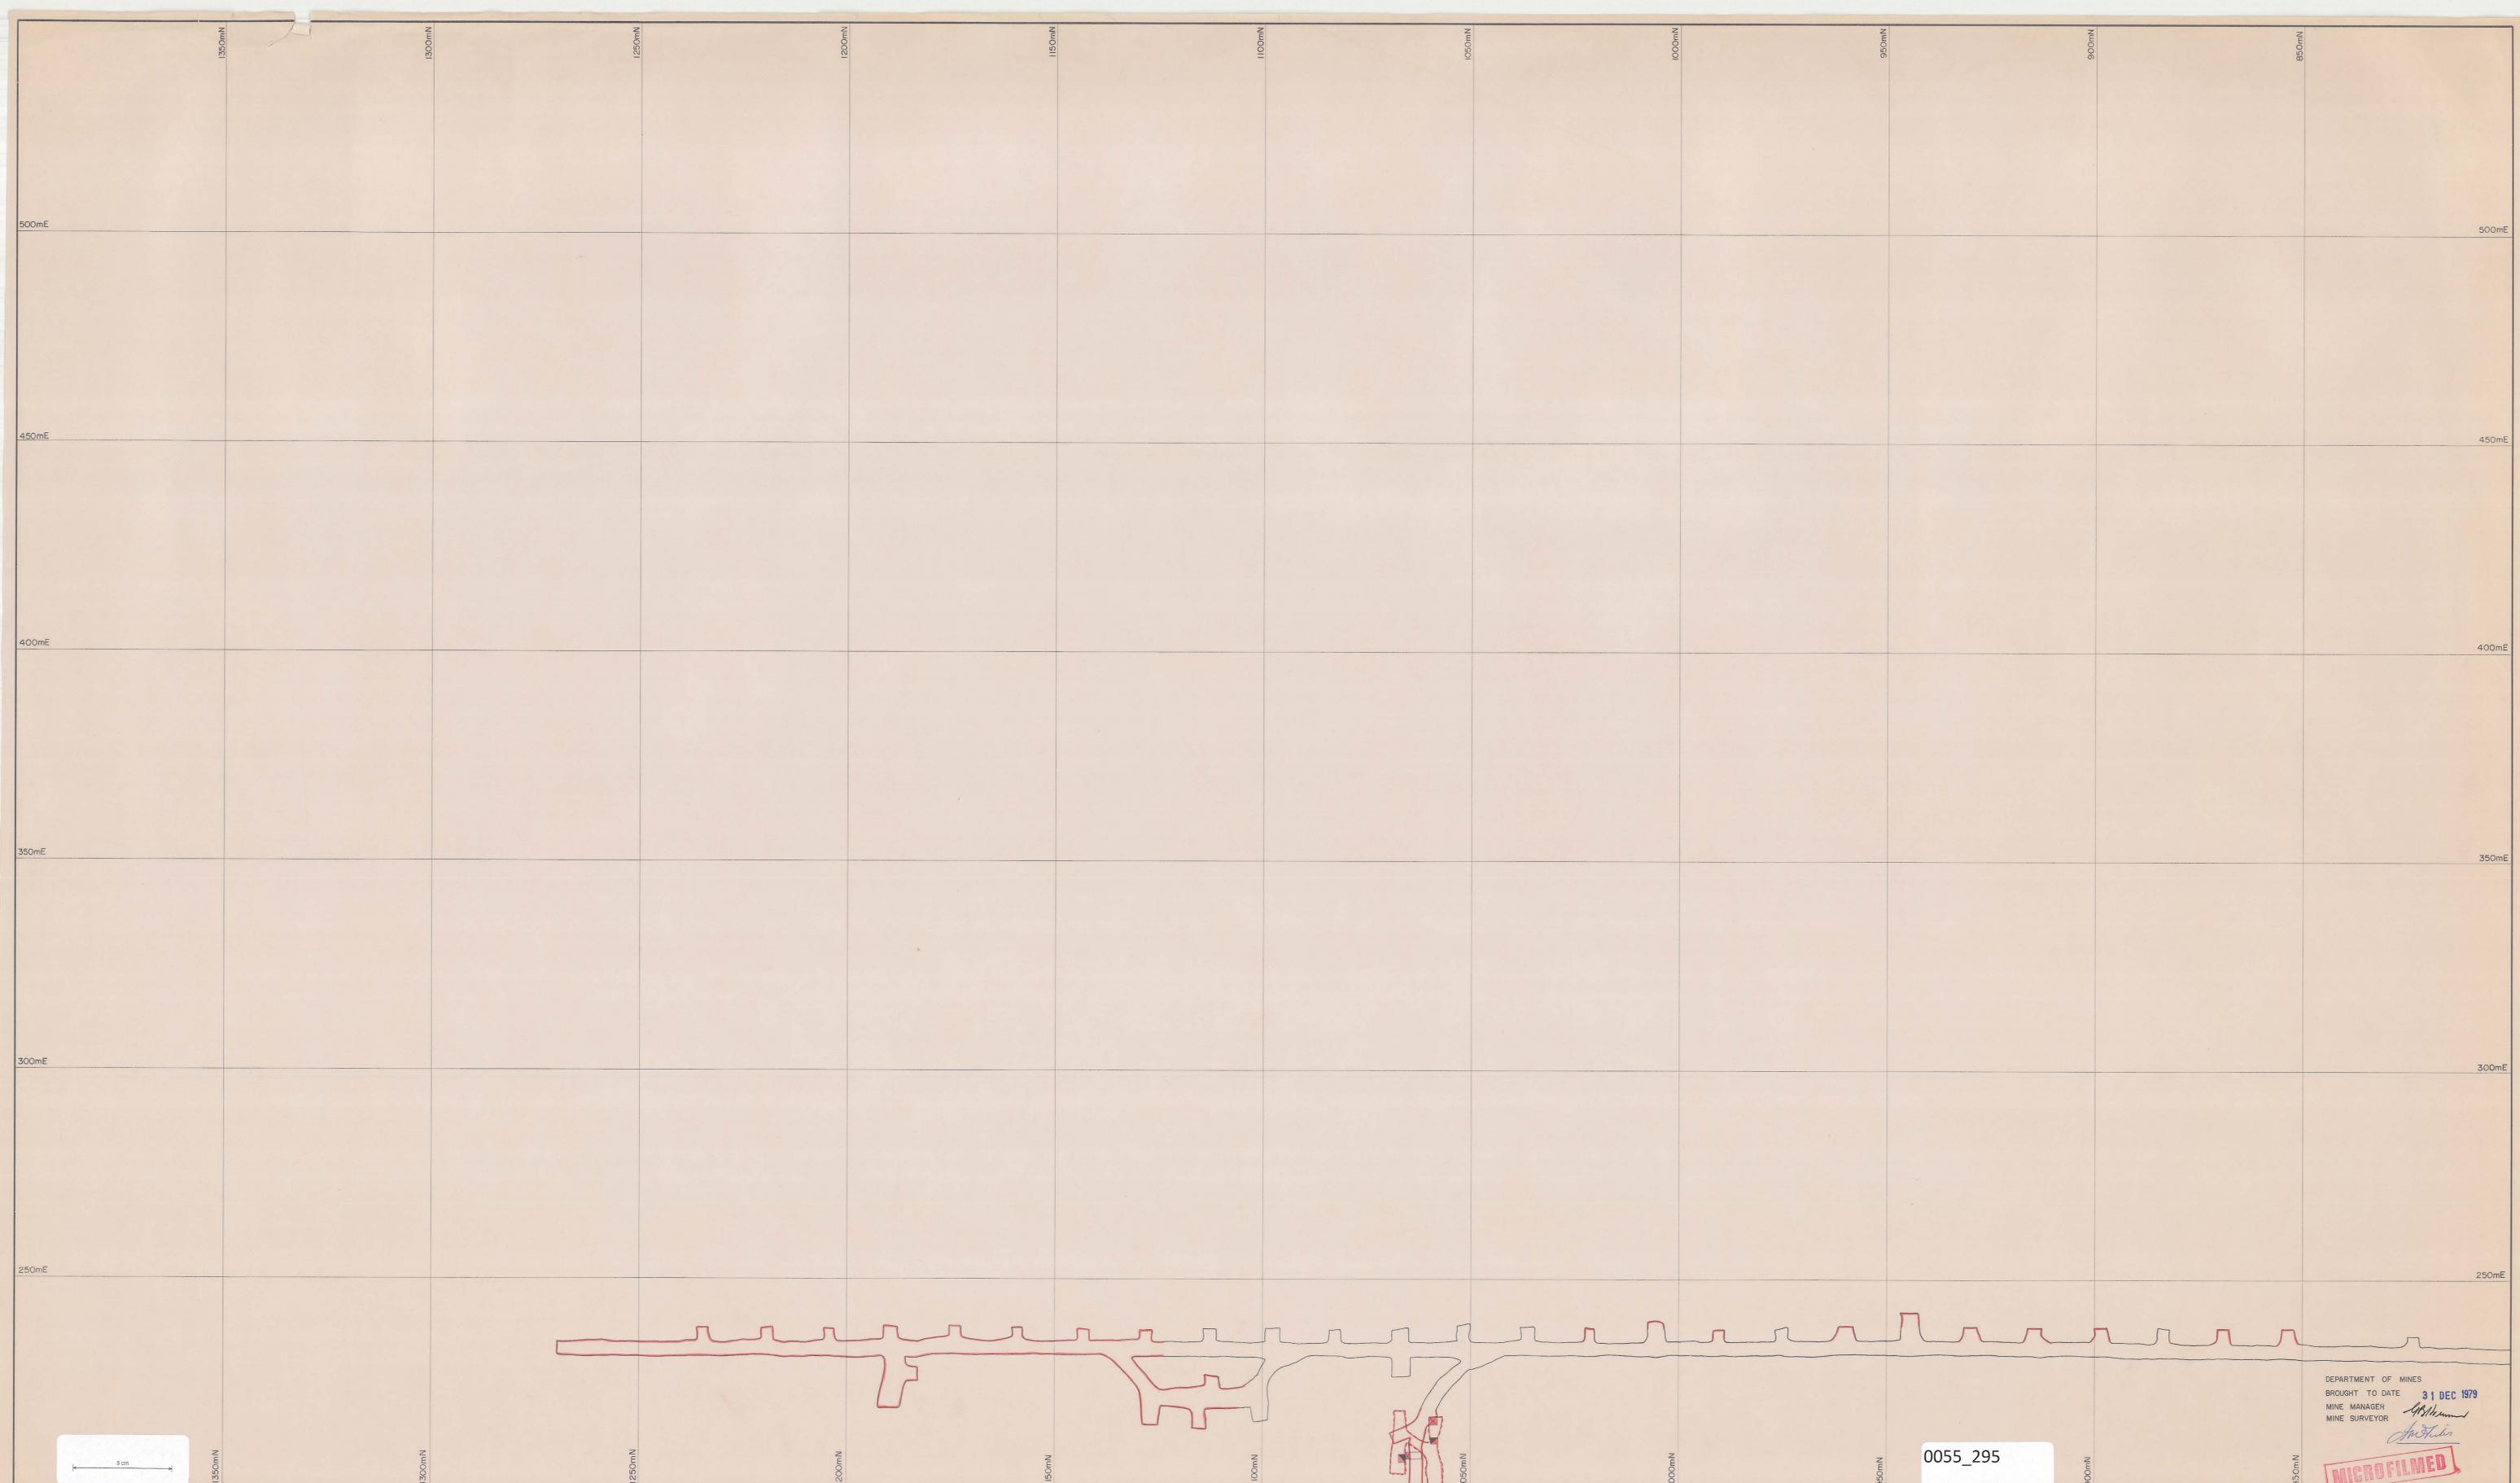

5 cm

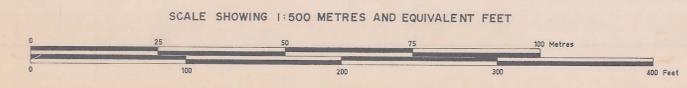

**ELECTROLYTIC ZINC COMPANY OF AUSTRALASIA LIMITED**  
WEST COAST MINES, T.A.S.

|           |  |           |  |
|-----------|--|-----------|--|
| SURVEY BY |  | SCALE     |  |
| DRAWN BY  |  | DATE      |  |
| TRACED BY |  | REFERENCE |  |

0055\_295

ROSEBERY MINE  
N° 15 LEVEL (4)

DEPARTMENT OF MINES  
BROUGHT TO DATE 31 DEC 1979  
MINE MANAGER *[Signature]*  
MINE SURVEYOR *[Signature]*

**MICROFILMED**

DRAWING N°:

|   |   |   |
|---|---|---|
| ① | ② | ③ |
| ④ | ⑤ |   |

87326