


0055\_297

0055\_297

BROUGHT TO DATE **31 DEC 1979**  
 MINE MANAGER *[Signature]*  
 MINE SURVEYOR *[Signature]*

**MICROFILMED**

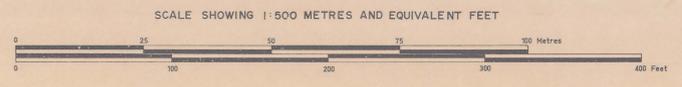

**ELECTROLYTIC ZINC COMPANY OF AUSTRALASIA LIMITED**  
 WEST COAST MINES, T.A.S.

SURVEY BY		SCALE	1 : 500
DRAWN BY		DATE	1973
TRACED BY	P. J. Lowe	REFERENCE	

ROSEBERY MINE  
 LONGITUDINAL PROJECTION  
 SPECIFIC STOPES.

DRAWING N<sup>o</sup>:  
 DEPARTMENT OF MINES  
 S/29