


0055\_300

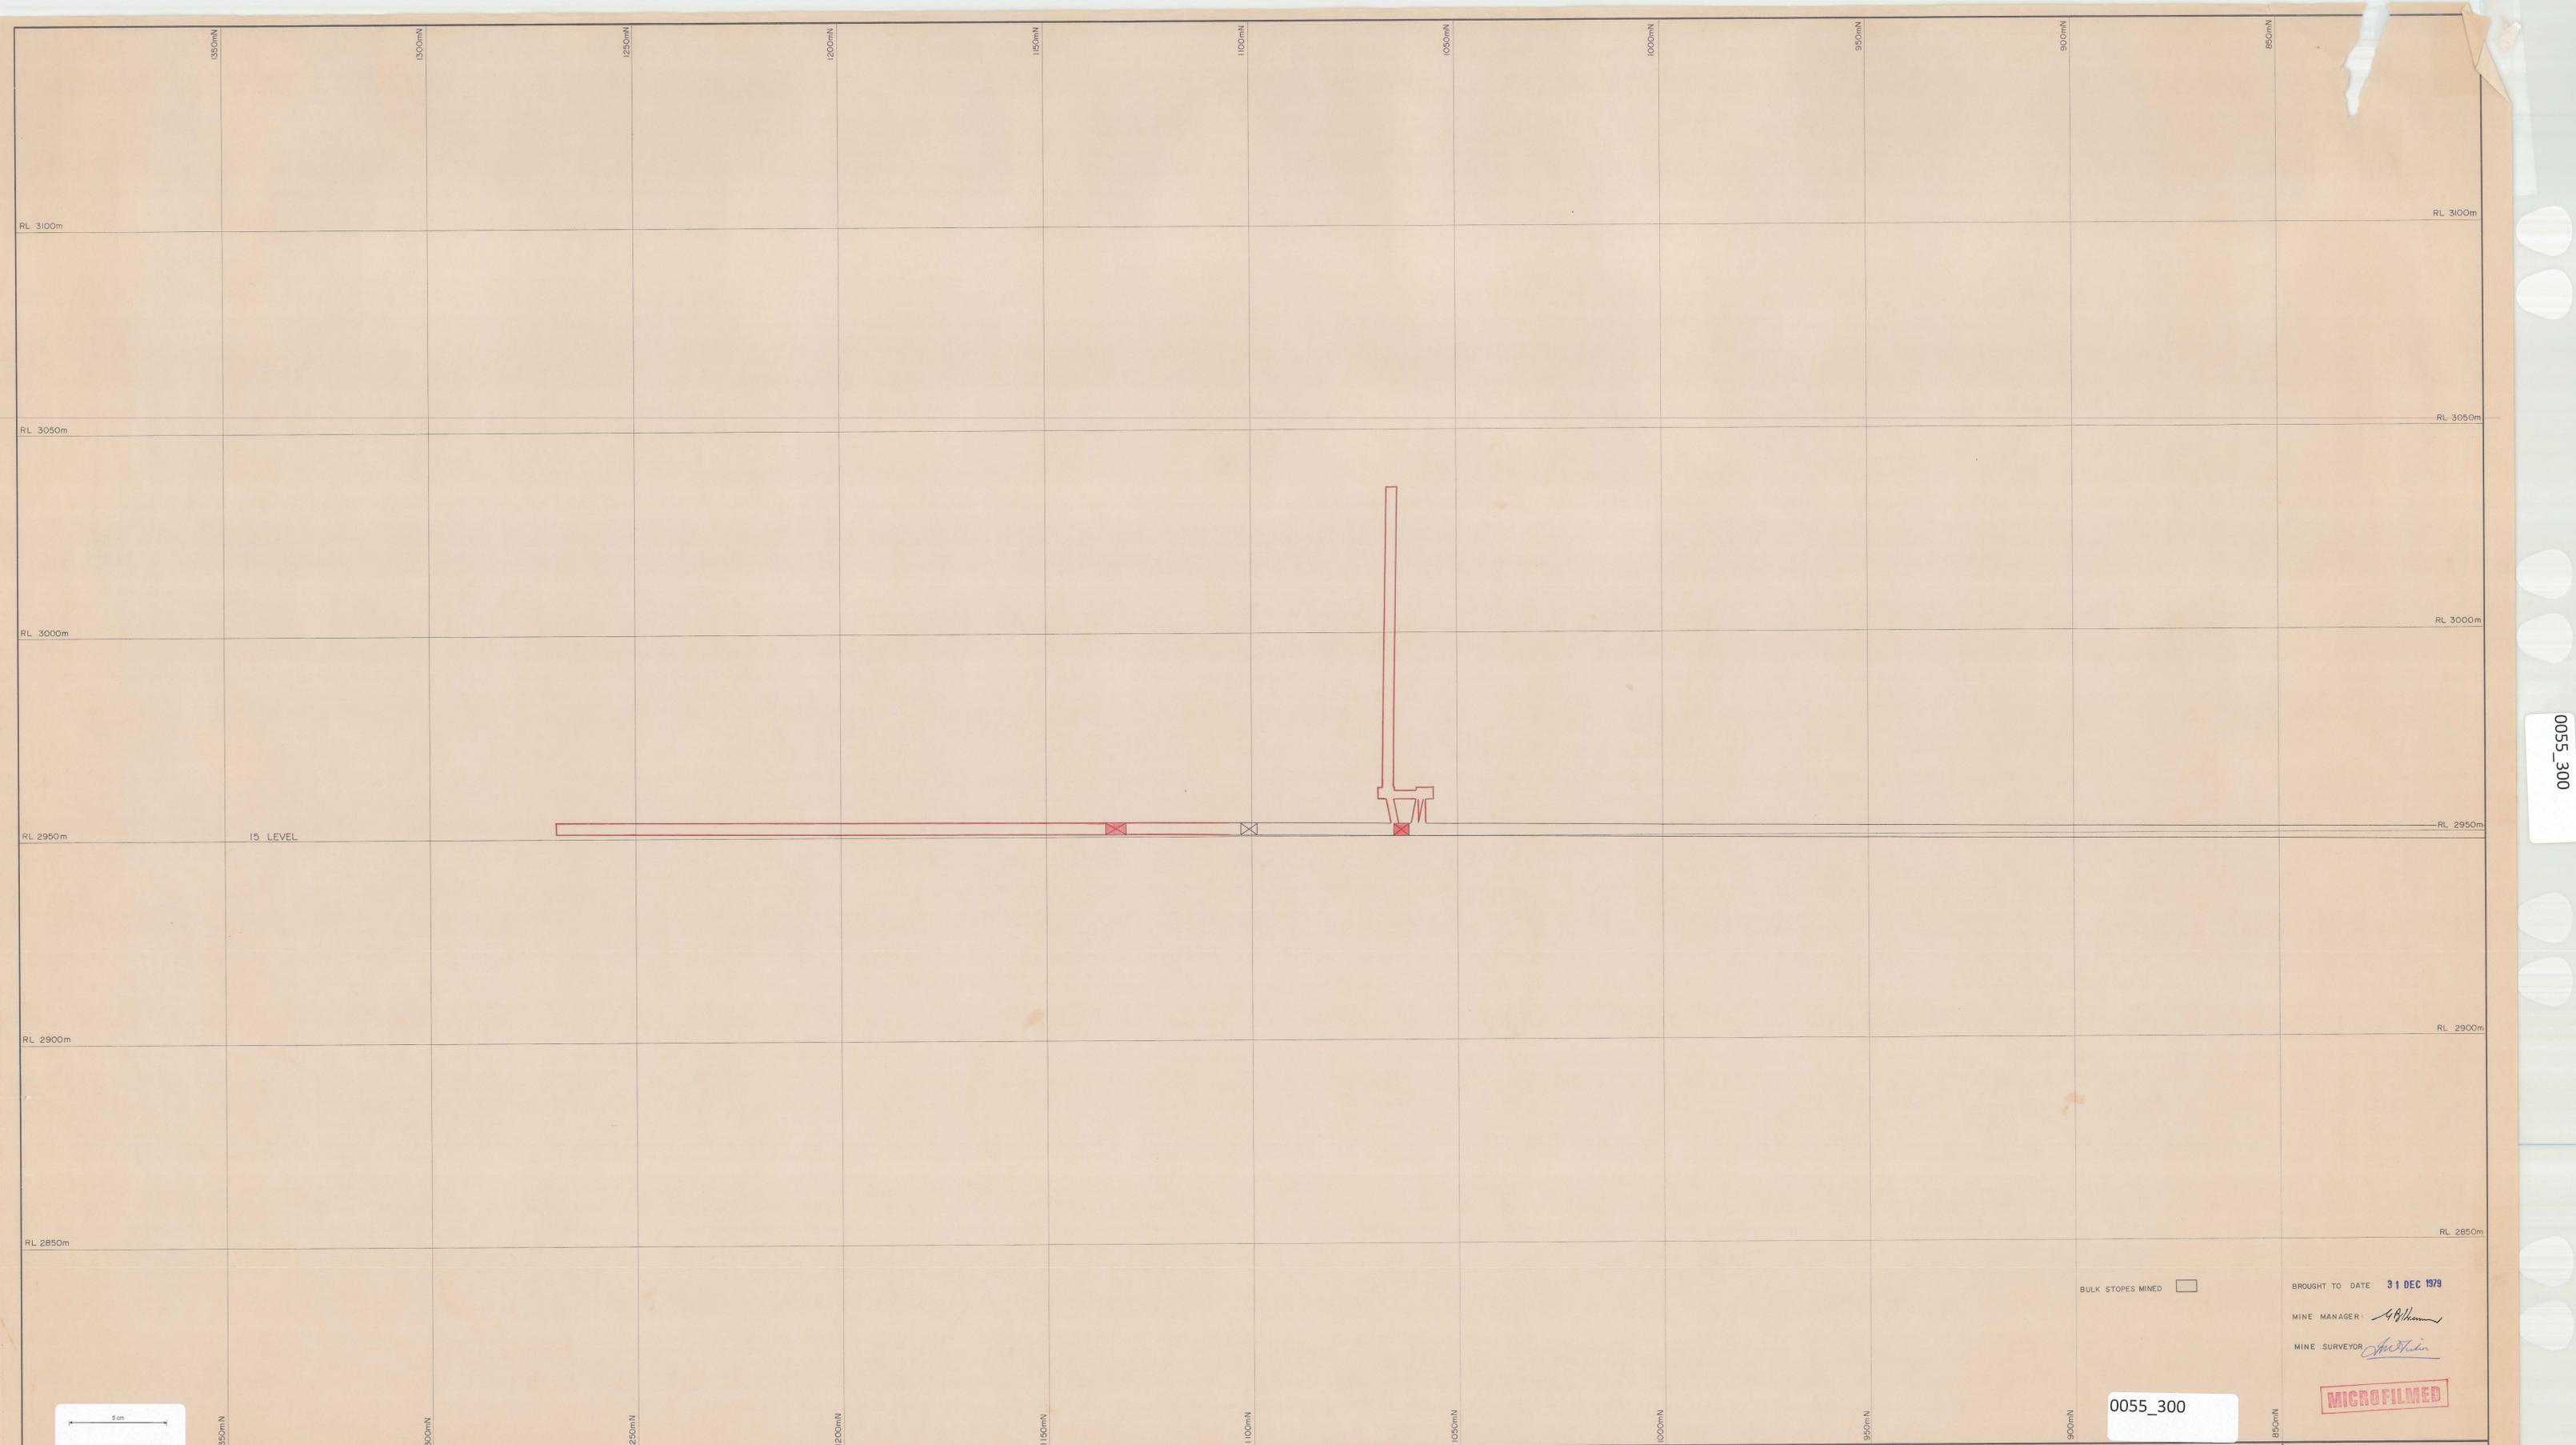


0055\_300

BULK STOPES MINED

BROUGHT TO DATE 31 DEC 1979  
 MINE MANAGER: *A. G. Morrison*  
 MINE SURVEYOR: *A. G. Morrison*

MICROFILMED

5 cm

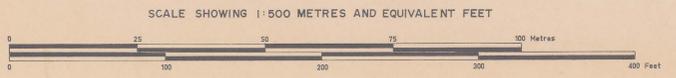

ELECTROLYTIC ZINC COMPANY OF AUSTRALASIA LIMITED  
 WEST COAST MINES, T.A.S.

SURVEY BY		SCALE	1:500
DRAWN BY	A. G. MORRISON	DATE	19 01 79
TRACED BY	A. G. M.	REFERENCE	

ROSEBURY MINE  
 LONGITUDINAL PROJECTION  
 800mN-1400mN - BELOW 10/L

DRAWING NO.:  
 DEPARTMENT OF MINES  
 8/506